


K SECTION
1:50

SGAD-K001,
SGAD-K002,
SGAD-K003

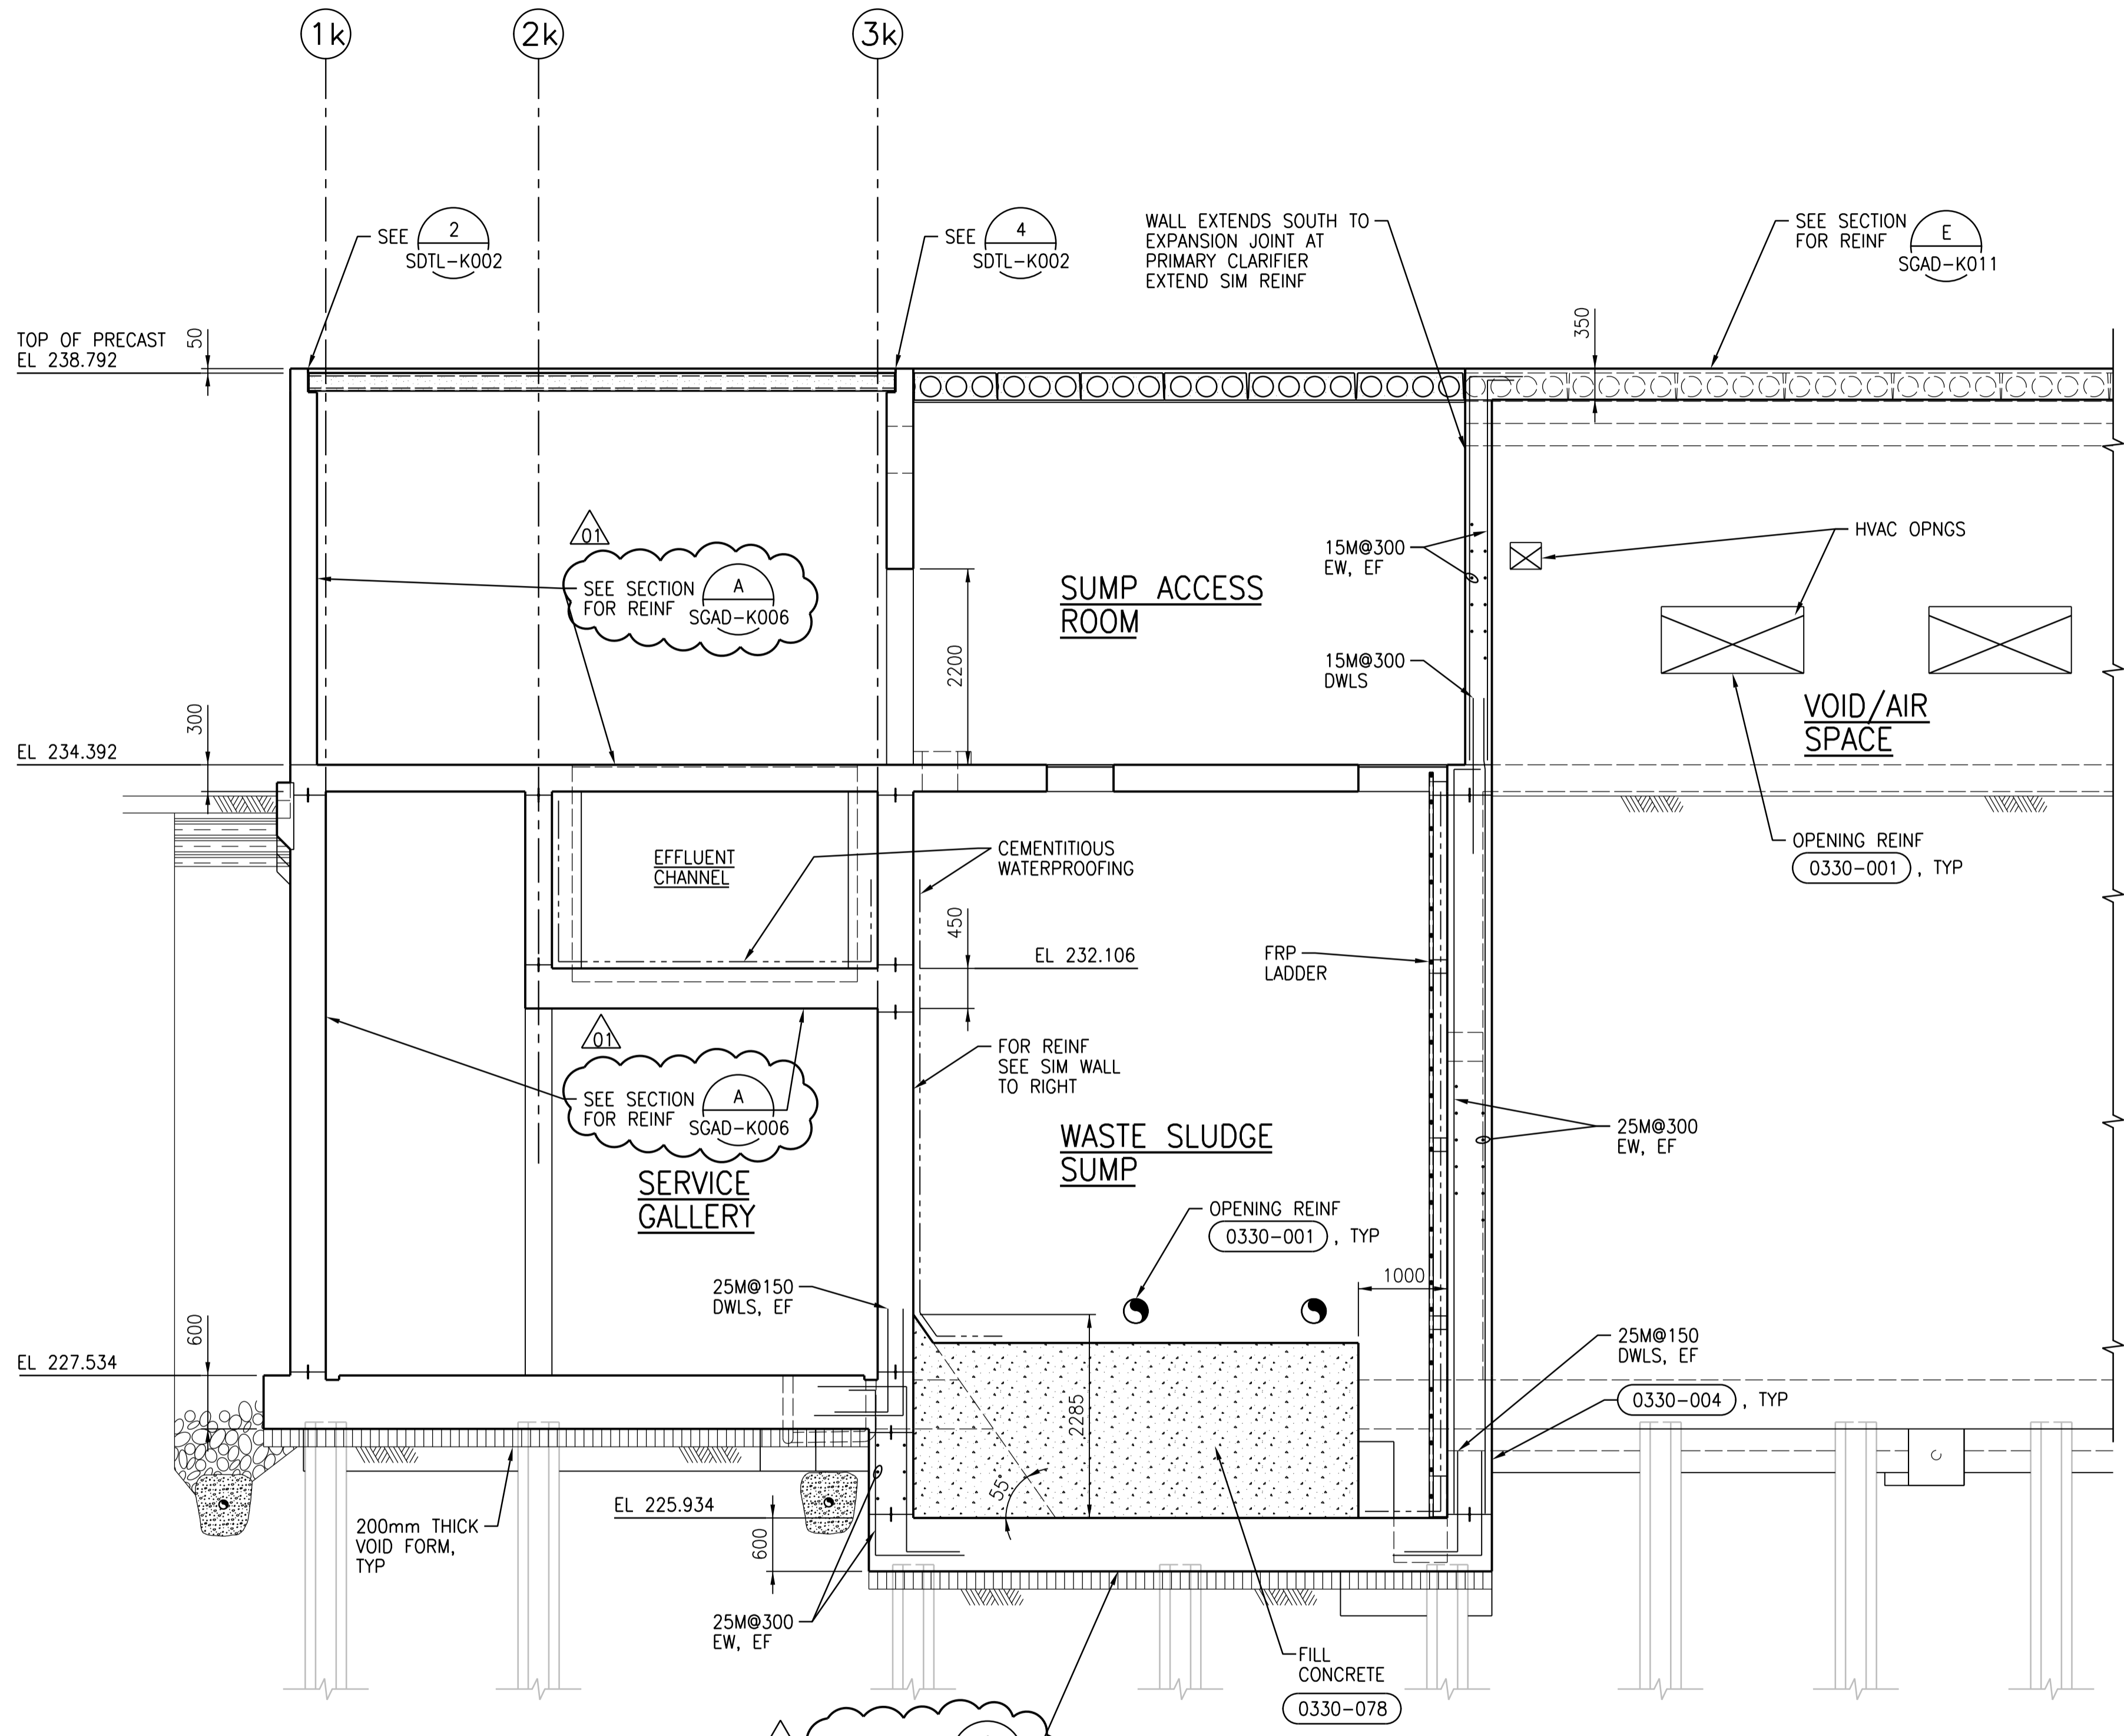

L SECTION
1:50

SGAD-K001,
SGAD-K002,
SGAD-K003,
SGAD-K004



NO.	REVISIONS	DATE	DESIGN	CHECK
01	ISSUED FOR ADDENDUM NO. 3	09/2015	C.R.	J.C.
00	ISSUED FOR TENDER	08/2015	G.O.	J.C.

CH2MHILL		KCS GROUP	
SNC-LAVALIN		ENGINEER	
DESIGNED BY: E. LUI	CHECKED BY: R. PARIKH	ENGINEER'S SEAL	
DRAWN BY: G. OMORI	APPROVED BY: E. LUI		
SCALE: 1:50	ISSUED FOR CONSTRUCTION BY: T. TURZAK		
DATE: 2015/08/13		DATE: 2015/08/13	
CONSULTANT NO.: 474248			



THE CITY OF WINNIPEG
Winnipeg WATER AND WASTE DEPARTMENT

SOUTH END WATER POLLUTION CONTROL CENTRE
SEWPC UPGRADING/EXPANSION PROJECT
STRUCTURAL
HIGH RATE CLARIFICATION BUILDING
SECTIONS K AND L

CITY DRAWING NUMBER: 1-0102-SGAD-K015 SHEET: 01 SIZE: A1