

GENERAL NOTES

CONC. STRENGTH 2500 P.S.I. @ 28 DAYS FOR PILES.

CONC. STRENGTH 3000 P.S.I. @ 28 DAYS FOR BEAMS & SLABS.

AGGREGATE SIZE: 3/4" MAX.

SLUMP: 3" MAX.

REINFORCING STEEL TO BE INTERMEDIATE GRADE 20,000 P.S.I., DETAILED IN ACCORDANCE WITH NBC, 1950

USE SULPHATE RESISTANT CEMENT FOR PILES

ALL STRUCTURAL STEEL MEMBERS ASTM - A36.

FRAME ALL ROOF OPENINGS WITH 3E-41 3E-41 TO BE SUPPLIED BY ST. JOISTS TRADE FOR ROOF OPENINGS SEE ALSO MECH. DRAWINGS.

STEEL BEAMS, COLS., B'S, ETC. TO BE SUPPLIED BY STRUCTURAL STEEL TRADE EXCEPT AS OTHERWISE NOTED.

BACK FILL: REMOVE ALL TOP SOIL & BACK FILL WITH WELL GRADED GRANULAR FILL, COMPACT EACH 6" LAYER AS IT IS PLACED.



FOR DETAIL OF PARTITION WALL, SEE SPEC.

ST. JOIST BRIDGING TO COMPLY WITH NBC 1950. 3 LINES MIN.

FOR ADDITIONAL LOAD ON ST. JOISTS DUE TO HEATING UNITS, CHECK WITH GENERAL CONTRACTOR.

DIMENSIONS: 3/17/64

No.	PARTICULARS	DATE	BY
1			

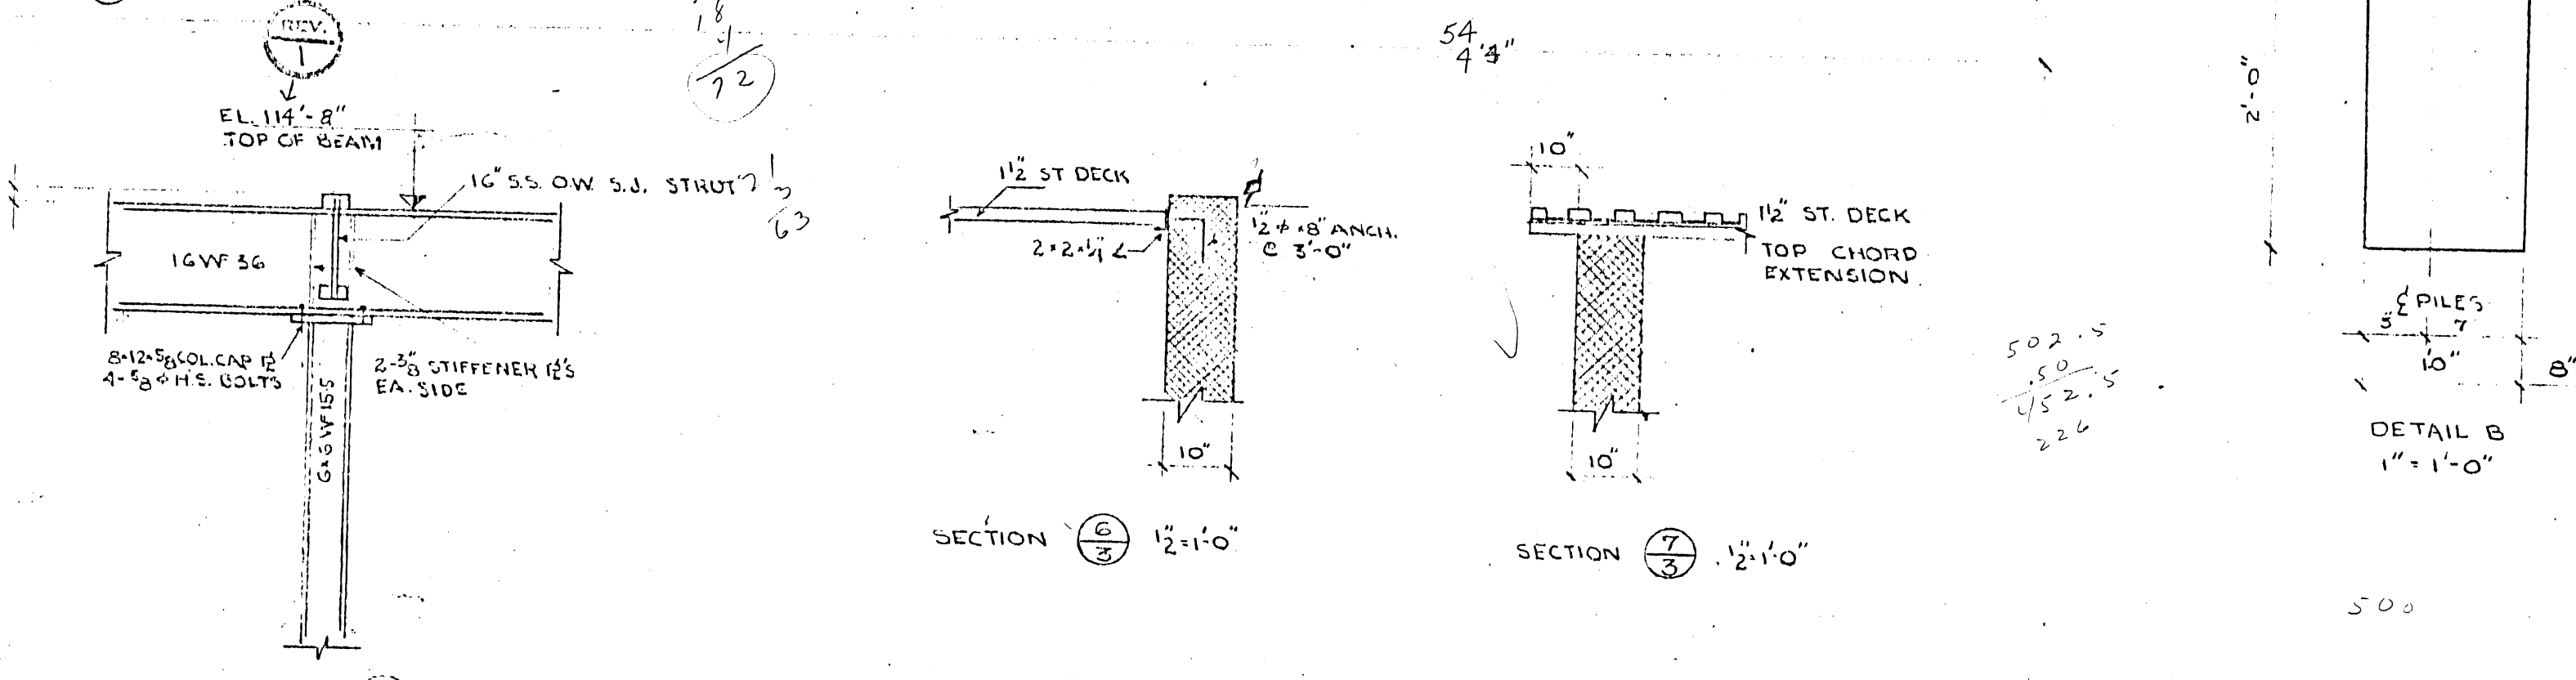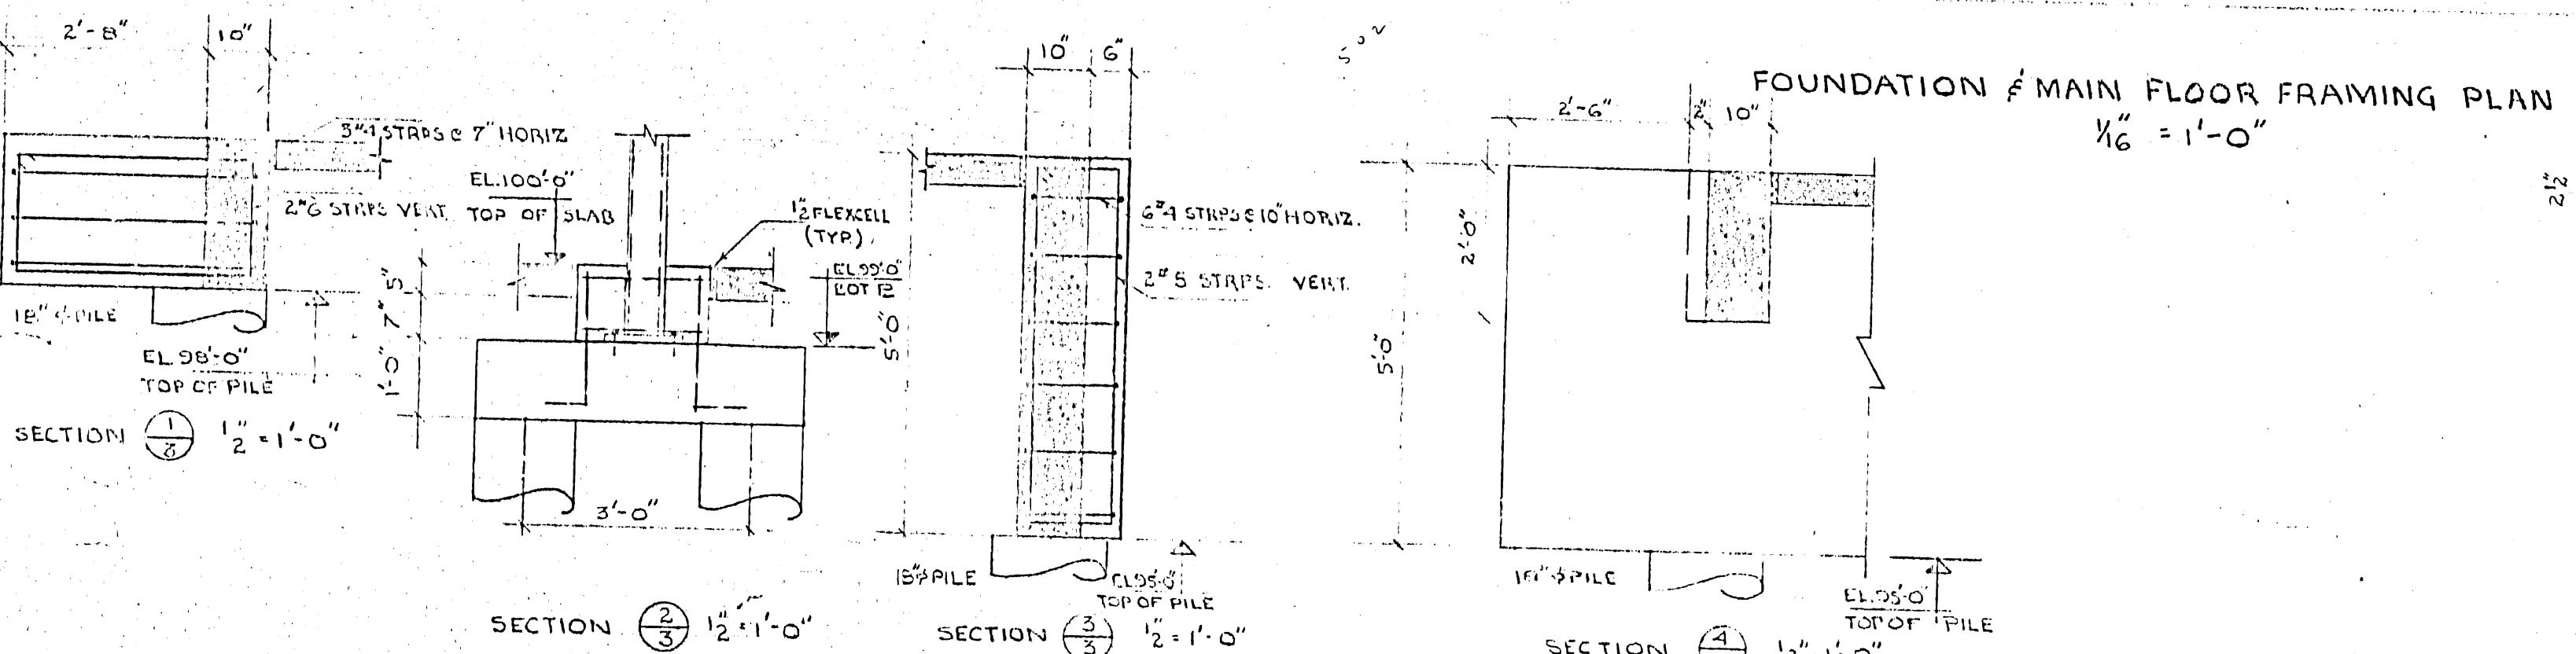

CHECKED FOR: DESIGN R.C. DETAILS STRUCTURE MECHANICAL ELECTRICAL

PRINTING DATE: []

DRAWN BY: []

PROVIDE OF MANITOBA LICENSING & REGISTRATION REGISTERED ARCHITECTS

Drawings and specifications, as instruments of service are the property of the architects, the copyright in the same being reserved to them, and when made, must bear their names. All prints to be returned. The contractor is to verify dimensions and data noted herein with conditions on the site and is held responsible for reporting any discrepancy to the architects for adjustment. This drawing is not to be used for building purposes until countersigned by:

L.M.A. LTD.
 LICENSING & REGISTRATION
 REGISTERED ARCHITECTS

ST. JAMES PLACE WAREHOUSE
 ST. JAMES MANITOBA.

TITLE: FOUNDATION, MAIN FLOOR AND ROOF FRAMING PLAN & DETAILS
 SHEET NO. 645 - A - 2