


1 FLOOR PATTERN PLAN

Scale 1:50

FLOOR PATTERN REFERENCE NOTES:

- 1 PROVIDE A TRANSITION STRIP WHERE TWO DISPARATE MATERIALS MEET.
- 2 PROVIDE CONTRAST HEAT WELD.
- 3 PROVIDE HEAT WELD ROD IN COLOUR TO MATCH SHEET FLOORING.
- 4 ALIGN RESILIENT SHEET FLOORING PATTERN WITH TEXTILE COMPOSITE FLOORING(TCF) PATTERN.
- 5 EXTEND CTF AND RSF BELOW CONVECTION UNITS.
- 6 PROVIDE RESILIENT WALL BASE BELOW CONVECTION UNITS.
- 7 TRANSITION FLOORING AT MIDPOINT OF PONY WALL.

LEGEND:

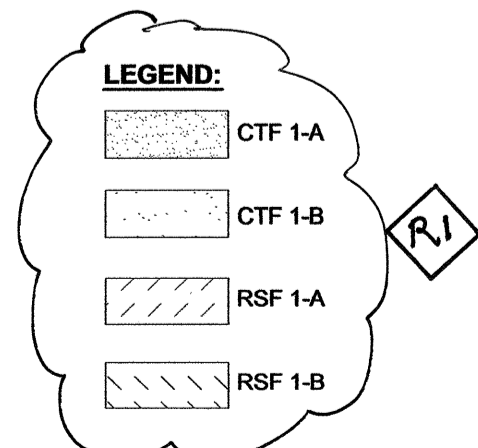

2 FURNITURE PLAN

Scale 1:50

FURNITURE PLAN GENERAL NOTES:

1. SIZE PEDESTAL DEPTH TO SUIT DEPTH OF WORK SURFACE.
2. REFER TO FURNITURE PLANS FOR ORIENTATION OF WORKSTATIONS.
3. LEAVE 150MM FROM FACE OF CONVECTION UNIT TO DESK TYPICAL.
4. LEVELLERS ON FURNITURE AND PANELS TO ACCOMMODATE FLOOR DISCREPANCIES OF UP TO 75 MM.
5. GENERAL CONTRACTOR TO PROVIDE CONTINUOUS BLOCKING TO WALL WHERE OVERHEAD STORAGE IS SCHEDULED TO BE INSTALLED.

FURNITURE DESCRIPTION:

- C-1: ERGONOMIC TASK CHAIR.
- C-2: VISITOR CHAIR.
- WS-1 WORK STATION: FREESTANDING 'L' SHAPE DESKS.
- PN: PANELS.
- 3H: 3 HIGH LATERAL FILE.
- 4H: 4 HIGH LATERAL FILE.
- T: MEETING TABLE.
- KBT: FULLY ARTICULATED KEYBOARD TRAY.
- SC: STORAGE CABINET.

3 PANEL LAYOUT PLAN

Scale 1:50

PANEL LAYOUT PLAN GENERAL NOTES:

1. DIMENSIONS TAKEN FROM FACE OF GWB TO FACE OF PANEL.
2. PROVIDE WALL START AT EACH LOCATION WHERE PANEL ABUTS WALL.
3. PANELS TO BE LEFT PLUMB, LEVEL AND SQUARE AT END OF INSTALLATION.

GENERAL NOTES:

1. GENERAL CONTRACTOR SHALL BE RESPONSIBLE FOR THE PROVISION OF FURNITURE THROUGH A QUALIFIED SUPPLIER OF FURNISHINGS.
2. SUBMIT WITH BID THE NAME OF SUPPLIER, LINE OF FURNITURE AND PANELS, AS WELL AS PAMPHLETS/BROCHURES TO ADEQUATELY CONVEY THE FUNCTION AND AESTHETIC PROPERTIES.
3. SELECTED FURNITURE SUPPLIERS WILL BE REQUIRED TO SUBMIT FULL SHOP DRAWINGS INCLUDING INSTALLATION PLANS AND FINISH SELECTORS.

LEGEND:


- BBF: BOX BOX FILE PEDESTAL
- CH: COAT HOOK
- EG: FULL END GABLE
- FF: FILE FILE PEDESTAL
- KBT: KEY BOARD TRAY
- 3H: 3 HIGH LATERAL FILE
- L: LOCK
- MFP: MULTI FUNCTION PRINTER
- NIC: NOT IN CONTRACT
- OH: OVERHEAD
- S: SHREDDER
- T: TABLE
- STC: STORAGE CABINET
- WS: PANEL WALL START
- 9151220: PANEL WIDTH AND HEIGHT
- 9151220GL: GL DENOTES GLASS PANEL

FURNITURE DIMENSIONS ARE IN MILLIMETERS

ISSUED FOR

ISSUED FOR CONSTRUCTION AUGUST 24, 2015

SEAL

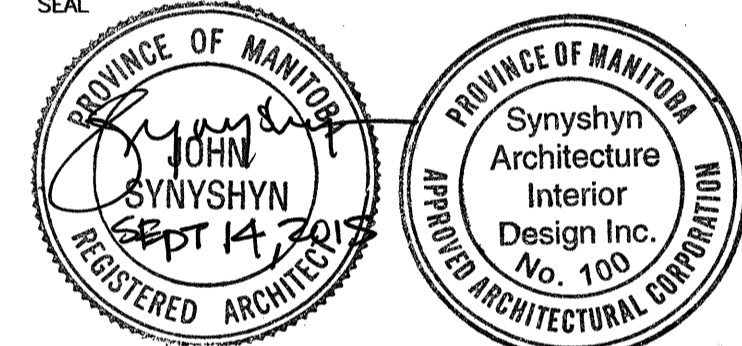

ARCHITECT / PRIME CONSULTANT

SYNYSHYN
 ARCHITECTURE + INTERIOR DESIGN INC.

MANITOBA • ALBERTA
 T: 204.947-1100
 F: 204.956-5742

603-63 Albert Street info@synyshyn.com
 Winnipeg, Manitoba
 R2B 1G4 Canada www.synyshyn.com

ENGINEERING CONSULTANT

ENGINEERING CONSULTANT

PROJECT TITLE
CENTRAL YARDS FIELD SERVICES BUILDING

1220 PACIFIC AVENUE OFFICE RENOVATION

1220 PACIFIC AVE. WINNIPEG MANITOBA

DRAWING TITLE

723-2015_FLOOR PATTERN AND FURNITURE PLAN_A4-R1

DESIGNED BY JN DRAWN BY JN

ISSUE DATE 09-14-2015 REVISION No. 1

PROJECT No. 15004 DRAWING No. **A-4**