


A
ELEVATION
M05 SCALE: 1:50

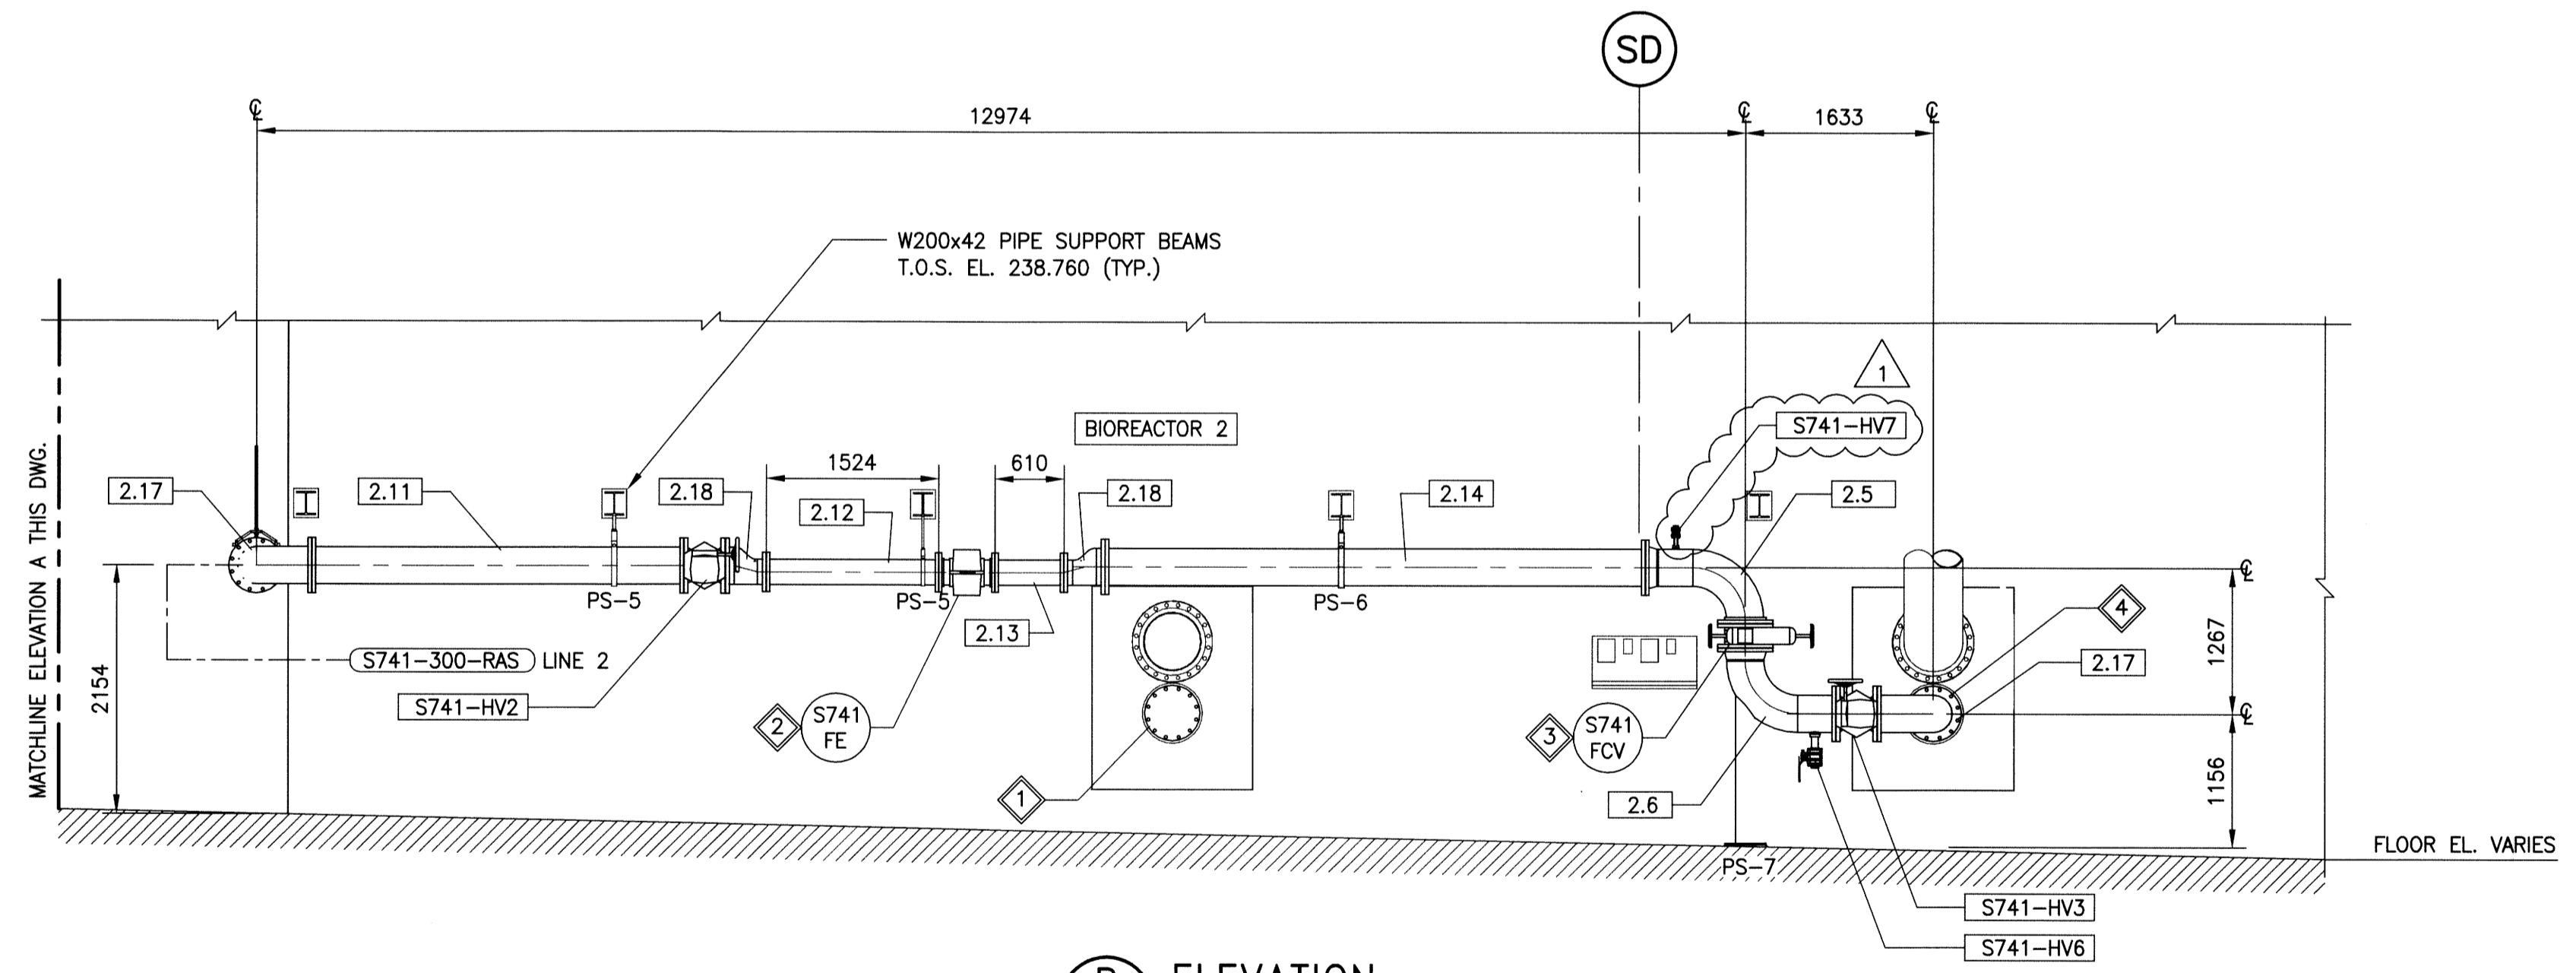

B
ELEVATION
M05 SCALE: 1:50


GENERAL NOTES:
1. REFER TO GENERAL NOTES ON DWG. M02.

KEYNOTES:
REFER TO KEYNOTES ON DWG. M05.


PIPE SUPPORTS
REFER TO DWG. M03 FOR PIPE SUPPORT DESCRIPTIONS.

PIPE SPOOL LIST
REFER TO DWG. M03.

VALVE LIST
REFER TO DWG. M03.

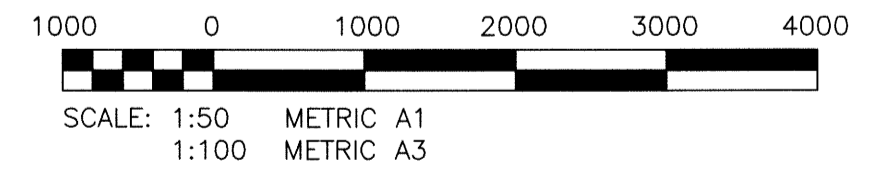

METRIC
WHOLE NUMBERS INDICATE MILLIMETRES
DECIMALIZED NUMBERS INDICATE METRES

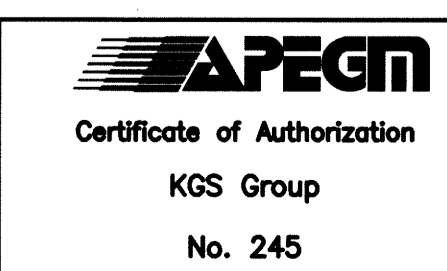

NO.	REVISIONS	DATE	BY
1	RE-ISSUED FOR CONSTRUCTION	15/09/25	JS
0	ISSUED FOR CONSTRUCTION	15/09/17	JS

DESIGNED BY	JS	CHECKED BY	RED
DRAWN BY	RP	APPROVED BY	JS
HOR. SCALE	AS NOTED	RELEASED FOR CONSTRUCTION	
VERTICAL	AS NOTED		
DATE	2015 08 17	DATE	2015 09 17

ENGINEER'S SEAL

 M06

THE CITY OF WINNIPEG
 WATER AND WASTE DEPARTMENT
 WEWPCC RAS PIPE REPLACEMENT
MECHANICAL
 RAS PIPING - ELEVATIONS
 SHEET 1 OF 1
 CITY DRAWING NUMBER
 1-0103S-M0033-001-01