

KEY PLAN
SCALE: NTS

REVISION NOTES:


- 1 EXISTING VINYL COMPOSITE TILE TO REMAIN.

DEMOLITION NOTES:

- 1 REMOVE EXISTING CARPET AND BASE. PREP SUBFLOOR TO RECEIVE NEW CARPET AND BASE.
- 2 REMOVE ALL EXISTING BLINDS. PATCH AND MAKE GOOD WALLS TO RECEIVE NEW WINDOW COVERINGS AND FINISH.
- 3 EXISTING TILE TO REMAIN.

NOTES:
 THESE DRAWINGS SHALL NOT BE SCALED.
 THE CONTRACTOR SHALL VISIT THE SITE AND SATISFY ONESELF ALL DIMENSIONS, DATUM, AND DETAILED INFORMATION SHOWN ARE CORRECT.
 ALL PRODUCTS AND MATERIALS TO BE USED AND INSTALLED SHALL CONFORM WITH MANUFACTURER'S SPECIFICATIONS & APPLICABLE CODES.
 THE CONTRACTOR SHALL BE RESPONSIBLE TO PATCH AND MAKE GOOD ALL EXISTING CONSTRUCTION AFFECTED BY THE REMOVAL OF ALL ITEMS FORMING THE PART OF THE RENOVATION WORK.
 WHERE NEW FLOORING AND BASE IS TO BE INSTALLED IN EXISTING AREAS (REFER TO FLOOR PLAN AND ROOM SCHEDULE), THE EXISTING FLOORING SURFACE AND BASE MUST BE REMOVED, UNLESS OTHERWISE NOTED. ALL FLOOR SURFACES SHALL BE PREPARED IN ACCORDANCE TO MANUFACTURER'S RECOMMENDATIONS FOR INSTALLATION OF NEW FLOOR.
 WHERE PAINTING OF EXISTING WALLS IS INDICATED ON THE ROOM SCHEDULE, THESE WALLS MUST BE CLEANED OF ANY EXISTING WALL COVERING, PATCHED & PREPARED TO ACCEPT NEW MATERIAL, UNLESS OTHERWISE NOTED.
 ALL PAINTS AND ADHESIVES USED TO BE LOW VOC.
 ALL CONSTRUCTION TO BE HOARDED VIA 6MM POLY AND DRYWALL FOR DUST CONTROL WITHIN PROJECT SPACE.
 CONTRACTOR TO ENSURE WORKSITE IS KEPT CLEAN OF DUST AND DEBRIS AT THE END OF EACH WORKDAY.

1	ISSUED FOR ADDENDUM 1 CEA	2015.10.15
0	ISSUED FOR BID CEA	2015.09.25
NO.	REVISION/DESCRIPTION	BY DATE
SEALS		

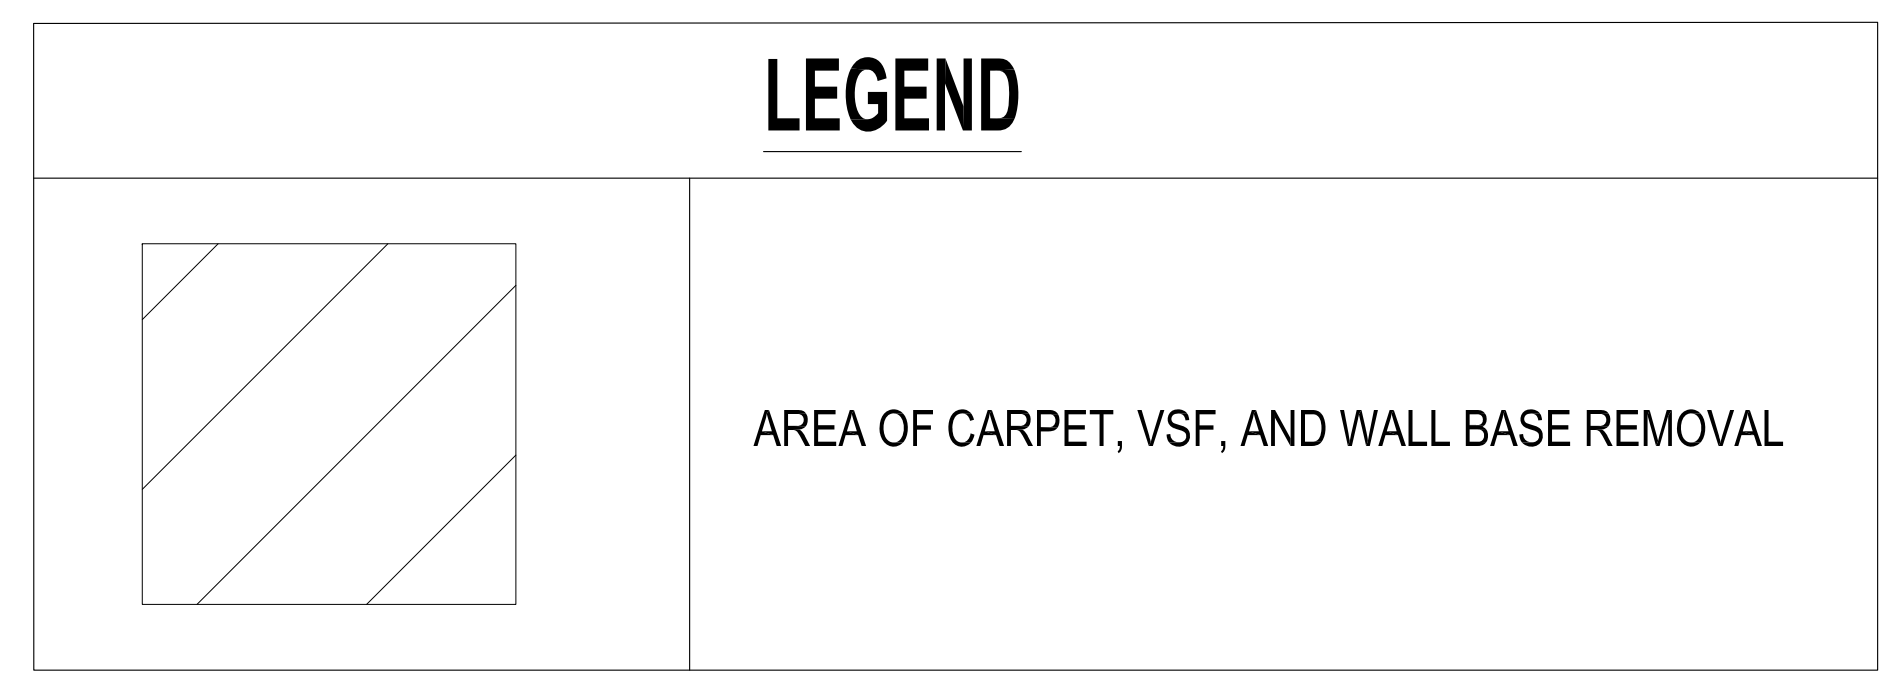

PARTIAL MAIN FLOOR PLAN - DEMOLITION
SCALE: 1/4"=1'-0"

DRAWN BY CEA DATE 2015.09.25	CHECKED BY USER APPROVAL	APPROVED
THE CITY OF WINNIPEG PLANNING, PROPERTY & DEVELOPMENT DEPARTMENT PROPERTY MANAGEMENT BRANCH MUNICIPAL ACCOMMODATIONS DIV.		
PROJECT FPS TRAINING CARPET & BLIND RENO 2546 McPhillips Street SHEET TITLE DEMOLITION PLAN		
SCALE AS SHOWN	PROJECT NO. 2015-107	SHEET NO. A1