


- REVISION NOTES:**
- EXISTING VINYL COMPOSITE TILE TO REMAIN.
 - NO RUBBER COVE BASE UNDER BASEBOARD HEATERS (TYP.)
 - CHANGE TO LOCATIONS OF ROLLER BLINDS IN/AROUND VESTIBULE

- CONSTRUCTION NOTES:**
- SUPPLY AND INSTALL NEW CARPET TILE AND RUBBER BASE AS SPECIFIED (AREA: 684.5 SQ. YDS/6160.5 SQ. FT.)
 - SUPPLY AND INSTALL NEW ROLLER BLINDS AS SPECIFIED. CONTRACTOR TO MEASURE ON SITE TO CONFIRM WINDOW SIZES.
 - SUPPLY AND INSTALL NEW VINYL SHEET FLOOR AND RUBBER BASE AS SPECIFIED (AREA: 53 SQ. YDS/477.0 SQ. FT.)
 - SUPPLY AND INSTALL NEW RUBBER TRANSITION STRIPS AT FLOORING CHANGES AS INDICATED. CONTRACTOR TO SITE MEASURE FOR THICKNESSES WHERE NEW FLOORING MATERIAL TRANSITIONING TO EXISTING AND SELECT APPROPRIATE JOHNSONITE RUBBER ADAPTOR. SEE FINISH SCHEDULE FOR COLOUR SPECIFICATIONS.
 - ALL WALLS TO BE PATCHED, PRIMED, AND PAINTED WHERE BLINDS REMOVED/INSTALLED. COLOUR TO MATCH TO EXISTING.

FINISH SCHEDULE			
CPT - CARPET TILE	MFC: SHAW	PATTERN: TEMPT 5T019	COLOUR: TEASE 18504
VSF - VINYL SHEET FLOORING	MFC: TARKETT IQ	PATTERN: OPTIMA	COLOUR: HARDWIRED 874
RB - RUBBER COVE BASE	MFC: JOHNSONITE	STYLE: TRADITIONAL CB-20	COLOUR: CHARCOAL 20
RT1 - NEW CPT TO EXISTING CERAMIC TILE	MFC: JOHNSONITE	STYLE: ADAPTOR TBD	COLOUR: GREY 48
RT2 - NEW CPT TO NEW VSF	MFC: JOHNSONITE	STYLE: SLT-48-C	COLOUR: GREY 48
RT3 - NEW CPT TO EXISTING VINYL FLOOR	MFC: JOHNSONITE	STYLE: ADAPTOR TBD	COLOUR: GREY 48

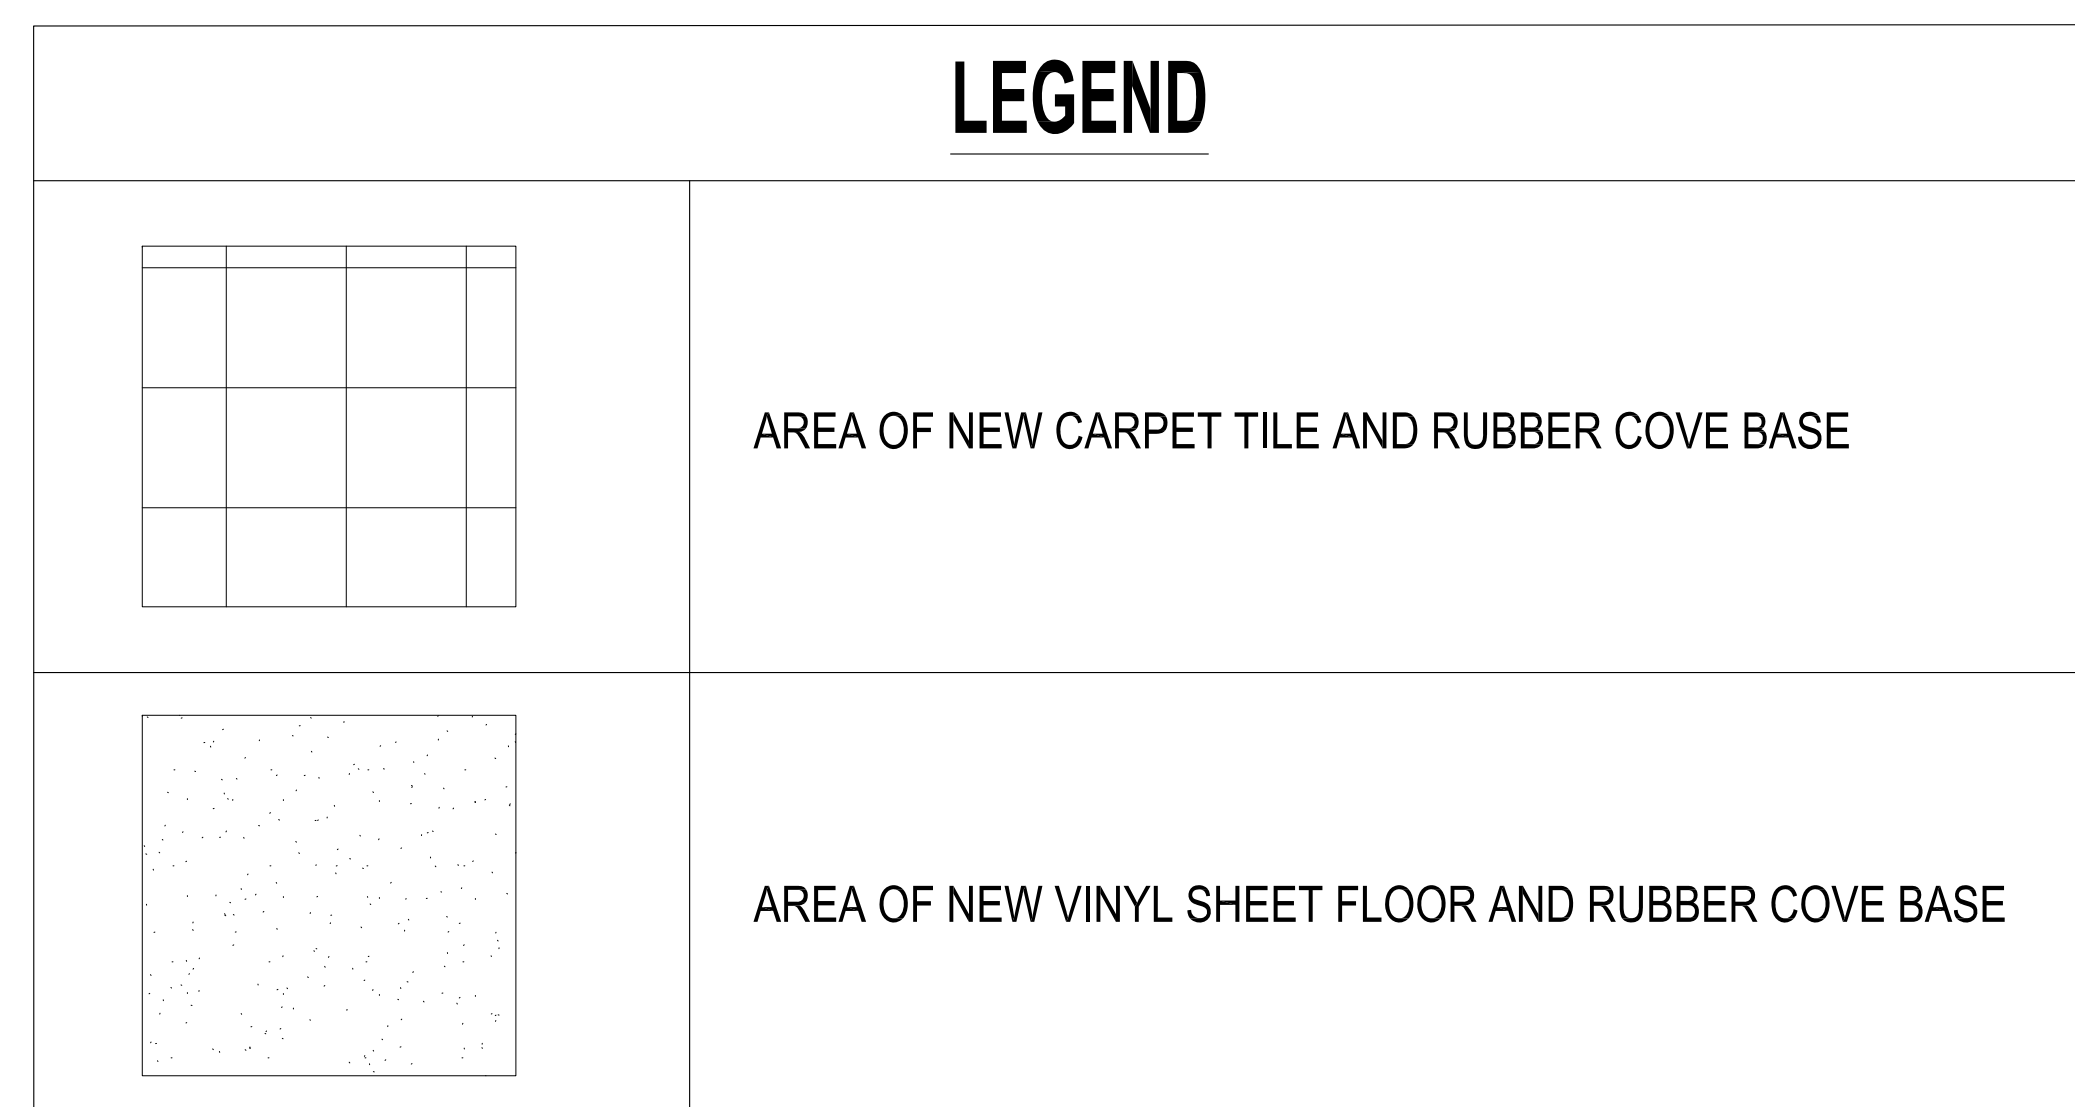

NOTES:

THESE DRAWINGS SHALL NOT BE SCALED.

THE CONTRACTOR SHALL VISIT THE SITE AND SATISFY ONESELF ALL DIMENSIONS, DATUM, AND DETAILED INFORMATION SHOWN ARE CORRECT.

ALL PRODUCTS AND MATERIALS TO BE USED AND INSTALLED SHALL CONFORM WITH MANUFACTURERS SPECIFICATIONS & APPLICABLE CODES.

THE CONTRACTOR SHALL BE RESPONSIBLE TO PATCH AND MAKE GOOD ALL EXISTING CONSTRUCTION AFFECTED BY THE REMOVAL OF ALL ITEMS FORMING THE PART OF THE RENOVATION WORK.

WHERE NEW FLOORING AND BASE IS TO BE INSTALLED IN EXISTING AREAS (REFER TO FLOOR PLAN AND ROOM SCHEDULE), THE EXISTING FLOORING SURFACE AND BASE MUST BE REMOVED, UNLESS OTHERWISE NOTED. ALL FLOOR SURFACES SHALL BE PREPARED IN ACCORDANCE TO MANUFACTURERS RECOMMENDATIONS FOR INSTALLATION OF NEW FLOOR.

WHERE PAINTING OF EXISTING WALLS IS INDICATED ON THE ROOM SCHEDULE, THESE WALLS MUST BE CLEANED OF ANY EXISTING WALL COVERING, PATCHED & PREPARED TO ACCEPT NEW MATERIAL, UNLESS OTHERWISE NOTED.

ALL PAINTS AND ADHESIVES USED TO BE LOW VOC.

ALL CONSTRUCTION TO BE HOARDED VIA 6MM POLY AND DRYWALL FOR DUST CONTROL WITHIN PROJECT SPACE.

CONTRACTOR TO ENSURE WORKSITE IS KEPT CLEAN OF DUST AND DEBRIS AT THE END OF EACH WORKDAY.

ISSUED FOR ADDENDUM 1 CEA 2015.10.15
 AREA OF NEW CPT, LOCATIONS OF RUBBER COVE BASE, LOCATIONS OF NEW ROLLER BLINDS

NO.	REVISION/DESCRIPTION	BY	DATE
0	ISSUED FOR BID	CEA	2015.09.25

DRAWN BY: CEA
 CHECKED BY: [blank]
 DATE: 2015.09.25
 USER APPROVAL: [blank]

THE CITY OF WINNIPEG
 PLANNING, PROPERTY & DEVELOPMENT DEPARTMENT
 PROPERTY MANAGEMENT BRANCH
 MUNICIPAL ACCOMMODATIONS DIV.
 3RD FLOOR, 65 GARRY ST. R3C 4K4

PROJECT:
 FPS TRAINING
 CARPET & BLIND RENO
 2546 McPhillips Street
 SHEET TITLE

NEW CONSTRUCTION

SCALE	PROJECT NO.	SHEET NO.
AS SHOWN	2015-07	A2