



A SECTION
1:100
PGAD-R001
PGAD-R005
PGAD-R009

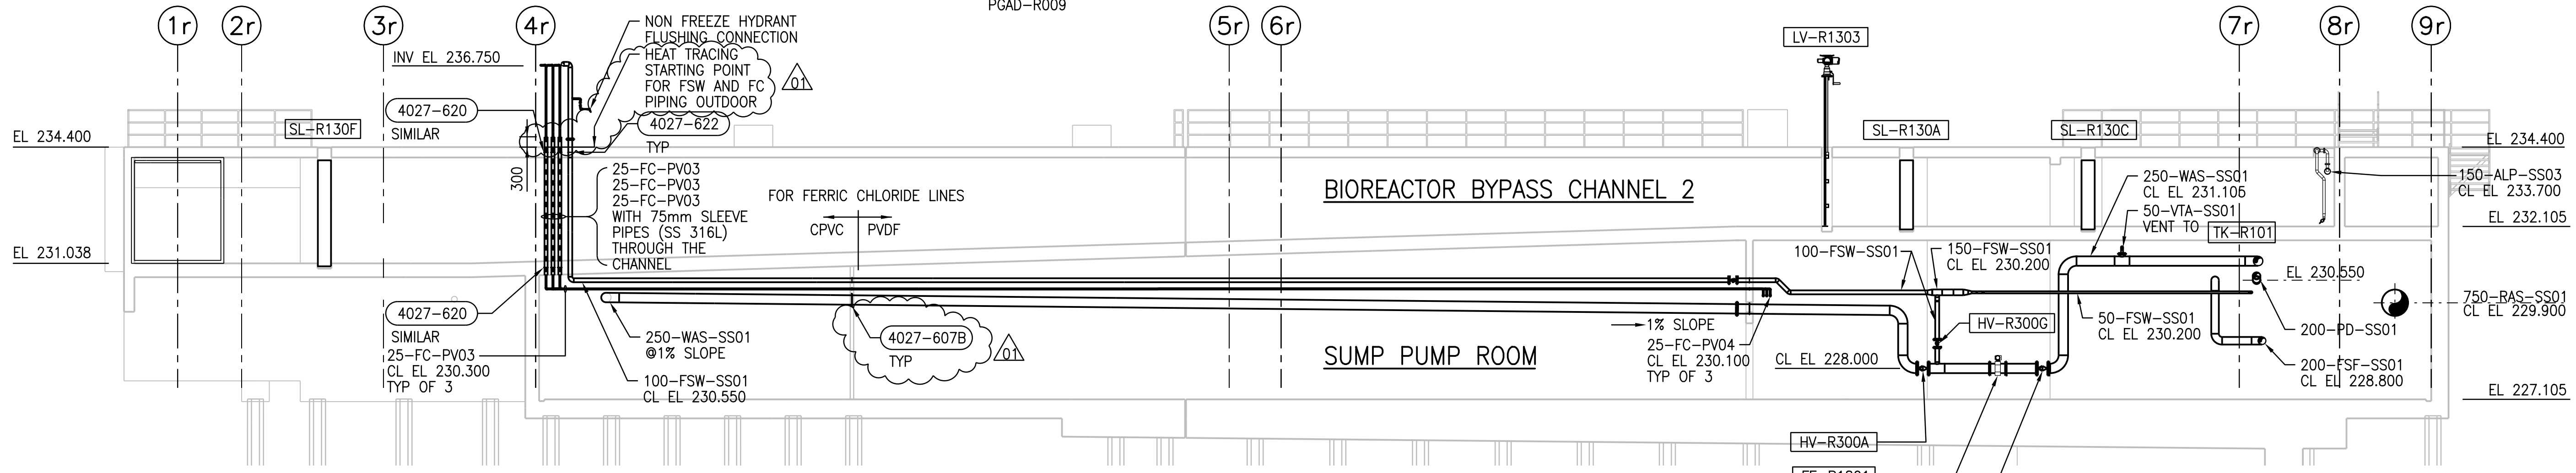

A1 SECTION
1:100
PGAD-R001
PGAD-R005
PGAD-R009

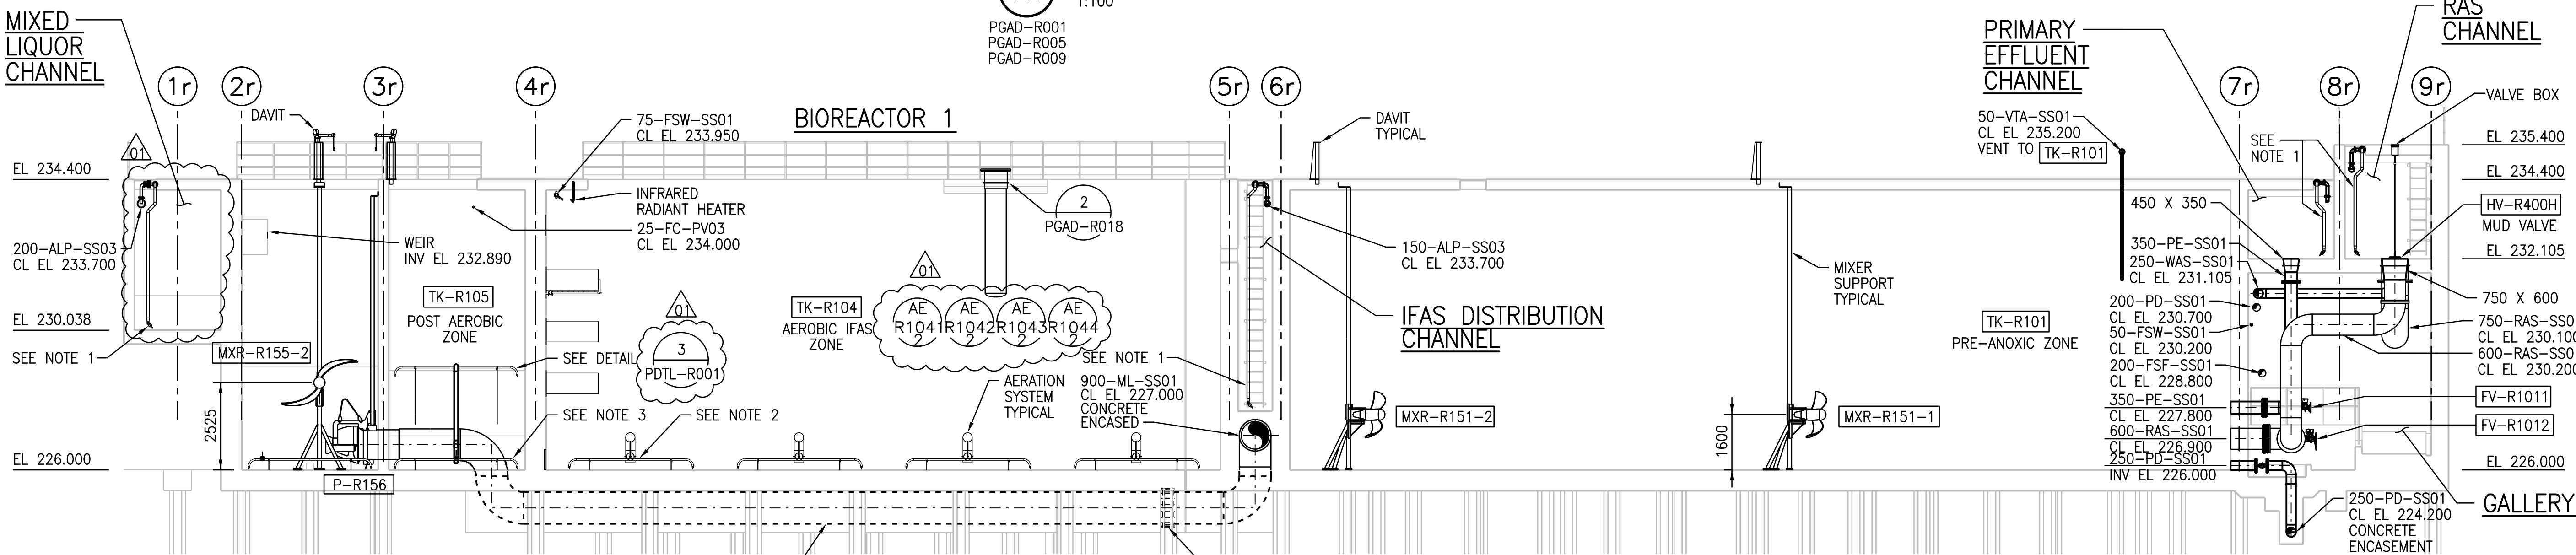

B SECTION
1:100
PGAD-R001
PGAD-R005
PGAD-R009

- NOTES:**
1. COARSE BUBBLE AERATION REMOVABLE MANIFOLD ASSEMBLIES TYPICAL (REFER TO VENDOR DRAWINGS FOR PLACEMENT LOCATION AND DETAILS).
 2. AEROBIC IFAS ZONE AERATION SYSTEM(REFER TO VENDOR DRAWINGS FOR PLACEMENT LOCATION AND DETAILS).
 3. POST AEROBIC ZONE AERATION ASSEMBLIES SYSTEM(REFER TO VENDOR DRAWINGS FOR PLACEMENT LOCATION AND DETAILS).



CH2MHILL SNC-LAVALIN DESIGNED BY: F. ABSI DRAWN BY: B. COOPER SCALE: 1:100 DATE: 2016/01/29 CONSULTANT NO.: 474248		KCS ENGINEER'S SEAL 20/02/2016 F. J. ABSI Member 36875		THE CITY OF WINNIPEG WATER AND WASTE DEPARTMENT SOUTH END WATER POLLUTION CONTROL CENTRE SEWPPC UPGRADING/EXPANSION PROJECT PROCESS BIOREACTORS/BLOWER BUILDING SECTIONS A, A1 AND B	
01 ISSUED FOR ADD. 2 - B.O. 899-2015	02/2016	B.C.	J.C.	DATE: 2016/01/29	ISSUED FOR CONSTRUCTION
00 ISSUED FOR TENDER - B.O. 899-2015	01/2016	B.C.	J.C.	DATE: 2016/01/29	DATE: 2016/01/29
PLOT DATE: 2/24/2016 FILE NAME: 1-0102-PGAD-R014.dgn		CITY DRAWING NUMBER: 1-0102-PGAD-R014		SHEET: 001 REV: 01 SIZE: A1	