


C SECTION
1:100
PGAD-R001
PGAD-R005
PGAD-R009

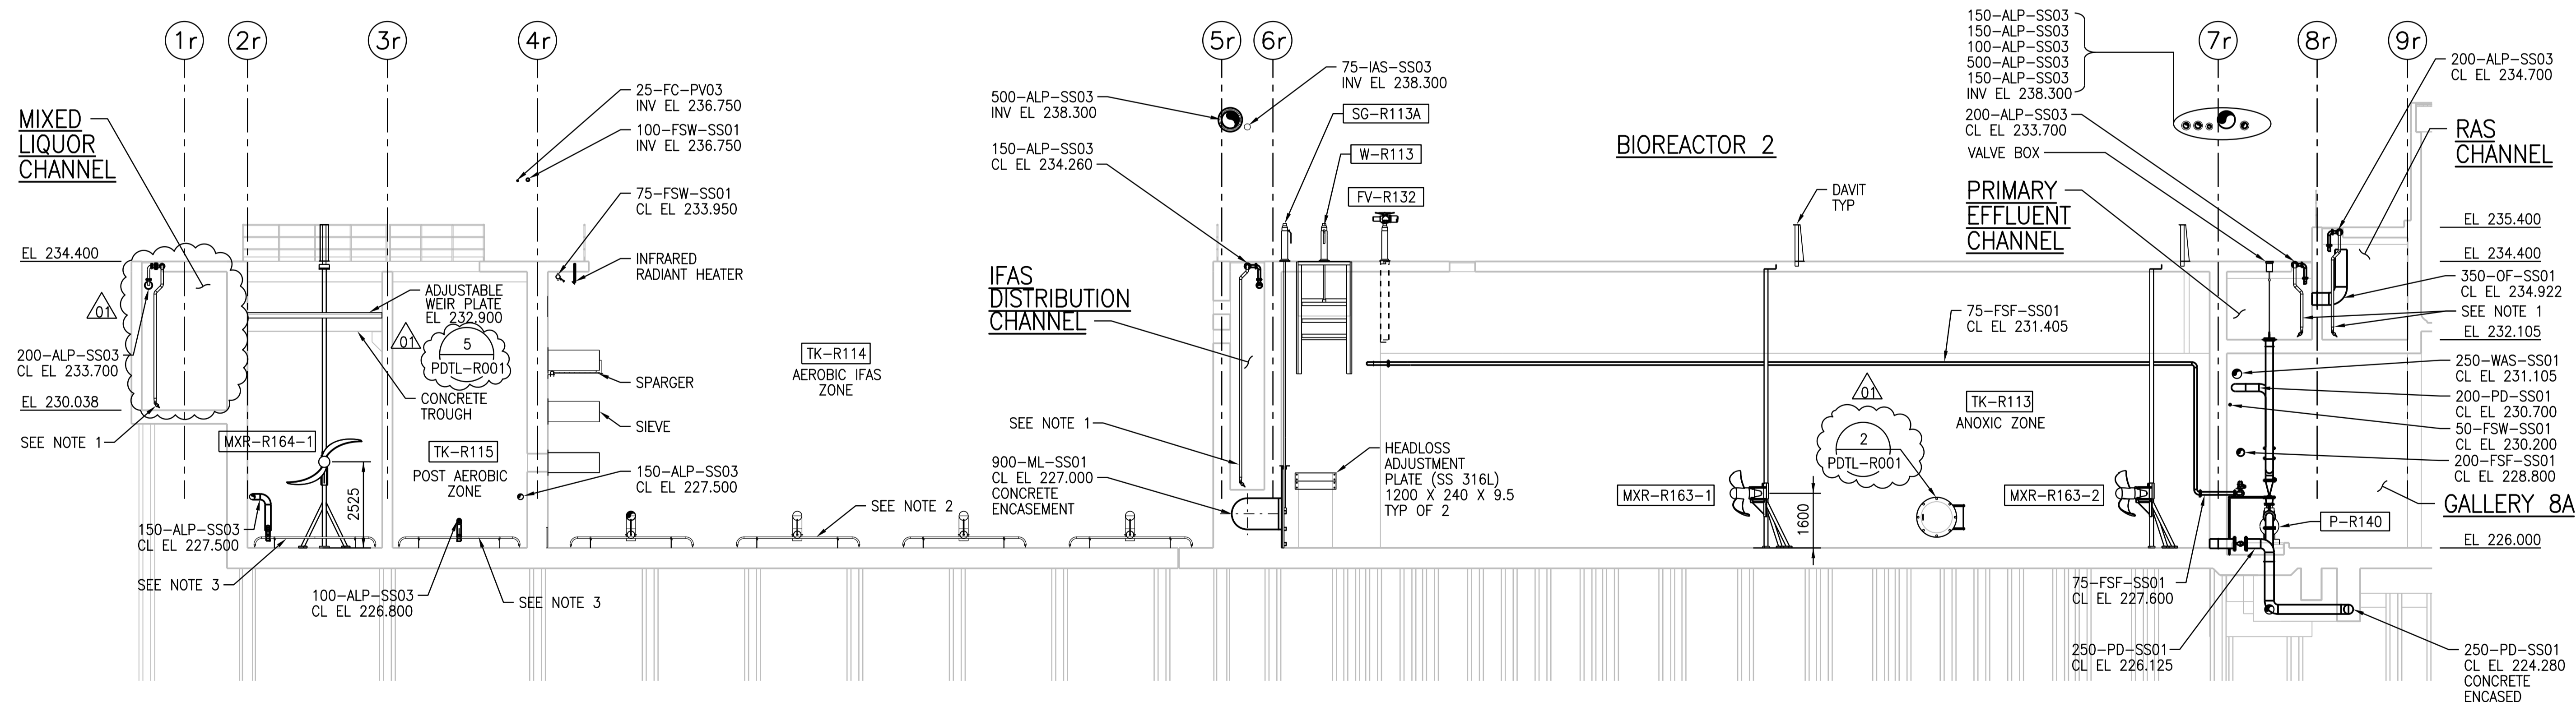

D SECTION
1:100
PGAD-R001
PGAD-R005
PGAD-R009

NOTES:

1. COARSE BUBBLE AERATION REMOVABLE MANIFOLD ASSEMBLIES TYPICAL (REFER TO VENDOR DRAWINGS FOR PLACEMENT LOCATION AND DETAILS).
2. AEROBIC IFAS ZONE AERATION SYSTEM (REFER TO VENDOR DRAWINGS FOR PLACEMENT LOCATION AND DETAILS).
3. POST AEROBIC ZONE AERATION ASSEMBLIES SYSTEM (REFER TO VENDOR DRAWINGS FOR PLACEMENT LOCATION AND DETAILS).



DESIGNED BY: F. ABSI		CHECKED BY: B. EDGAR		APPROVED BY: H.T. FREIHAMMER		SOUTH END WATER POLLUTION CONTROL CENTRE SEWPPC UPGRADING/EXPANSION PROJECT PROCESS BIOREACTORS/BLOWER BUILDING SECTIONS C AND D	
DRAWN BY: B. COOPER		SCALE: 1:100		ISSUED FOR CONSTRUCTION BY: T. TURZAK		CITY DRAWING NUMBER 1-0102-PGAD-R015	
DATE: 2016/01/29		DATE: 2016/01/29		CONSULTANT NO.: 474248		SHEET REV. SIZE 001 01 A1	
01 ISSUED FOR ADD. 2 - B.O. 899-2015 02/2016 B.C. J.C.		00 ISSUED FOR TENDER - B.O. 899-2015 01/2016 B.C. J.C.		PLOT DATE: 2/24/2016		FILE NAME: 1-0102-PGAD-R015.dgn	