



A1 SIZE - 594mm x 841mm

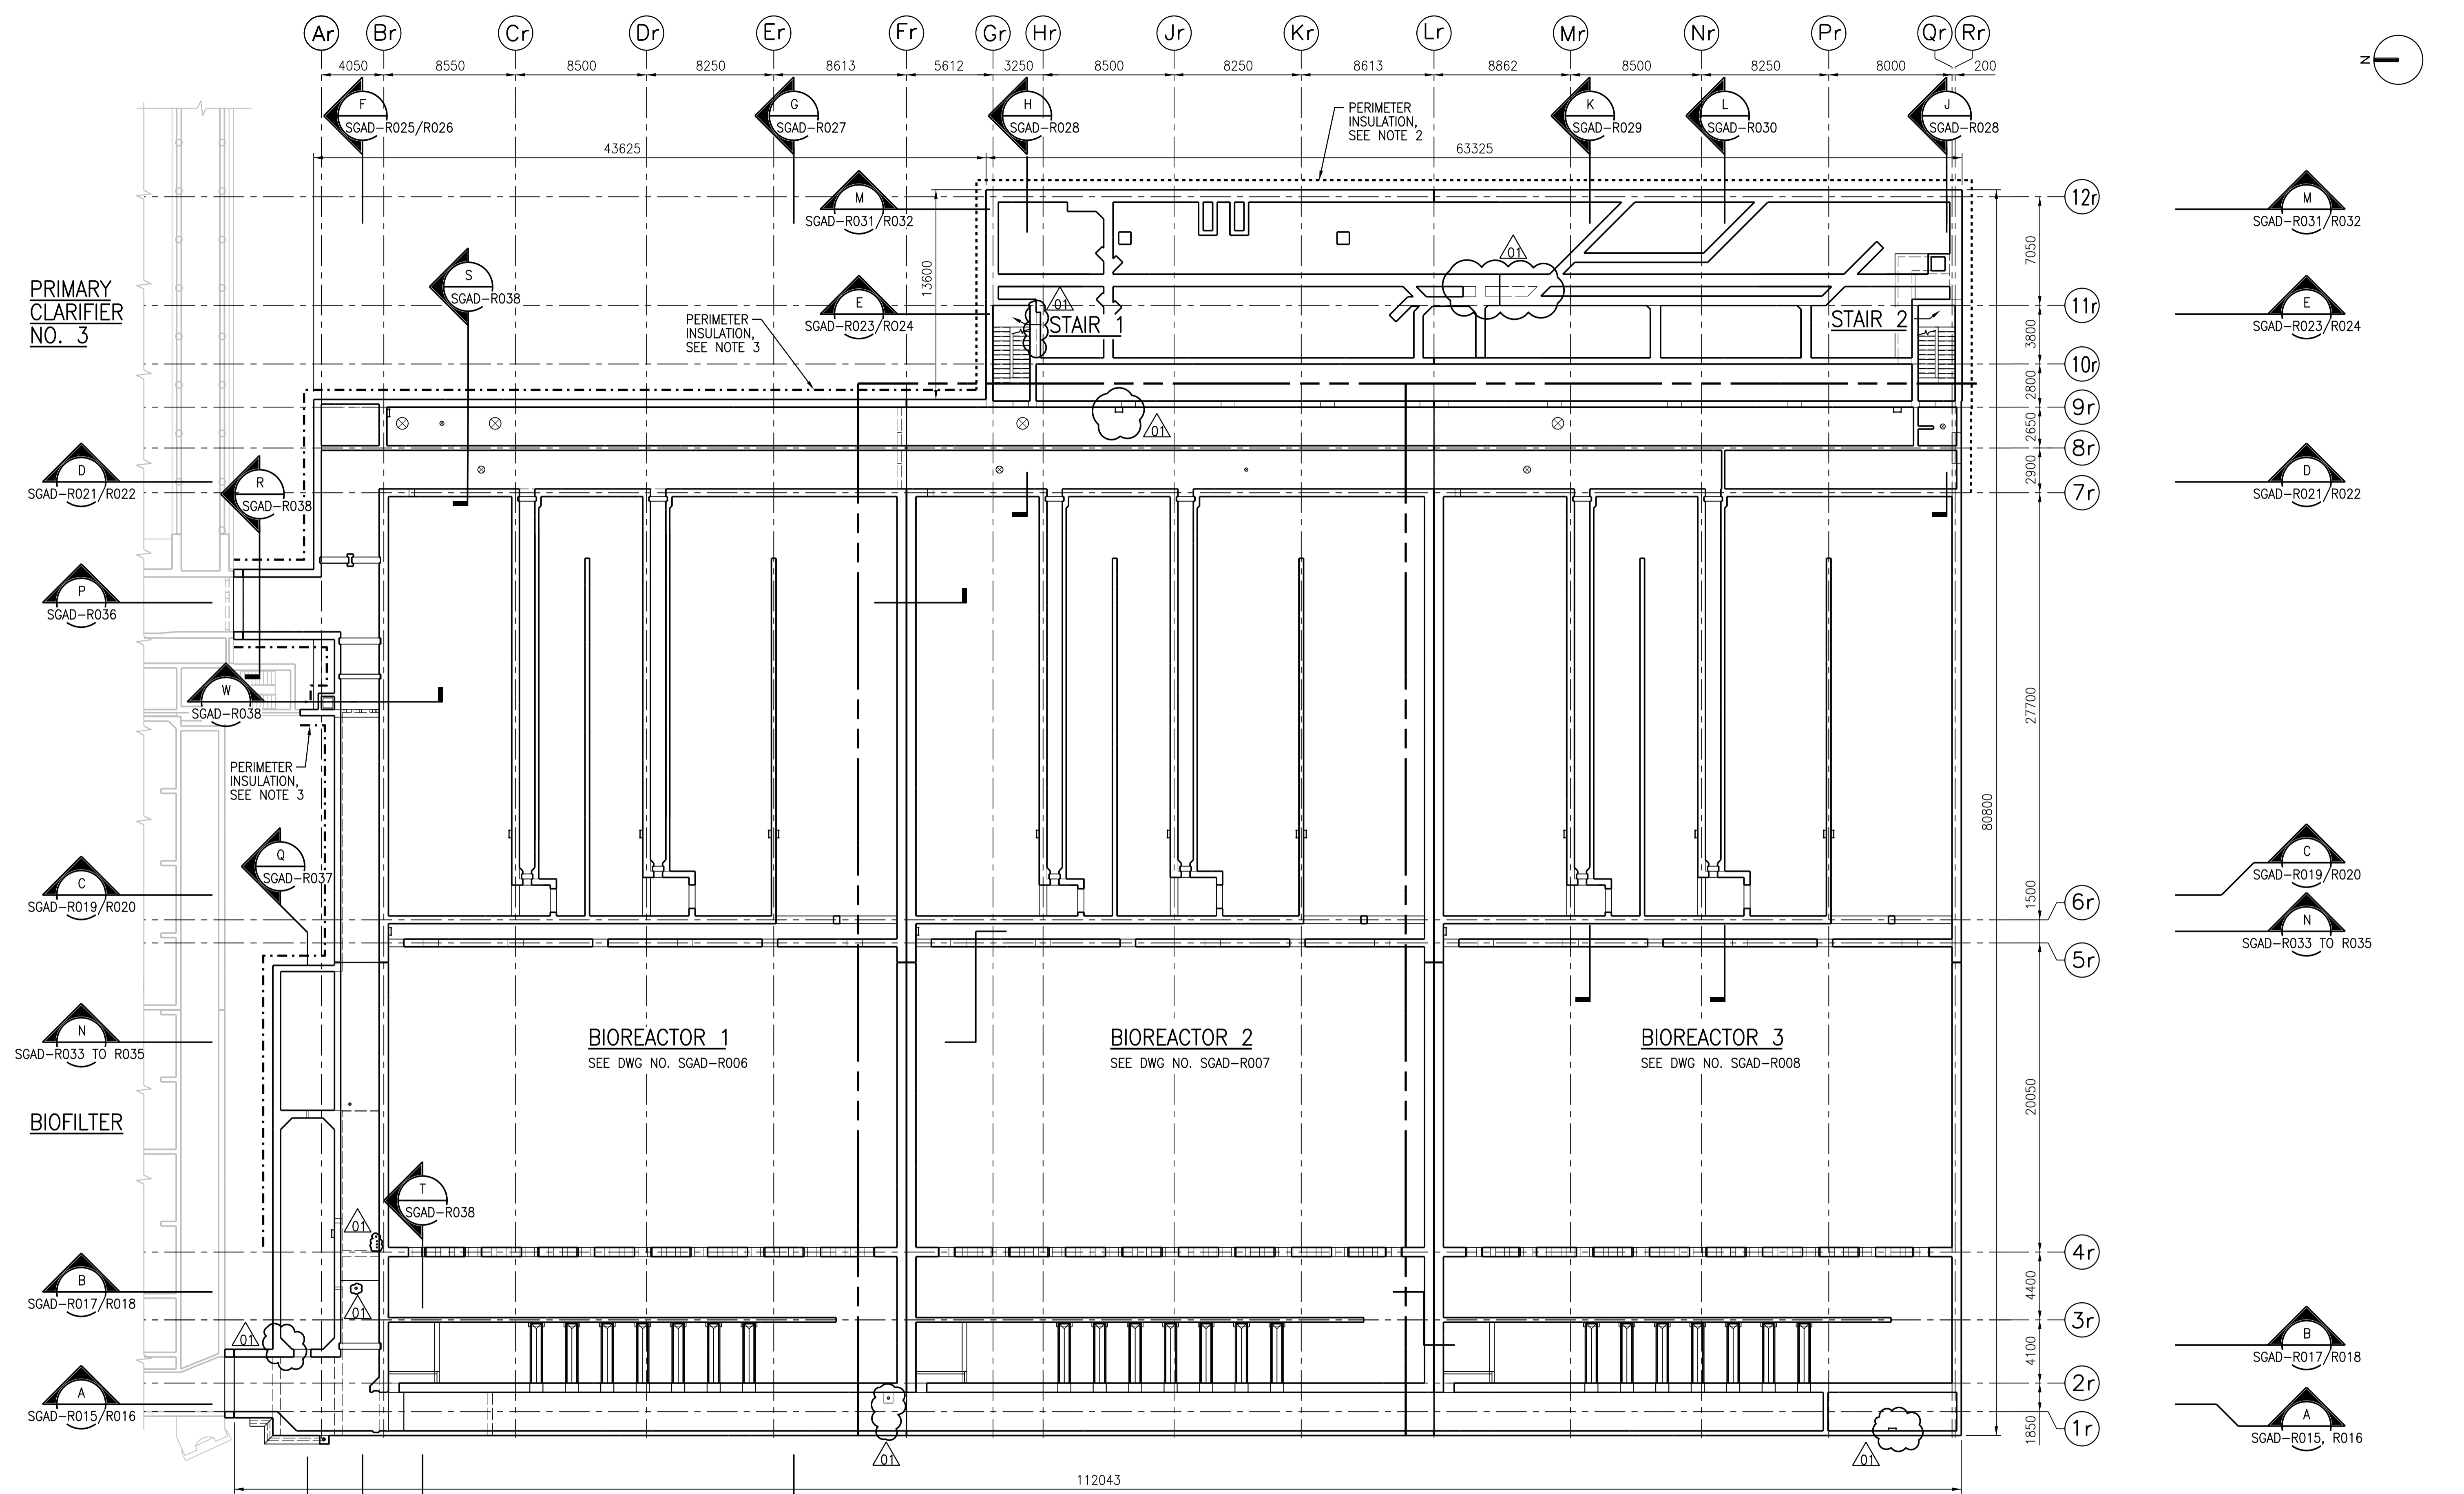


OVERALL CHANNEL LEVEL PLAN

1:200

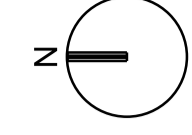

- NOTES:**
- REFER TO DRAWING 1-0102-SGAD-A001 FOR GENERAL STRUCTURAL NOTES.
 - INSTALL PERIMETER INSULATION STARTING FROM EL 232.400 AND CARRIED DOWN 2150mm
 - INSTALL PERIMETER INSULATION STARTING FROM EL 232.400 AND CARRIED DOWN 2900mm
 - A MINIMUM LEVEL OF COMPACTED BACKFILL AT WEST AND EAST ENDS OF BIOREACTOR TANKS IS REQUIRED FOR OPERATION. TANKS MUST BE EMPTIED PRIOR TO EXCAVATING BELOW THIS ELEVATION, SEE DRAWING

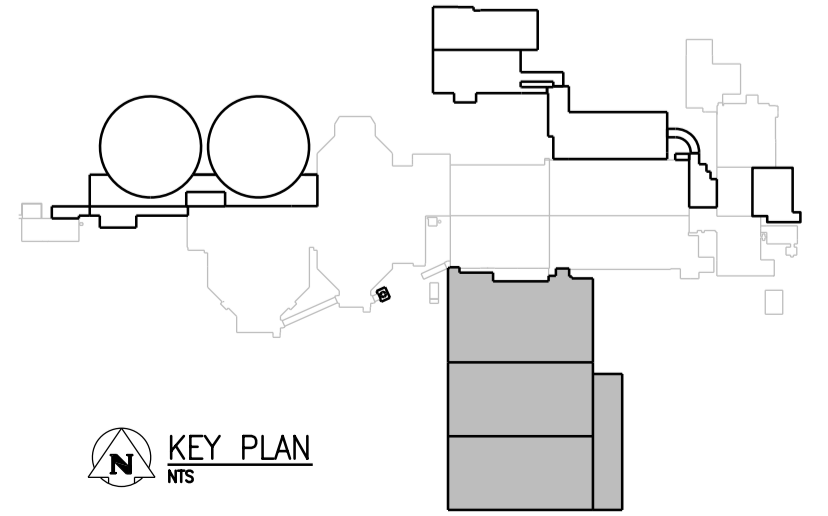

NO.	REVISIONS	DATE	DESIGN	CHECK
01	ISSUED FOR ADD. 2 - B.O. 899-2015	02/2016	C.R.	J.C.
00	ISSUED FOR TENDER - B.O. 899-2015	01/2016	C.R.	J.C.

CH2MHILL
SNC-LAVALIN

DESIGNED BY: J. THANNICKAL
DRAWN BY: C. RYNARD
SCALE: 1:200
DATE: 2016/01/29
CONSULTANT NO.: 474248

CHECKED BY: E. LUI
APPROVED BY: H.T. FREIHAMMER
ISSUED FOR CONSTRUCTION BY: T. TURZAK
DATE: 2016/01/29

ENGINEER'S SEAL
24/02/2016
PROVINCE OF MANITOBA
S.L.E. LUI
Member 37003
REGISTERED PROFESSIONAL ENGINEER

THE CITY OF WINNIPEG
Winnipeg WATER AND WASTE DEPARTMENT

SOUTH END WATER POLLUTION CONTROL CENTRE
SEWPC UPGRADING/EXPANSION PROJECT
STRUCTURAL
BIOREACTORS/BLOWER BUILDING
OVERALL CHANNEL LEVEL PLAN

CITY DRAWING NUMBER: 1-0102-SGAD-R005
SHEET: 001
REV.: 01
SIZE: A1

©CH2M HILL 2015. ALL RIGHTS RESERVED.