



MATCH LINE, SEE DWG. MGAD-S503

SECONDARY CLARIFIER 4

STORAGE ROOM

GALLERY 3A

BASEMENT PLAN - PART C
1:50

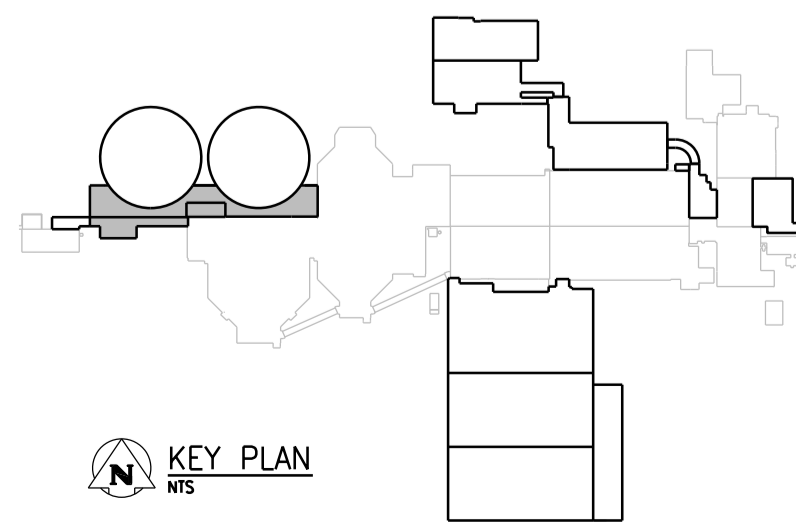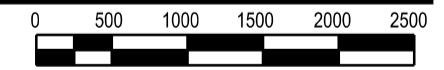


APEGM
Certificate of Authorization
CH2M HILL Canada Ltd.
No. 1441

| NO. | REVISIONS | DATE | DESIGN | CHECK |
|-----|-----------------------------------|---------|--------|-------|
| 02 | ISSUED FOR ADD. 4 - B.O. 899-2015 | 03/2016 | A.B. | T.T. |
| 01 | ISSUED FOR ADD. 2 - B.O. 899-2015 | 02/2016 | A.B. | T.T. |
| 00 | ISSUED FOR TENDER - B.O. 899-2015 | 01/2016 | P.K. | T.T. |

CH2MHILL
SNC-LAVALIN
DESIGNED BY: T. TRAN
DRAWN BY: P. KWONG
SCALE: 1:50
DATE: 2016/01/29
CONSULTANT NO.: 474248

CHECKED BY: D. LE
APPROVED BY: H.T. FREIHAMMER
ISSUED FOR CONSTRUCTION BY: T. TURZAK
DATE: 2016/01/29

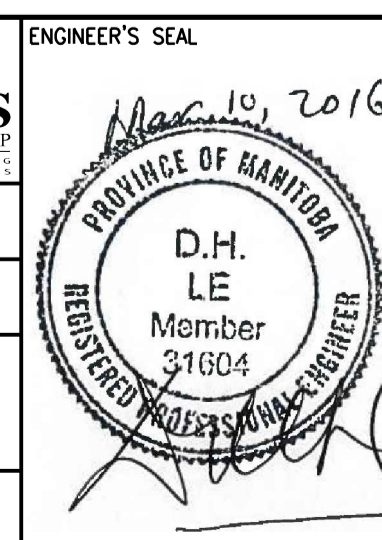

THE CITY OF WINNIPEG
Winnipeg WATER AND WASTE DEPARTMENT
SOUTH END WATER POLLUTION CONTROL CENTRE
SEWPC UPGRADING/EXPANSION PROJECT
PLUMBING
SECONDARY CLARIFIERS 4 AND 5
PLUMBING - BASEMENT PLAN - PART C
CITY DRAWING NUMBER: 1-0102-MGAD-S504
SHEET: 001
REV: 02
SIZE: A1