


LOWER LEVEL PLAN - PART B
1:50

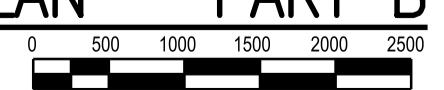

APEGM
Certificate of Authorization
CH2M HILL Canada Ltd.
No. 1441

NO.	REVISIONS	DATE	DESIGN	CHECK
01	ISSUED FOR ADD. 4 - B.O. 899-2015	03/2016	B.C.	J.C.
00	ISSUED FOR TENDER - B.O. 899-2015	01/2016	B.C.	J.C.

CH2MHILL		KGS GROUP	
SNC-LAVALIN		ENGINEER'S SEAL	
DESIGNED BY: F. ABSI	CHECKED BY: B. EDGAR		
DRAWN BY: B. COOPER	APPROVED BY: H.T. FREIHAMMER		
SCALE: 1:50	ISSUED FOR CONSTRUCTION BY: T. TURZAK		
DATE: 2016/01/29		DATE: 2016/01/29	
CONSULTANT NO.: 474248			

THE CITY OF WINNIPEG
WATER AND WASTE DEPARTMENT

SOUTH END WATER POLLUTION CONTROL CENTRE
SEWPCC UPGRADING/EXPANSION PROJECT
PROCESS
SECONDARY CLARIFIERS 4 AND 5
LOWER LEVEL PLAN - PART B

CITY DRAWING NUMBER: 1-0102-PGAD-S003 | SHEET: 001 | REV: 01 | SIZE: A1