


A SECTION
1:100
PGAD-S001
PGAD-S002
PGAD-S003

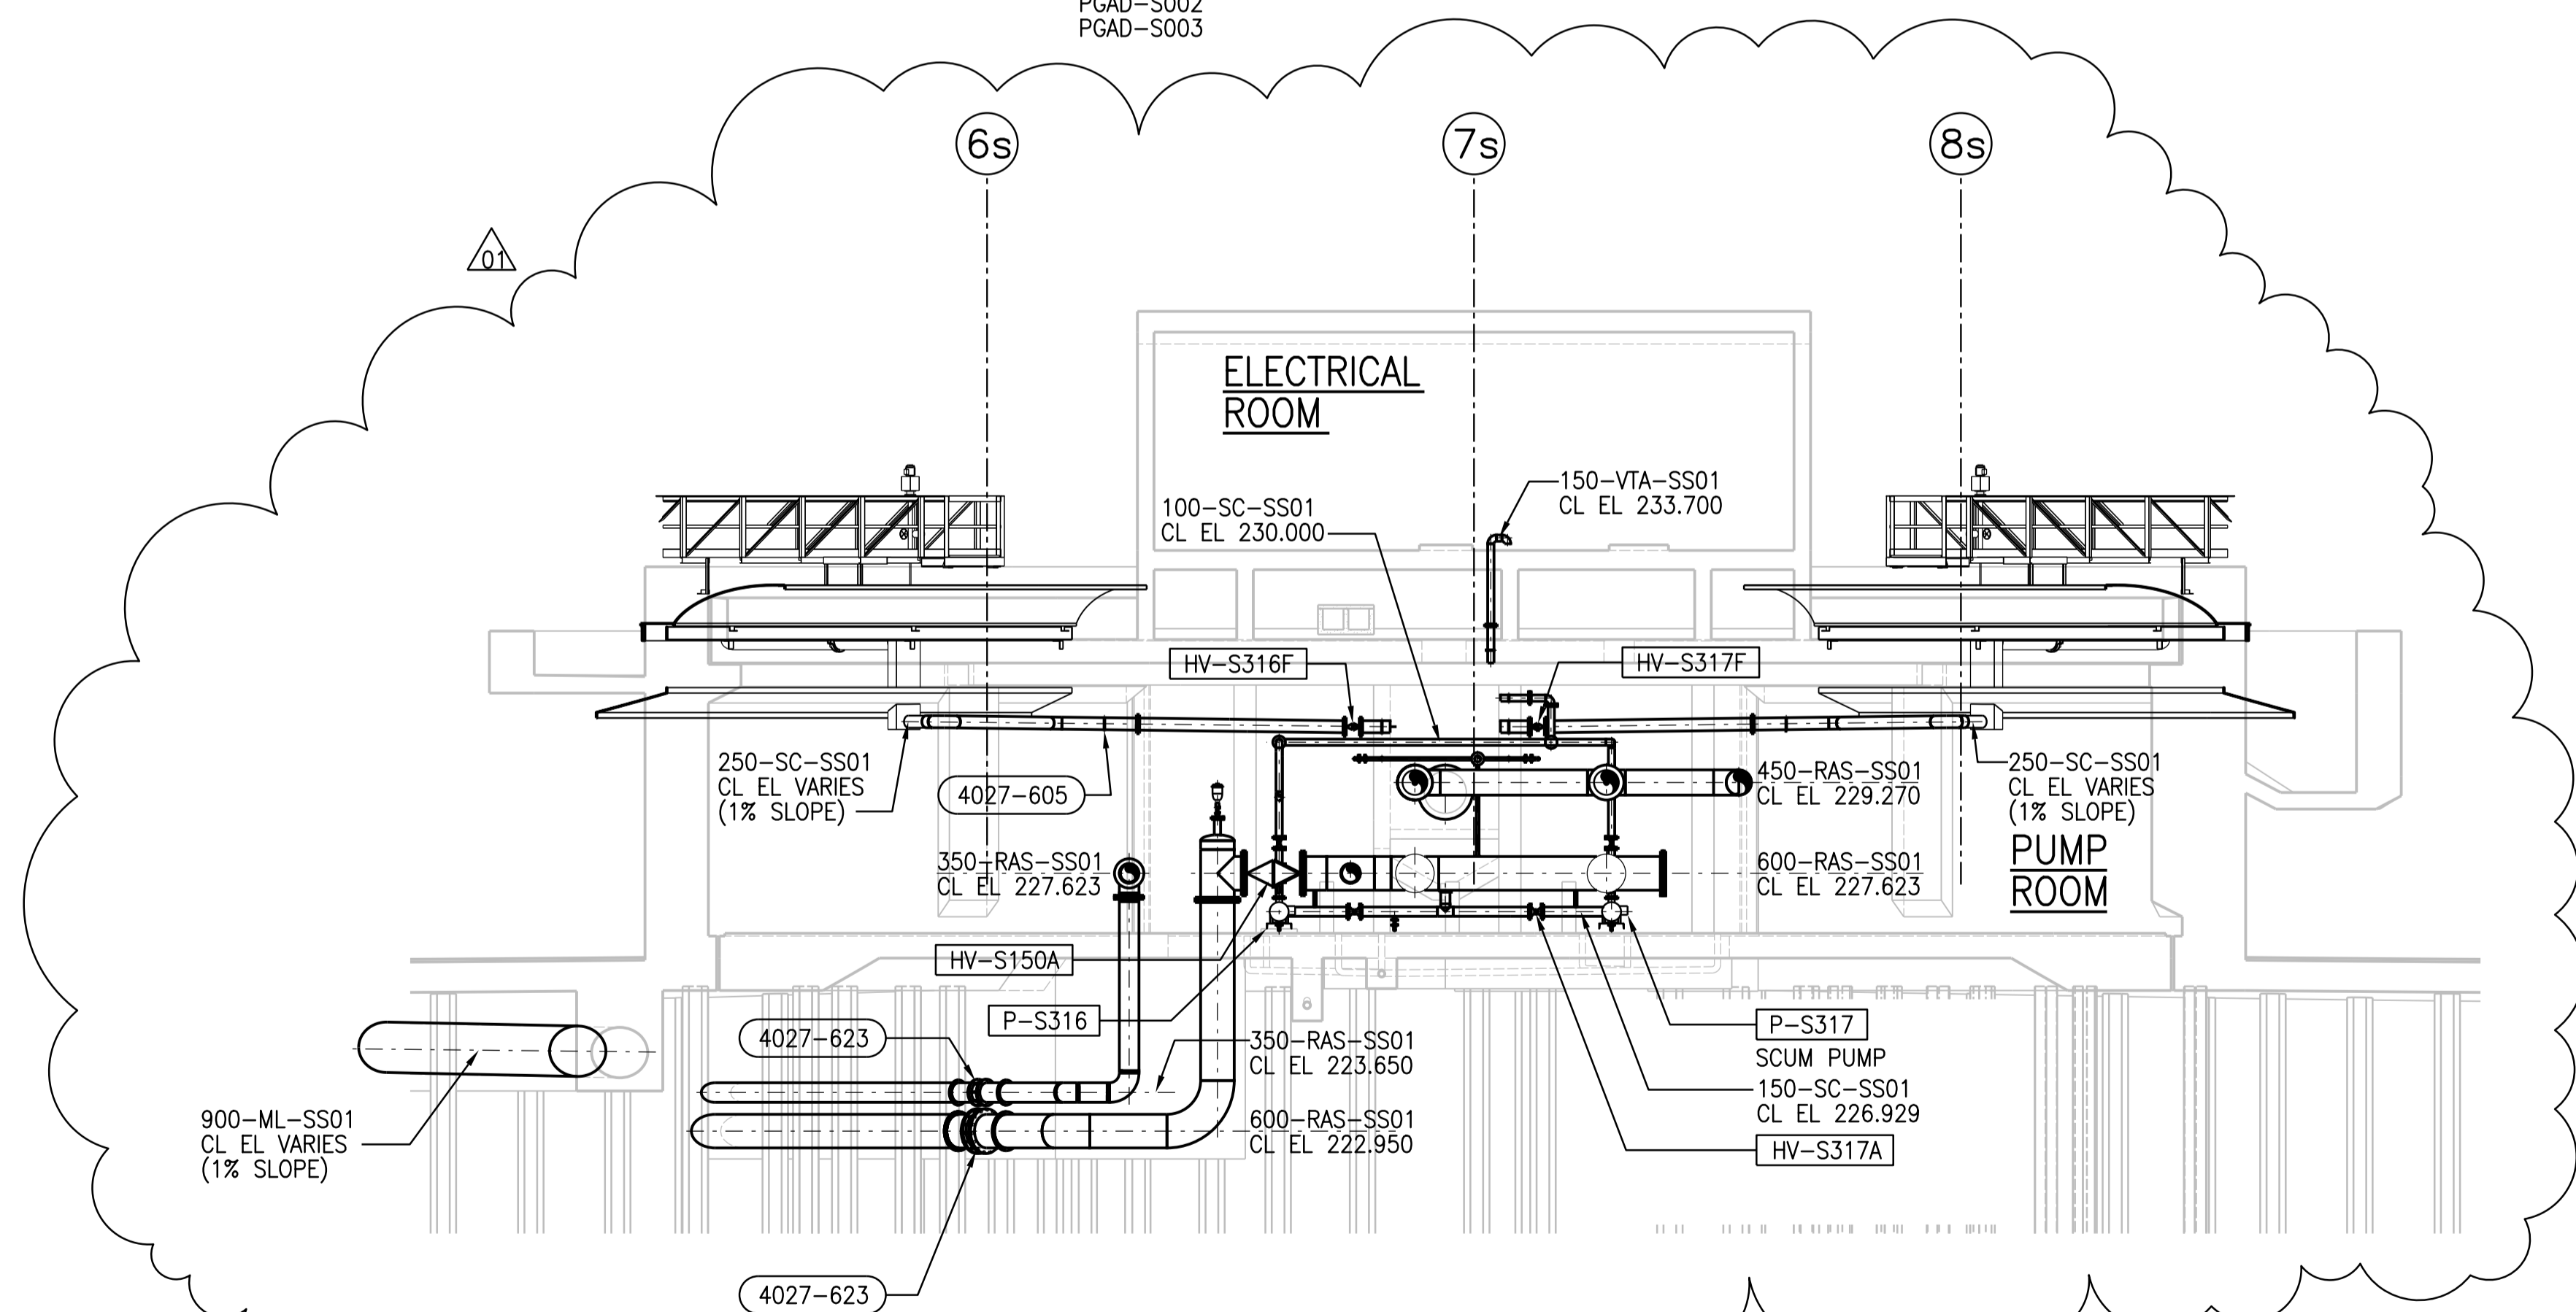


A1 SECTION
1:100
PGAD-S001
PGAD-S002
PGAD-S003

APEGM
Certificate of Authorization
CH2M HILL Canada Ltd.
No. 1441

NO.	REVISIONS	DATE	DESIGN	CHECK
01	ISSUED FOR ADD. 4 - B.O. 899-2015	03/2016	B.C.	J.C.
00	ISSUED FOR TENDER - B.O. 899-2015	01/2016	B.C.	J.C.

CH2MHILL		KCS GROUP	
SNC-LAVALIN		ENGINEERING CONSULTANTS	
DESIGNED BY: F. ABSI	CHECKED BY: B. EDGAR	APPROVED BY: H.T. FREIHAMMER	ISSUED FOR CONSTRUCTION BY: T. TURZAK
DRAWN BY: B. COOPER	DATE: 2016/01/29	DATE: 2016/01/29	CONSULTANT NO.: 474248
SCALE: 1:100			

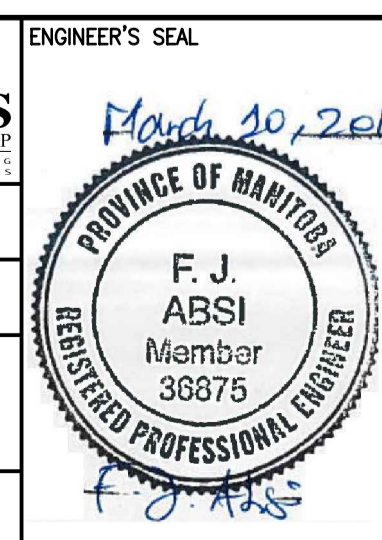

THE CITY OF WINNIPEG
WATER AND WASTE DEPARTMENT

SOUTH END WATER POLLUTION CONTROL CENTRE
SEWPCC UPGRADING/EXPANSION PROJECT
PROCESS
SECONDARY CLARIFIERS 4 AND 5
SECTION A AND A1

CITY DRAWING NUMBER: 1-0102-PGAD-S010 | SHEET: 001 | REV: 01 | SIZE: A1