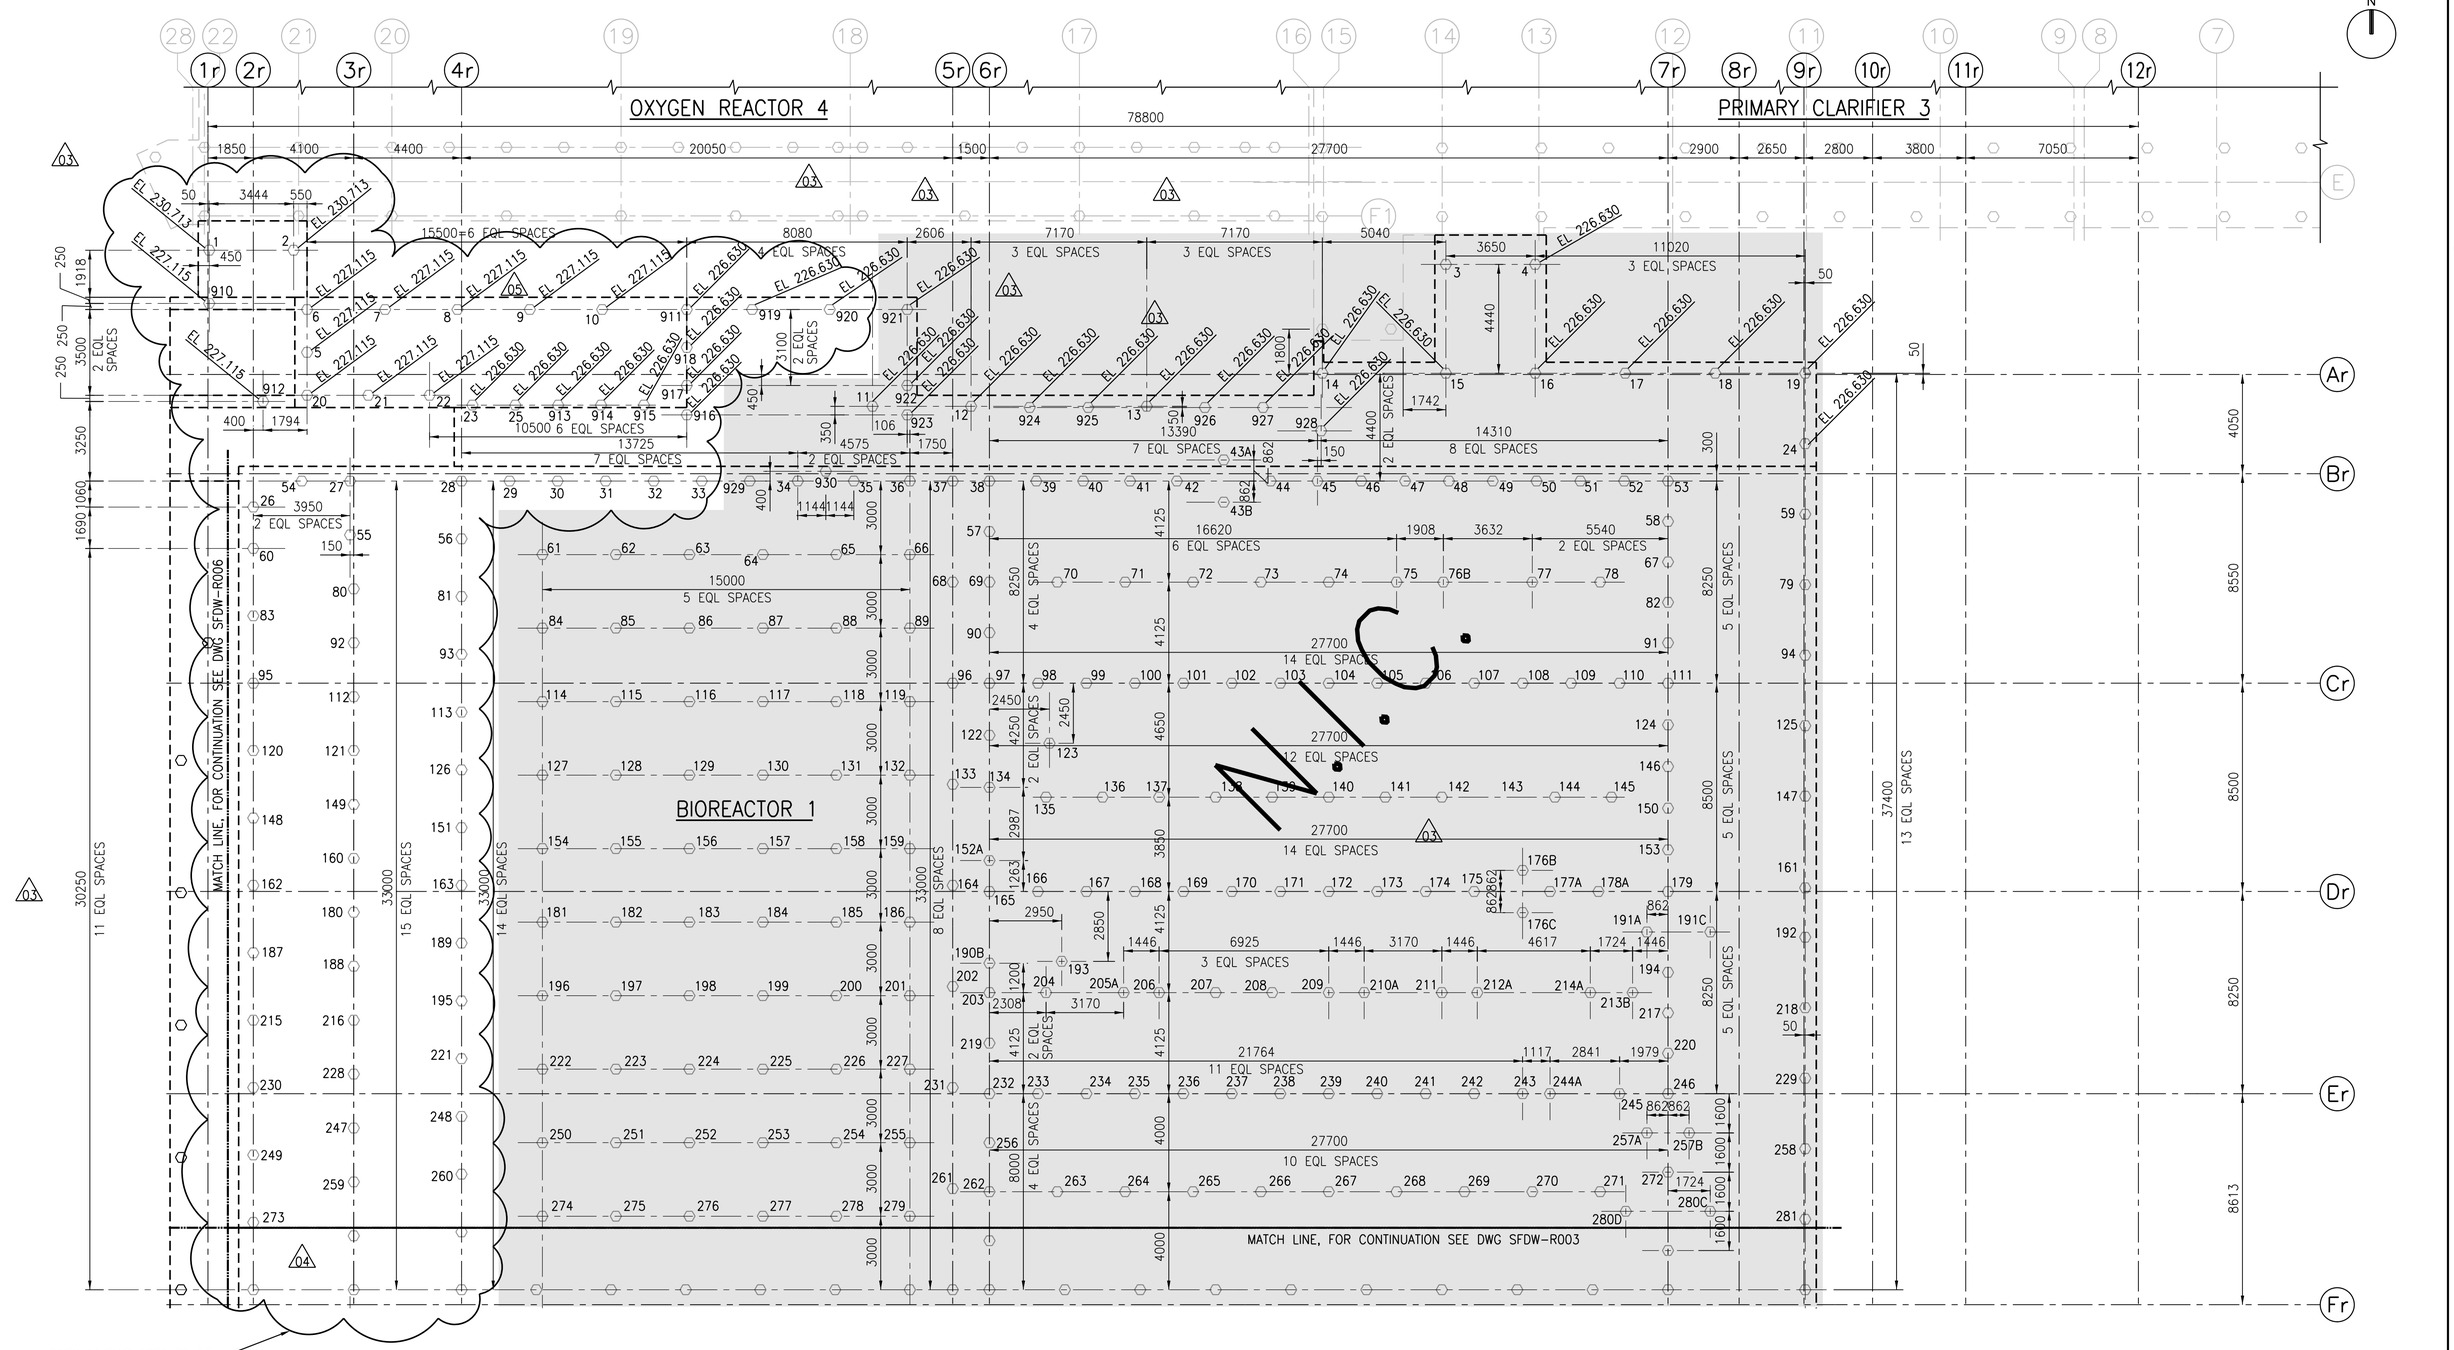

PART PILING PLAN

1:125

NOTES:

1. REFER TO DWG 1-0102-SGAD-A001 FOR GENERAL NOTES.
2. REFER TO DWG 1-0102-SGAD-A002 FOR OVERALL SITE PLAN AND SEQUENCING.
3. PILE DIAMETER (D) = 400mm
4. PILE CUT -OFF ELEVATION = 225.475 UNLESS NOTED OTHERWISE.
5. ESTIMATED PILE REFUSAL EL 210.000
6. ~~TOTAL NUMBER OF PILES IS 937.~~ 03 ~~PILE NUMBER 393 HAS BEEN DELETED.~~ 03
7. GENERAL CONTRACTOR TO VERIFY LOCATION AND CUT OFF ELEVATION OF PILES AND NOTIFY CONTRACT ADMINISTRATOR OF ANY DISCREPANCIES. 04

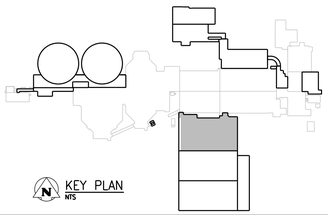

APEGM
Certificate of Authorization
CH2M HILL Canada Ltd.
No. 1441

NO.	REVISIONS	DATE	DESIGN	CHECK
04	ISSUED FOR TENDER - B.O. 899-2015	01/2016	C.R.	B.W.
03	ISSUED FOR FIELD INSTRUCTIONS NO. 43 - NO. 117	10/2015	G.O.	B.W.
02	ISSUED FOR CONSTRUCTION	08/2014	G.O.	B.W.
01	ISSUED FOR ADDENDUM NO. 1	07/2014	G.O.	B.W.
00	ISSUED FOR TENDER	06/2014	G.O.	B.W.

CH2MHILL. KGS GROUP SNC·LAVALIN

DESIGNED BY: E. LUI
CHECKED BY: B. WILLIAMSON
DRAWN BY: G. OMORI
APPROVED BY: E. LUI
SCALE: 1:125
ISSUED FOR CONSTRUCTION
DATE: 2014/06/27
BY: T. TURZAK
DATE: 2016/01/29
CONSULTANT NO.: 474248

ENGINEER'S SEAL
J7/01/2016
PROVINCE OF MANITOBA
S.L.E. LUI
Member 37003
REGISTERED PROFESSIONAL ENGINEER

Winnipeg
THE CITY OF WINNIPEG
WATER AND WASTE DEPARTMENT

SOUTH END WATER POLLUTION CONTROL CENTRE
SEWPCC UPGRADING/EXPANSION PROJECT
STRUCTURAL
BIOREACTORS/BLOWER BUILDING
PART PILING PLAN (1) 03

CITY DRAWING NUMBER	SHEET	REV.	SIZE
1-0102-SFDW-R002	001	04	A1

PLOT DATE: 2016\01\29
FILE NAME: 1-0102-SFDW-R002.dgn

©CH2M HILL 2015. ALL RIGHTS RESERVED.

A1 SIZE - 594mm x 841mm