


No.	DATE	REVISION / ISSUANCE
2	2017.03.10	ISSUED FOR ADDENDUM #1
1	2017.02.17	ISSUED FOR CONSTRUCTION

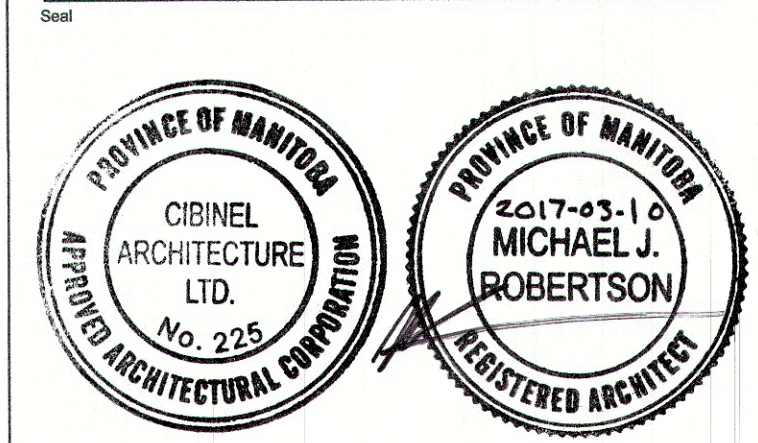

Architect
Cibinel Architecture Ltd
 560 ACADEMY ROAD, WINNIPEG, MB R3N 0E3



Project
TRANSCONA LIBRARY
 1500 PLESSIS ROAD, WINNIPEG, MB

Sheet Title
MAIN FLOOR RCP & DETAILS

Sheet No.
1487

Sheet
A-104


1 MAIN FLOOR REFLECTED CEILING PLAN
 A-104 1:100

GENERAL NOTES


- ALL DIMENSIONS ARE TO FACE OF WALL FINISH OR NEAREST GRIDLINE AND CENTRELINE OF LIGHTING FIXTURES
- MOUNTING HEIGHT / LOCATION OF ALL LIGHT FIXTURES PRIOR TO ROUGH-IN TO BE VERIFIED BY ELEC.
- CENTRE LINEAR RECESSED LIGHT ON PWP REVEAL.

KEYED NOTES


- CONTINUOUS DIFFUSER GRILLE.
- ANODIZED ALUM. ON PLYWOOD SUBSTRATE. REFER TO DETAIL.
- REMOVABLE CEILING PANEL ASSEMBLY. COORDINATE LOCATION WITH MECH.

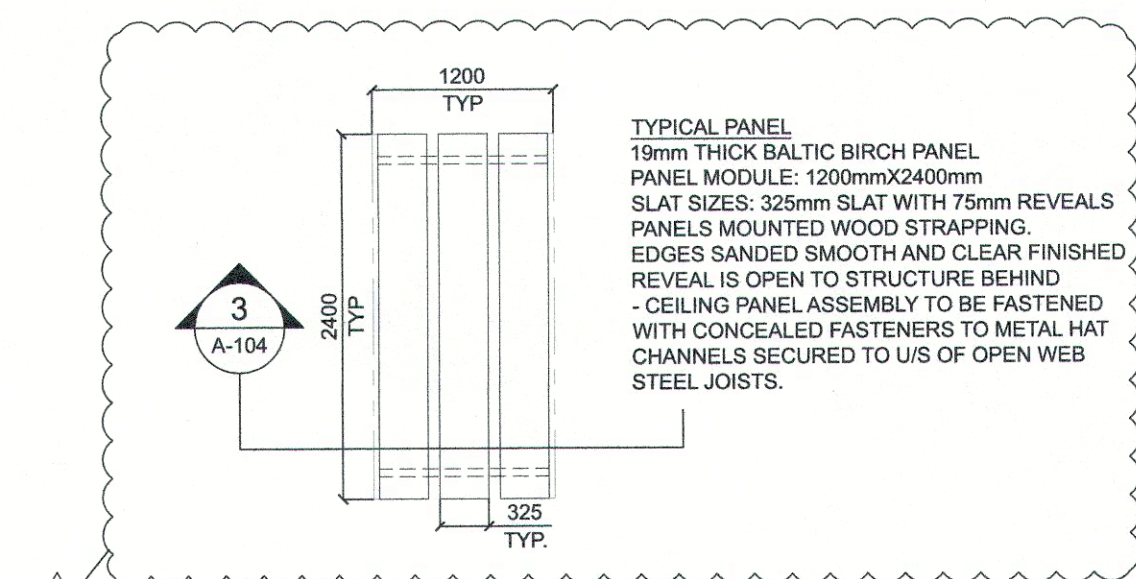

2 CEILING PANEL - TYPICAL
 A-104 1:50

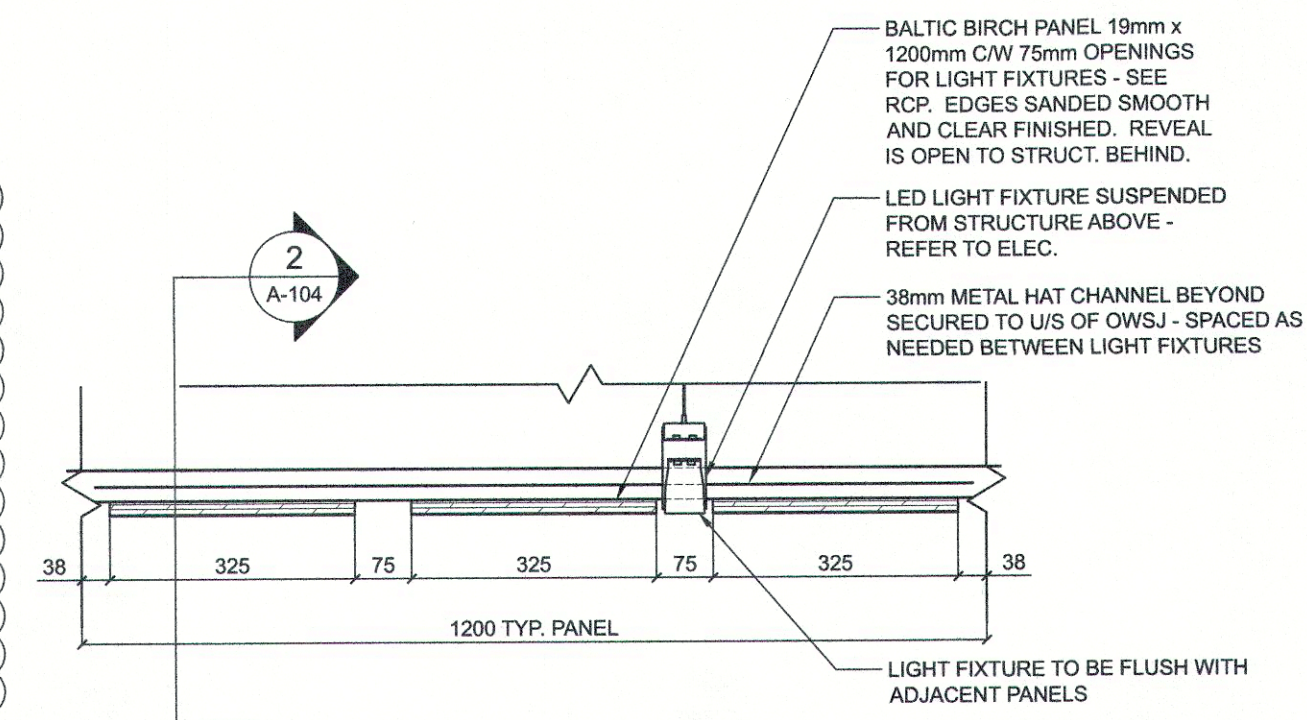

3 CEILING PANEL SECTION - TYPICAL
 A-104 1:10

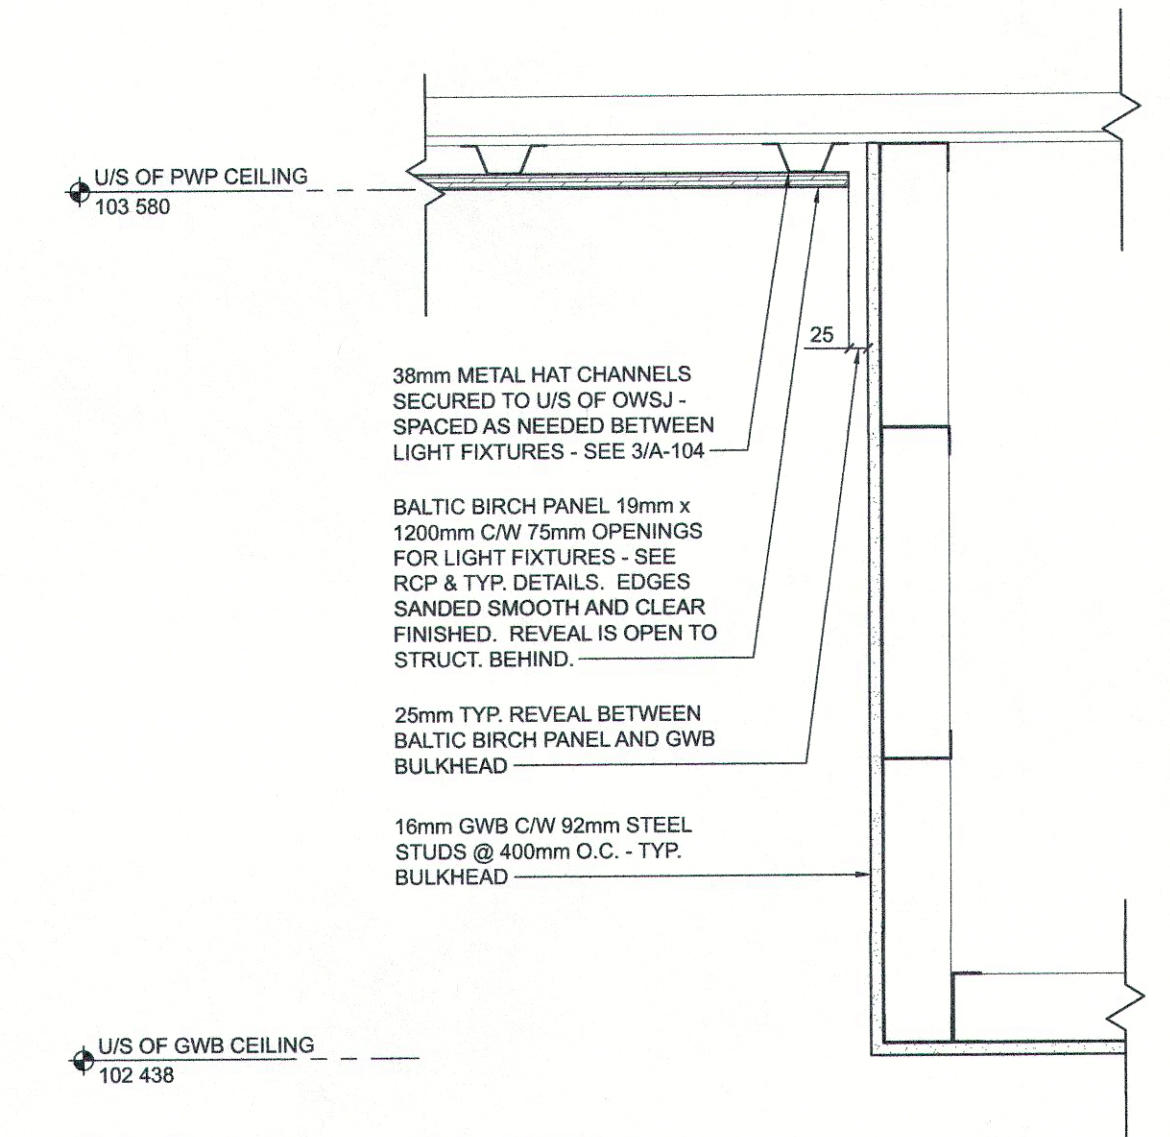

4 TYP. BULKHEAD DETAIL
 A-104 1:10