


issue / rev.

1	2017/01/02	RE-ISSUED FOR CONSTRUCTION
0	2016/12/08	ISSUED FOR CONSTRUCTION
#	date	issue notes

professional seals

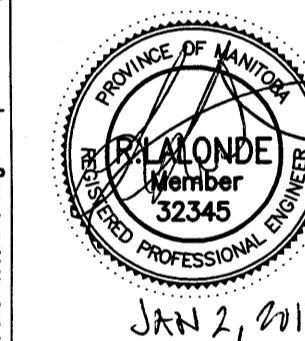

project information

SEVEN OAKS POOL

444 Adsum Drive
Winnipeg, MB
Canada

client

drawing information

ELECTRICAL SINGLE LINE DIAGRAM & LOAD CALCULATIONS

drawn by: GCN

approved by: *[Signature]*

scale: AS NOTED

date issued: 2016.11.23


proj. #: 14-1736-008

rev. #: R-0


SEVEN OAKS POOL RENOVIATION & ADDITION
BID OPPORTUNITY NO. 1044-2016

NOTES:

- GREY LINE WEIGHT DENOTES EXISTING.
- EXISTING LOAD INFORMATION WAS PROVIDED BY HYDRO UP TO JUNE OF 2014. THE VALUE SHOWN WAS DETERMINED FROM THE PEAK VALUE WITHIN A FIVE YEAR RANGE.
- THE ELECTRICAL DISTRIBUTION EQUIPMENT SUPPLIER SHALL PROVIDE AN ARC FLASH STUDY AND UV/WATER RESISTANT VINYL LABELS FOR ALL NEW EQUIPMENT. CONTRACTOR SHALL COORDINATE INSTALLED CABLE LENGTHS AND SIZES WITH THE VENDOR.
- PANELS A,B,C, AND E SHALL BE REPLACED WITH NEW PANELS TO MATCH EXISTING. NEW PANELS SHALL BE RELOCATED IN THE MEZZANINE. EXTEND ALL EXISTING CIRCUITS TO NEW PANEL LOCATION.
- INDICATED RUNS SHALL HAVE 100% SPACING BETWEEN CONDUITS. CONTRACTOR SHALL MOUNT NEW CONDUITS TO BASEMENT CEILING AS REQUIRED C/W A UNISTRUT AND P-CLAMO CONSTRUCTION. ALL STRUTS SHALL BE SUPPORTED TO THE CONCRETE DIRECTLY OR IN A TRAPEZE METHOD.
- CABLE SIZED ACCORDING TO CEC TABLE D8A. INSTALL CABLES IN ACCORDANCE WITH DETAIL 5 OF DIAGRAM D8.
- PROVIDE INFORMATION METERING ON THE SIX (6) BRANCHES INDICATED. METERING SHALL BE SQUARE D POWER LOGIC 5000 SERIES. REFER TO SPEC SECTION 26 24 13 FOR DETAILS.
- INDICATED CABLES SHALL BE C/W 1000V RATED INSULATION.
- N/A.
- PANEL SD-1 SHALL BE A 30 CIRCUIT PANEL.
- PROVIDE AND INSTALL A NEW OUTDOOR PAD MOUNT CSTE.
- ELECTRICAL CONTRACTOR SHALL BE RESPONSIBLE FOR TRENCHING AND RETURNING SITE TO EXISTING CONDITIONS.

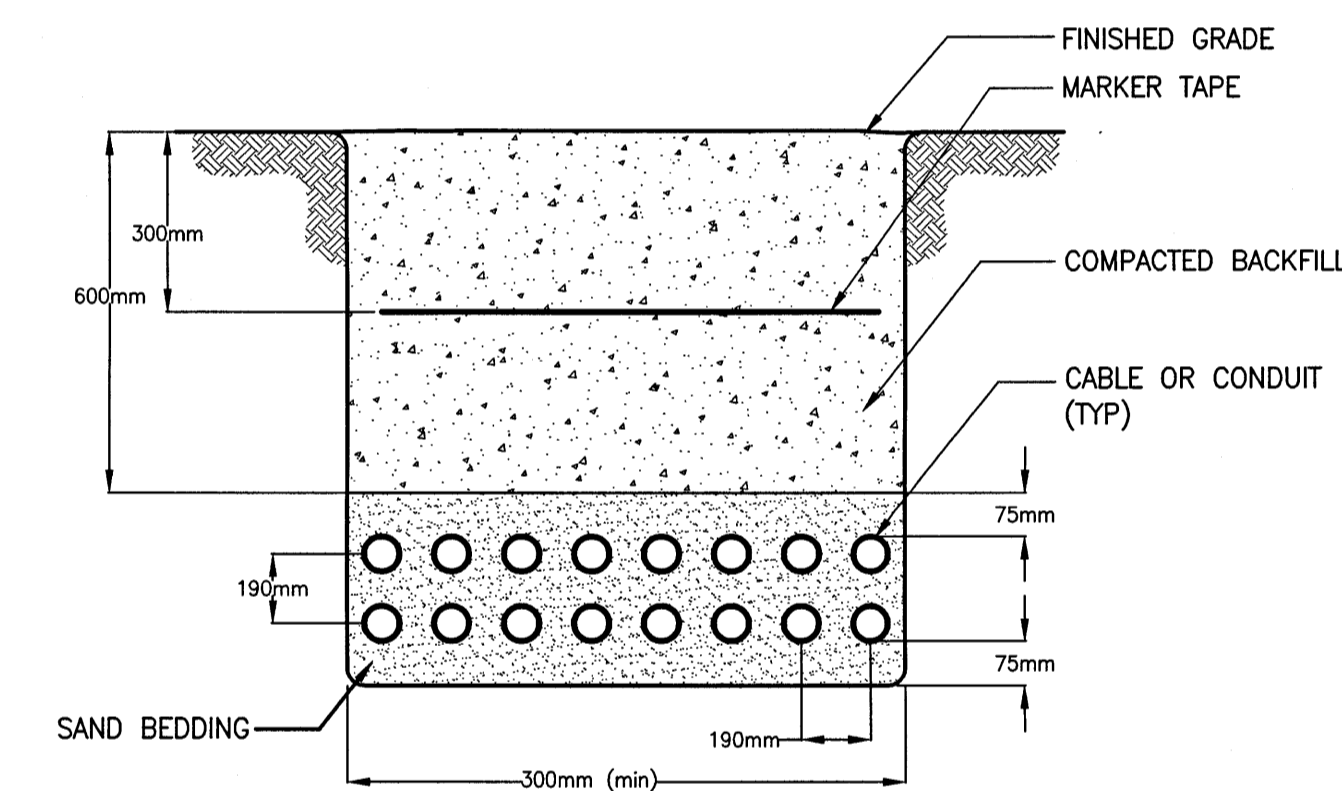

(B) CABLE TRENCH DETAIL
SCALE: N.T.S. (NOTE 12)

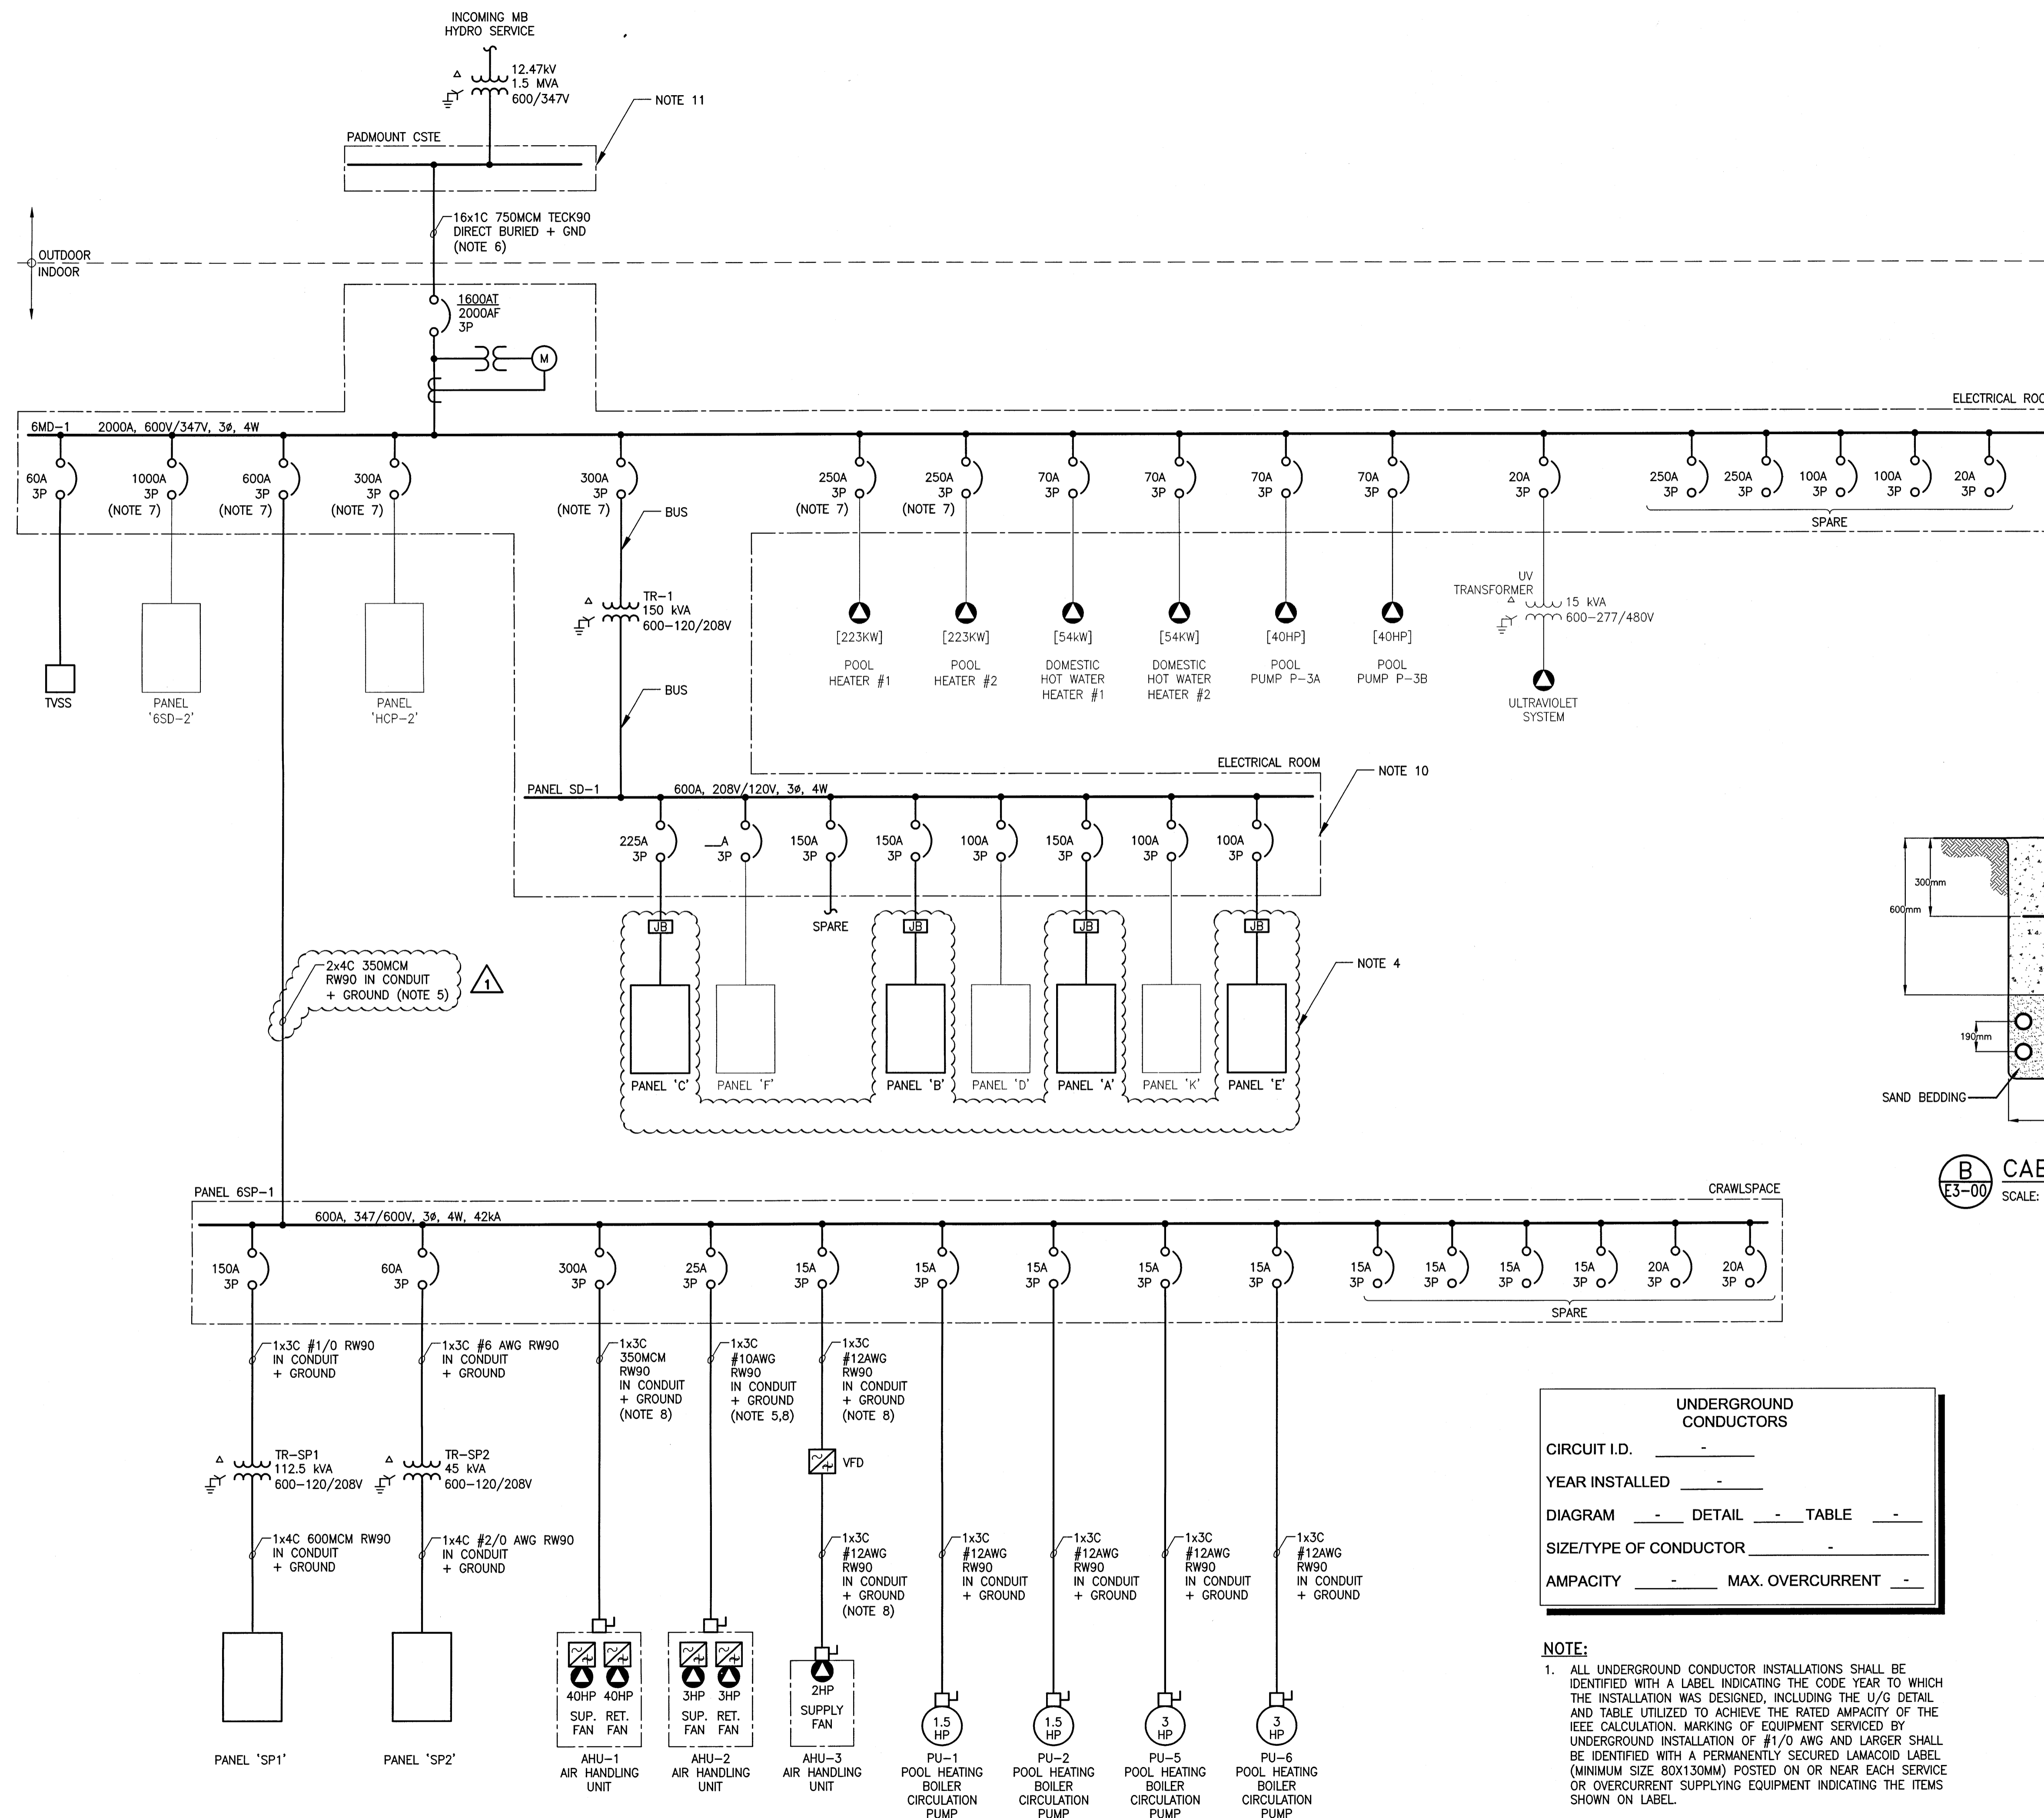

(1) SINGLE LINE DIAGRAM - NEW
SCALE: N.T.S.

(A) BURIED CABLE LAMACOID LABEL
SCALE: N.T.S.

UNDERGROUND CONDUCTORS

CIRCUIT I.D. _____

YEAR INSTALLED _____

DIAGRAM _____ DETAIL _____ TABLE _____

SIZE/TYPE OF CONDUCTOR _____

AMPACITY _____ MAX. OVERCURRENT _____

- NOTE:**
- ALL UNDERGROUND CONDUCTOR INSTALLATIONS SHALL BE IDENTIFIED WITH A LABEL INDICATING THE CODE YEAR TO WHICH THE INSTALLATION WAS DESIGNED, INCLUDING THE U/G DETAIL AND TABLE UTILIZED TO ACHIEVE THE RATED AMPACITY OF THE IEEE CALCULATION. MARKING OF EQUIPMENT SERVICED BY UNDERGROUND INSTALLATION OF #1/0 AWG AND LARGER SHALL BE IDENTIFIED WITH A PERMANENTLY SECURED LAMACOID LABEL (MINIMUM SIZE 80X130MM) POSTED ON OR NEAR EACH SERVICE OR OVERCURRENT SUPPLYING EQUIPMENT INDICATING THE ITEMS SHOWN ON LABEL.

LOAD CALCULATION

EXISTING FACILITY DEMAND LOAD	= 770kVA
ESTIMATED NEW ADDITION LOAD	= 304kVA
FUTURE (25%)	= 268kVA
ESTIMATED TOTAL LOAD	= 1342kVA

FAULT CURRENT CALCULATION

* 1500kVA TRANSFORMER: Z = 4%		
* 150kVA TRANSFORMER: Z = 1.8%		
208V SYSTEM SHORT CIRCUIT AMPACITY	$\frac{1}{\sqrt{3} \left(\frac{1.8\%}{150kVA} \right) 208} = 23.13kA$	PROVIDE 18kA MINIMUM
600V SYSTEM SHORT CIRCUIT AMPACITY	$\frac{1}{\sqrt{3} \left(\frac{4\%}{1500kVA} \right) 600} = 36.10kA$	PROVIDE 42kA MINIMUM
	$\frac{1}{\left(\frac{1}{23.13kA} \right) + \left(\frac{1}{36.10kA} \right)} = 14.10kA$	