





KEY NOTES

- 1 CONCENTRIC VENTING KIT; INSTALL IN ACCORDANCE WITH THE MANUFACTURER'S RECOMMENDATIONS
- 2 UNIT HEATER TO BE INSTALLED AT HIGH LEVEL
- 3 NEW IN-FLOOR CIRCULATION PUMPS ARE OPERATED IN DUTY/STANDBY CONFIGURATION. PUMPS COMPLETE WITH SHUTOFF VALVES, FLEXIBLE CONNECTIONS, STRAINER, AND CHECK VALVES.
- 4 DROP PIPING FOR CHILLER TO LOW LEVEL; PROVIDE WALL BRACKETING AND SUPPORTS FOR PIPING ALONG THE GROUND TO THE CHILLER.
- 5 RUN PIPING AT HIGH LEVEL; OVER AIR HANDLER DUCTING.
- 6 MECHANICAL ROOM VENTILATION INLET DUCT FROM LOUVER; MOTORIZED DAMPER TO BE PLACED AS CLOSE TO LOUVER AS POSSIBLE AND BE CONTROLLED BY THE DDC. INTERLOCK DAMPER OPERATION WITH EF-1 OPERATION.
- 7 DUCT DISTRIBUTION TO BE CLOSE TO UNDERSIDE OF STRUCTURE. ENSURE DUCT AND INSULATION ARE NOT IN CONTACT WITH THE STRUCTURE.
- 8 PROVIDE NEW LOUVER COMPLETE WITH FULLY SEALED AND INSULATED PLENUM. PLENUM SHALL SAME DIMENSIONS AS LOUVER OPENING. CONNECT DUCTWORK TO PLENUM AND PROVIDE SEPARATE INSULATED MOTORIZED DAMPERS FOR EACH CONNECTION.

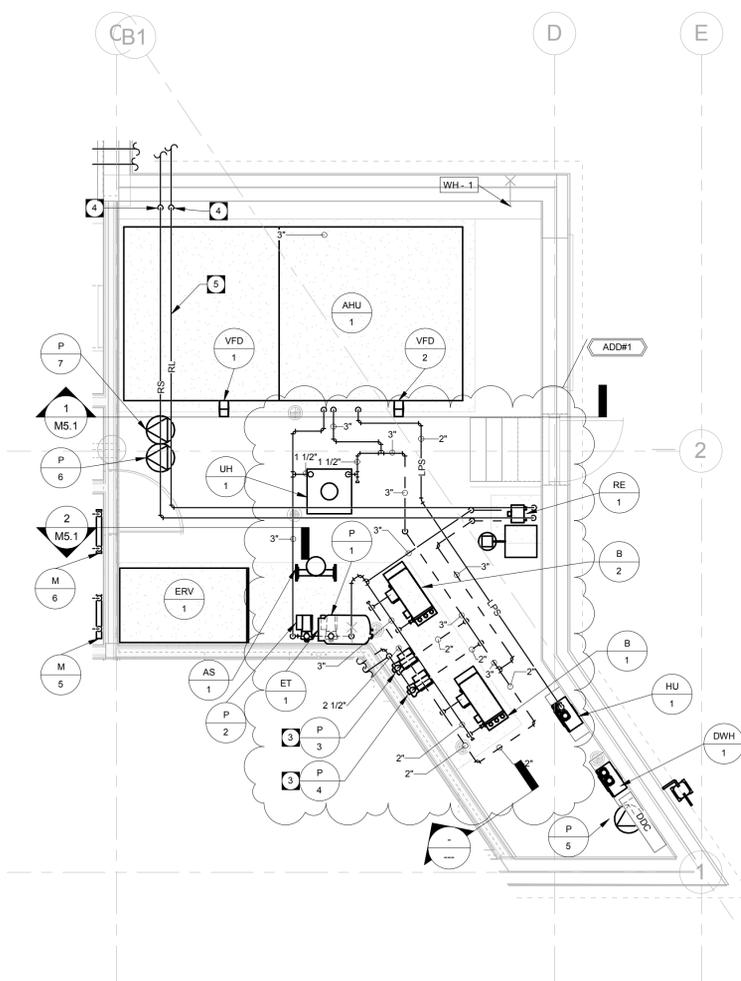

1 LARGE SCALE PLAN - MAIN HYDRONIC
 M3.1 SCALE: 1/4" = 1'-0"

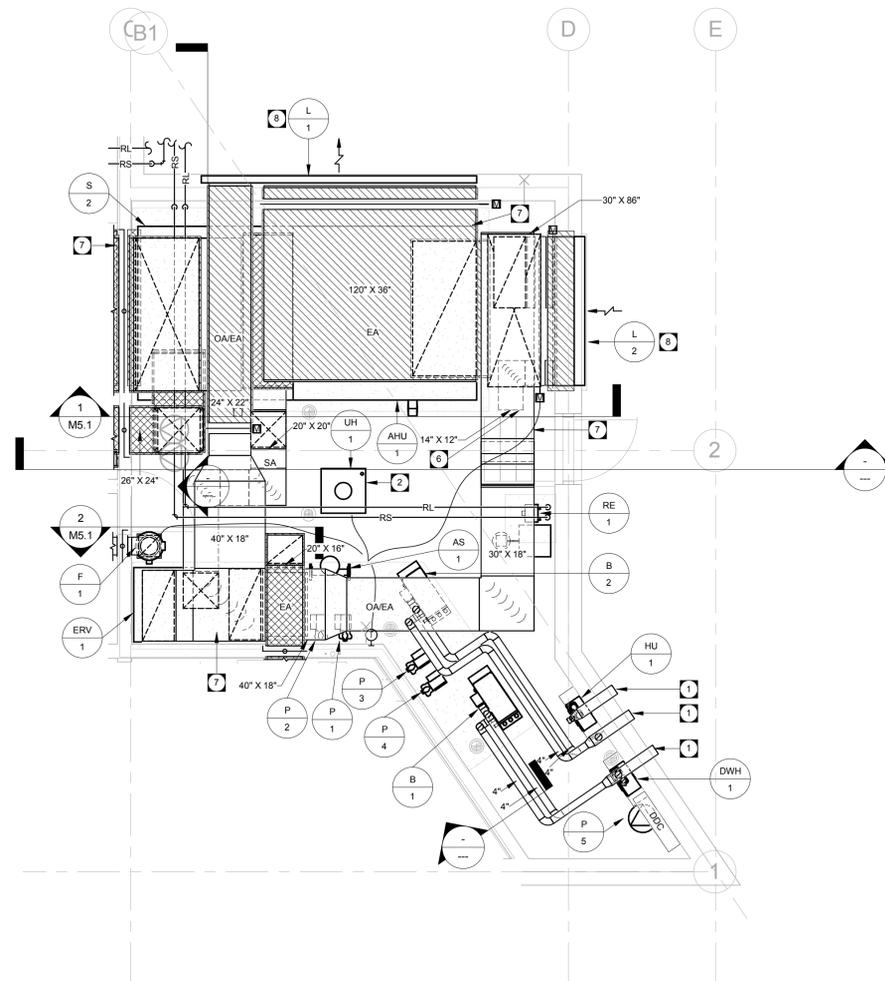

2 LARGE SCALE PLAN - MAIN HVAC
 M3.1 SCALE: 1/4" = 1'-0"

epp siepman engineering inc.
 mechanical & electrical engineers
 303-100 Osborne St. South
 Winnipeg, MB R3L 1Y5
 p 204-453-1080
 ese@eppsiepman.com

- 1 16-04-20 Issued with Addendum #1
- 2 16-03-31 Issued for Construction

THIS DRAWING IS THE EXCLUSIVE PROPERTY OF HS ARCHITECTURE AND DAVID PENNER ARCHITECT AND MAY NOT BE REPRODUCED AND/OR USED IN ANY MANNER WITHOUT THEIR EXPRESSED WRITTEN PERMISSION. THE GENERAL CONTRACTOR AND MATERIALS SUPPLIERS SHALL CHECK ALL DIMENSIONS AND INFORMATION ON THIS DRAWING AND REPORT ANY DISCREPANCIES PRIOR TO COMMENCEMENT OF WORK. DO NOT SCALE THIS DRAWING.

OWNER

 CITY OF WINNIPEG - PLANNING, PROPERTY & DEVELOPMENT DEPARTMENT
 MUNICIPAL ACCOMMODATIONS DIVISION
 3rd FLOOR - 65 GARRY ST., WPG, R3C 4K4

david penner
 ARCHITECT
 +
h5a
 h5 architecture

David Penner, 204.475.8978
 Hello Rodrigues, 204.774.0012
 120 Yale Avenue, Winnipeg, MB, R3M 0L7

PROJECT
 Windsor Park Library
ADDRESS
 1201 Archibald Street

DATE
 April 20, 2016

SCALE
 1/4" = 1'-0"

large scale plan
M3.1