


POOL PLUMBING LAYOUT

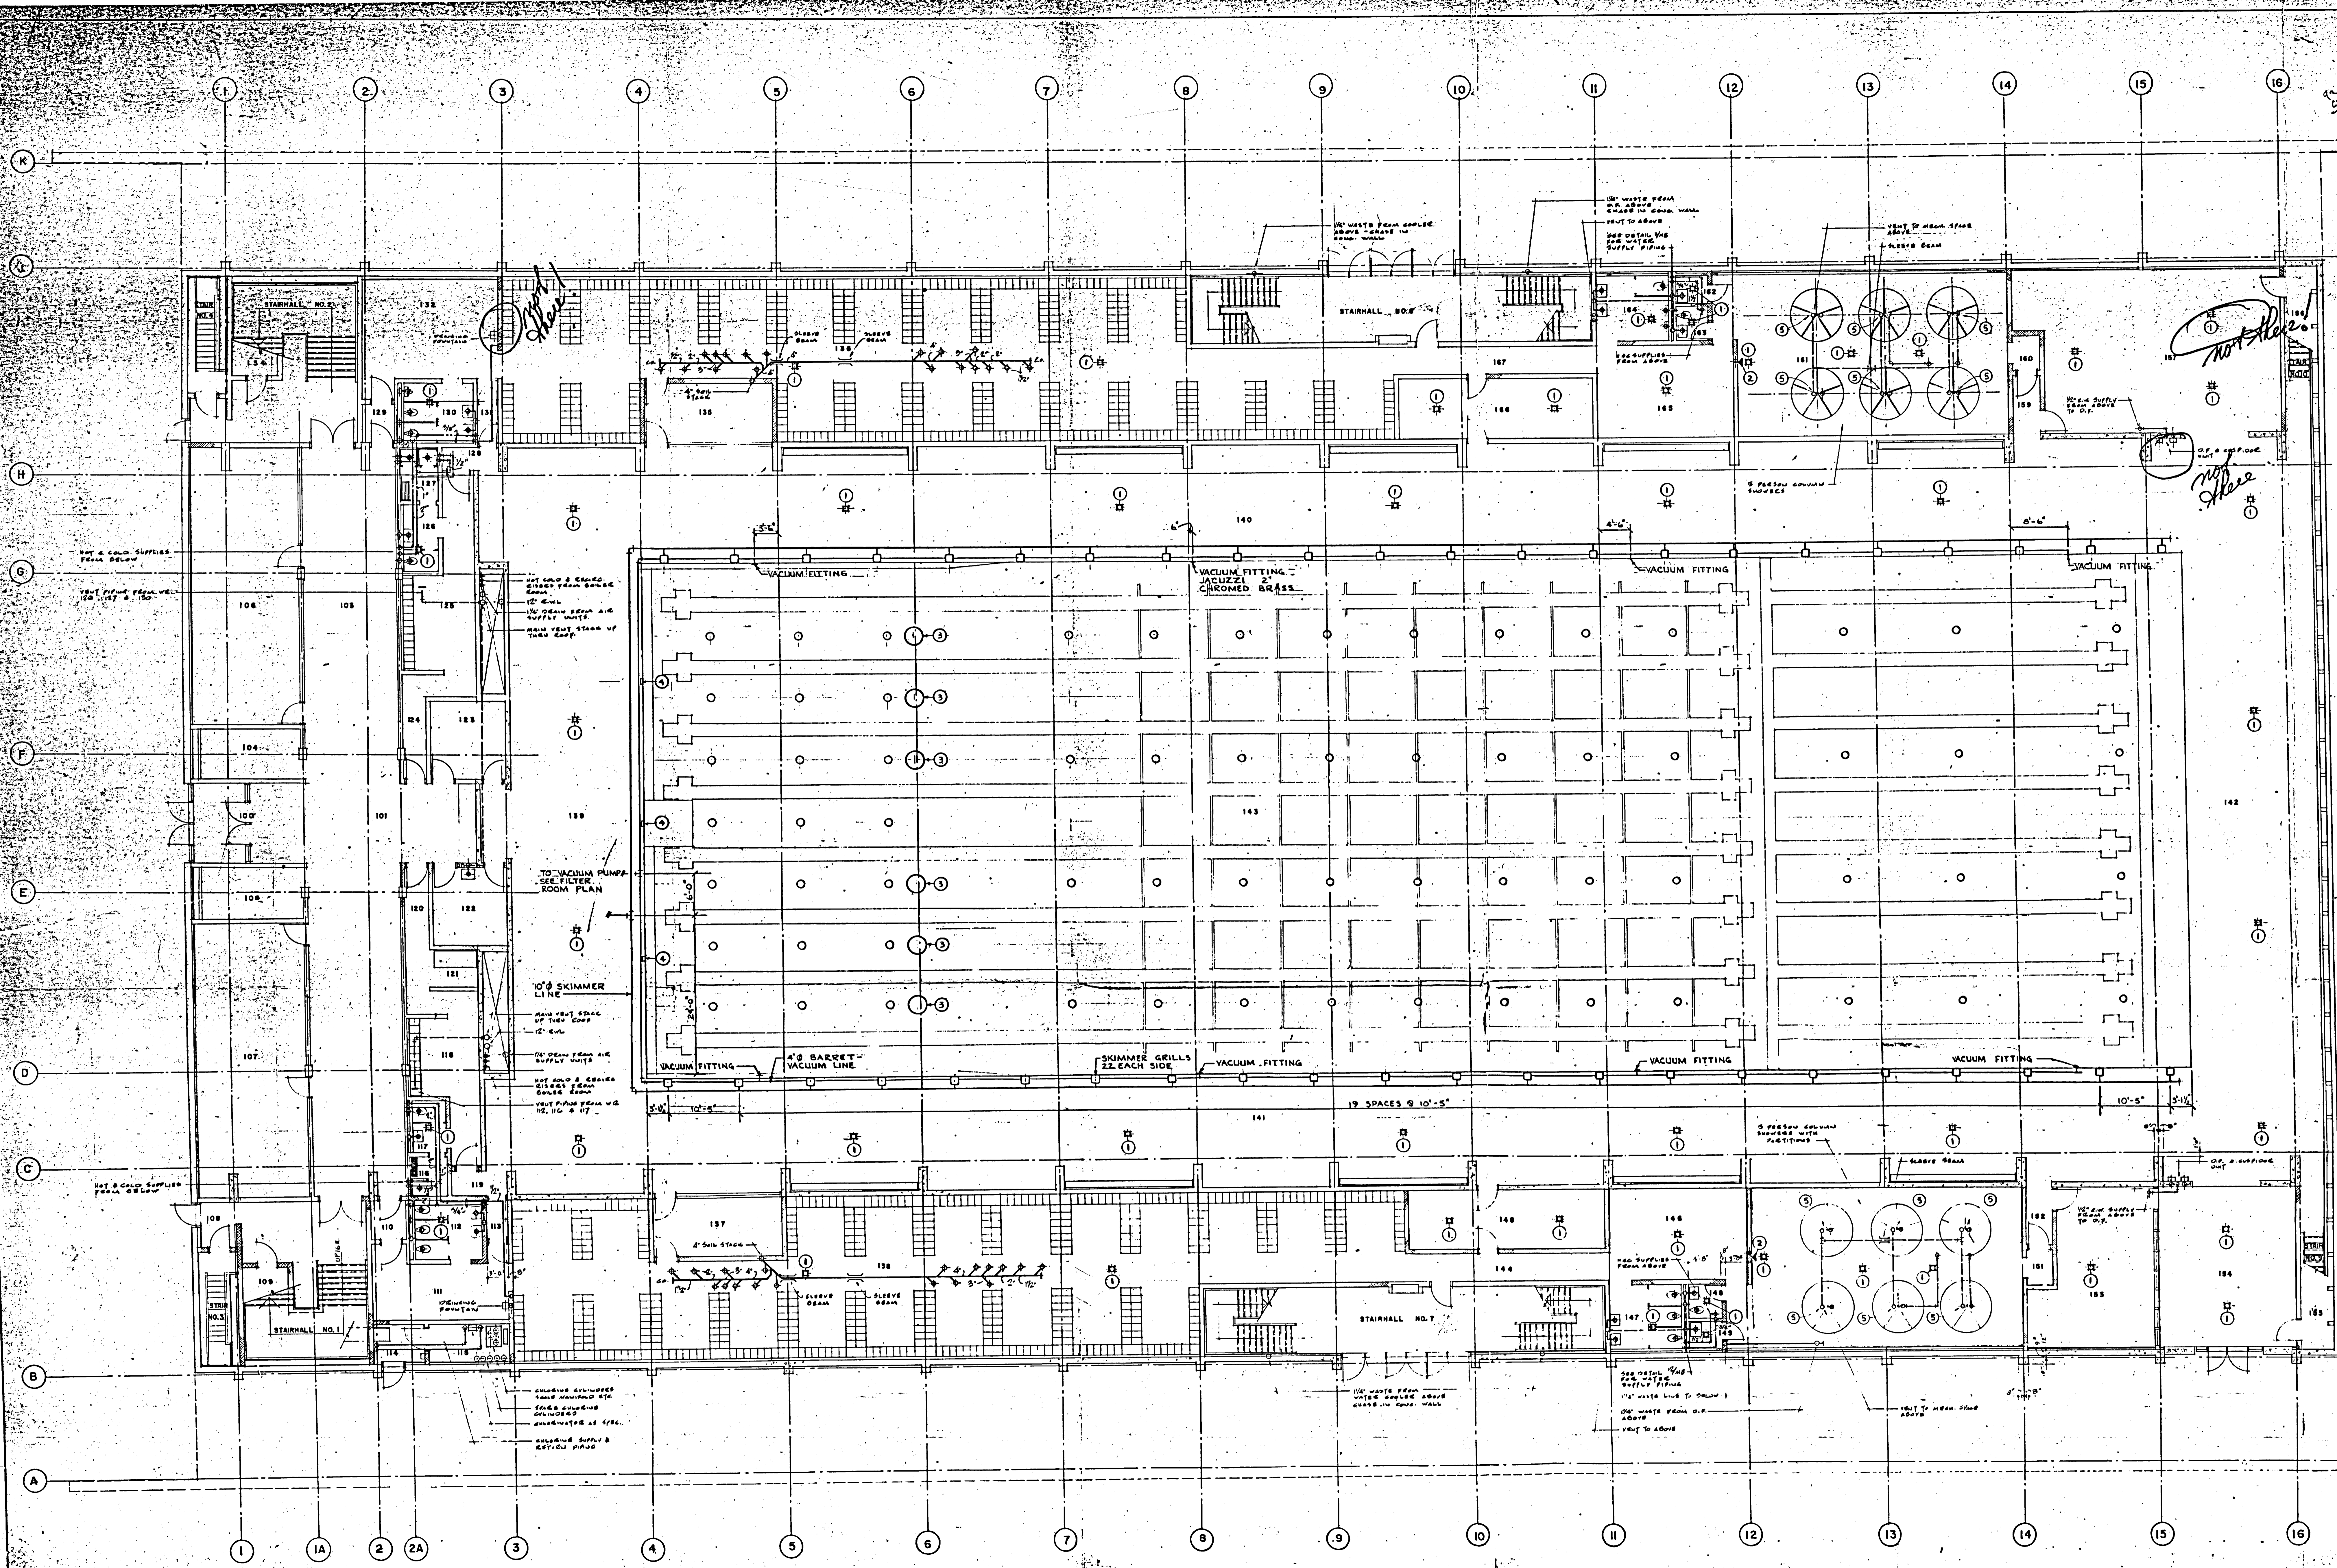

- LEGEND
- 1 FLOOR DRAIN TYPE-1
  - 2 COLD WATER SHOWER
  - 3 MAIN POOL DRAIN
  - 4 DRAIN TOWER W/ST FITTING
  - 5 VENT FROM COLUMN SHOWER TRANSFERRED W/ST TO ANNUUM SHOWER
- NOTE
- \* SEE SHEET A-16 FOR FLOOR DRAIN SCHEDULE FOR RESTROOMS, SHOWERS & FITTINGS & ACCESSORY SCHEDULE

**AS-BUILT DRAWING**  
 THIS DRAWING IS REVISED TO SHOW AS-BUILT

NO.	REV.	DESCRIPTION	DATE	BY

SMITH CARTER SEARLE ASSOCIATES  
 ARCHITECTS AND CONSULTING ENGINEERS  
 WINNIPEG BRANCON PORT ARTHUR TORONTO

PROFESSIONAL ENGINEER  
 CURRIE  
 REGISTERED ARCHITECT  
 SMITH  
 REGISTERED ENGINEER

**B-14 FILE**  
 REVIEWED BY  
 H. J. WILSON  
 INVENTORY  
 301C



PAN-AMERICAN GAMES  
 SWIMMING FACILITY  
 WINNIPEG, MANITOBA

POOL DECK LEVEL  
 PLUMBING LAYOUT  
 SCALE  
 1/8" = 1' - 0"

PROJECT NUMBER  
**65080**  
 SHEET NUMBER  
**M-2**