


POOL DECK HEATING & VENTILATION

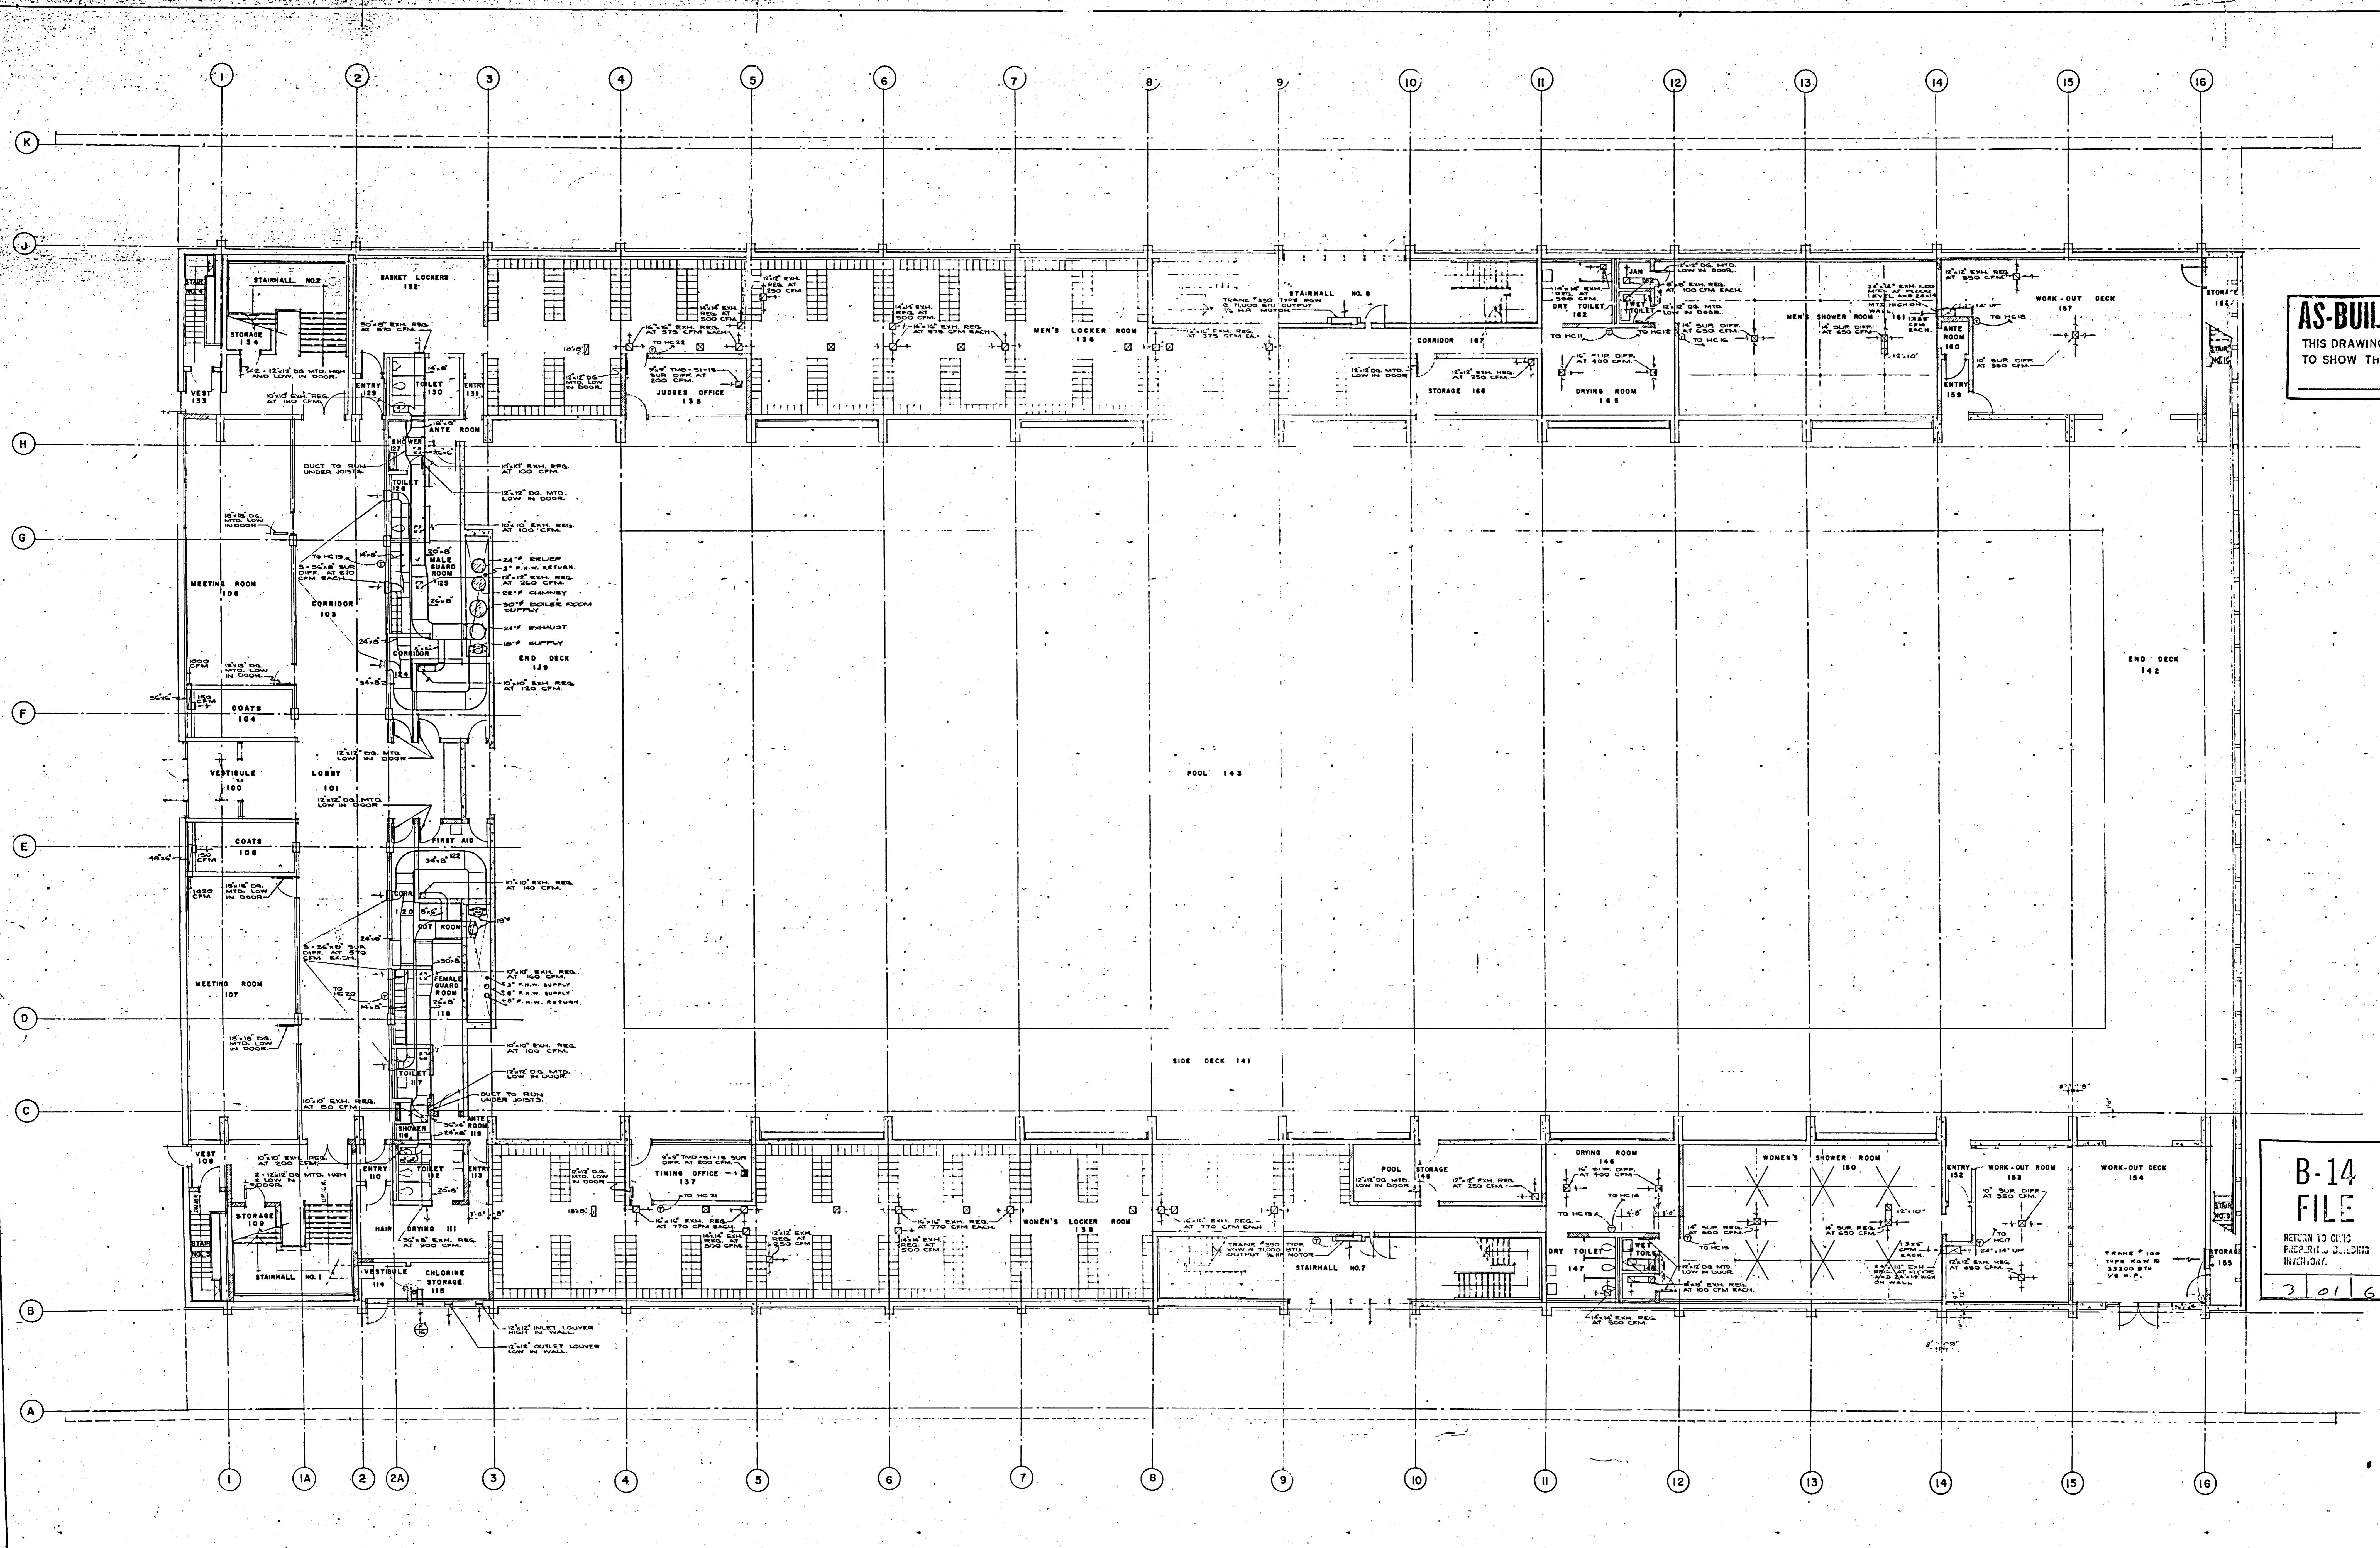

AS-BUILT DRAWING
THIS DRAWING HAS BEEN REVISED
TO SHOW THE BUILDING AS-BUILT

NO.	REV.	DESCRIPTION	DATE

DRAWN BY: *[Signature]*
 CHECKED BY: *[Signature]*
 APPROVED BY: *[Signature]*
 DATE: *[Date]*

PROVINCE OF MANITOBA
G. H. CURRIE
REGISTERED ENGINEER

PROVINCE OF MANITOBA
SMITH, CARTER, SEARLE
REGISTERED ARCHITECTS

SMITH CARTER SEARLE ASSOCIATES
ARCHITECTS AND CONSULTING ENGINEERS
WINNIPEG BRANDON PORT ARTHUR TORONTO

B-14 FILE
RETURN TO CHIEF
PROPERTY CLERK
WINNIPEG
3016



PAN-AMERICAN GAMES
SWIMMING FACILITY
WINNIPEG, MANITOBA

POOL DECK LEVEL
HEATING & VENTILATION

SCALE: 1/8" = 1'-0"

FILE NUMBER: 65080 SHEET NUMBER: M-3