


G:\CAD\163353\Technical\Workspaces\Engineering\Drawings and Figures\Roadworks\Contract\163353-C2-CON-GE-STAGE-3.1.dwg

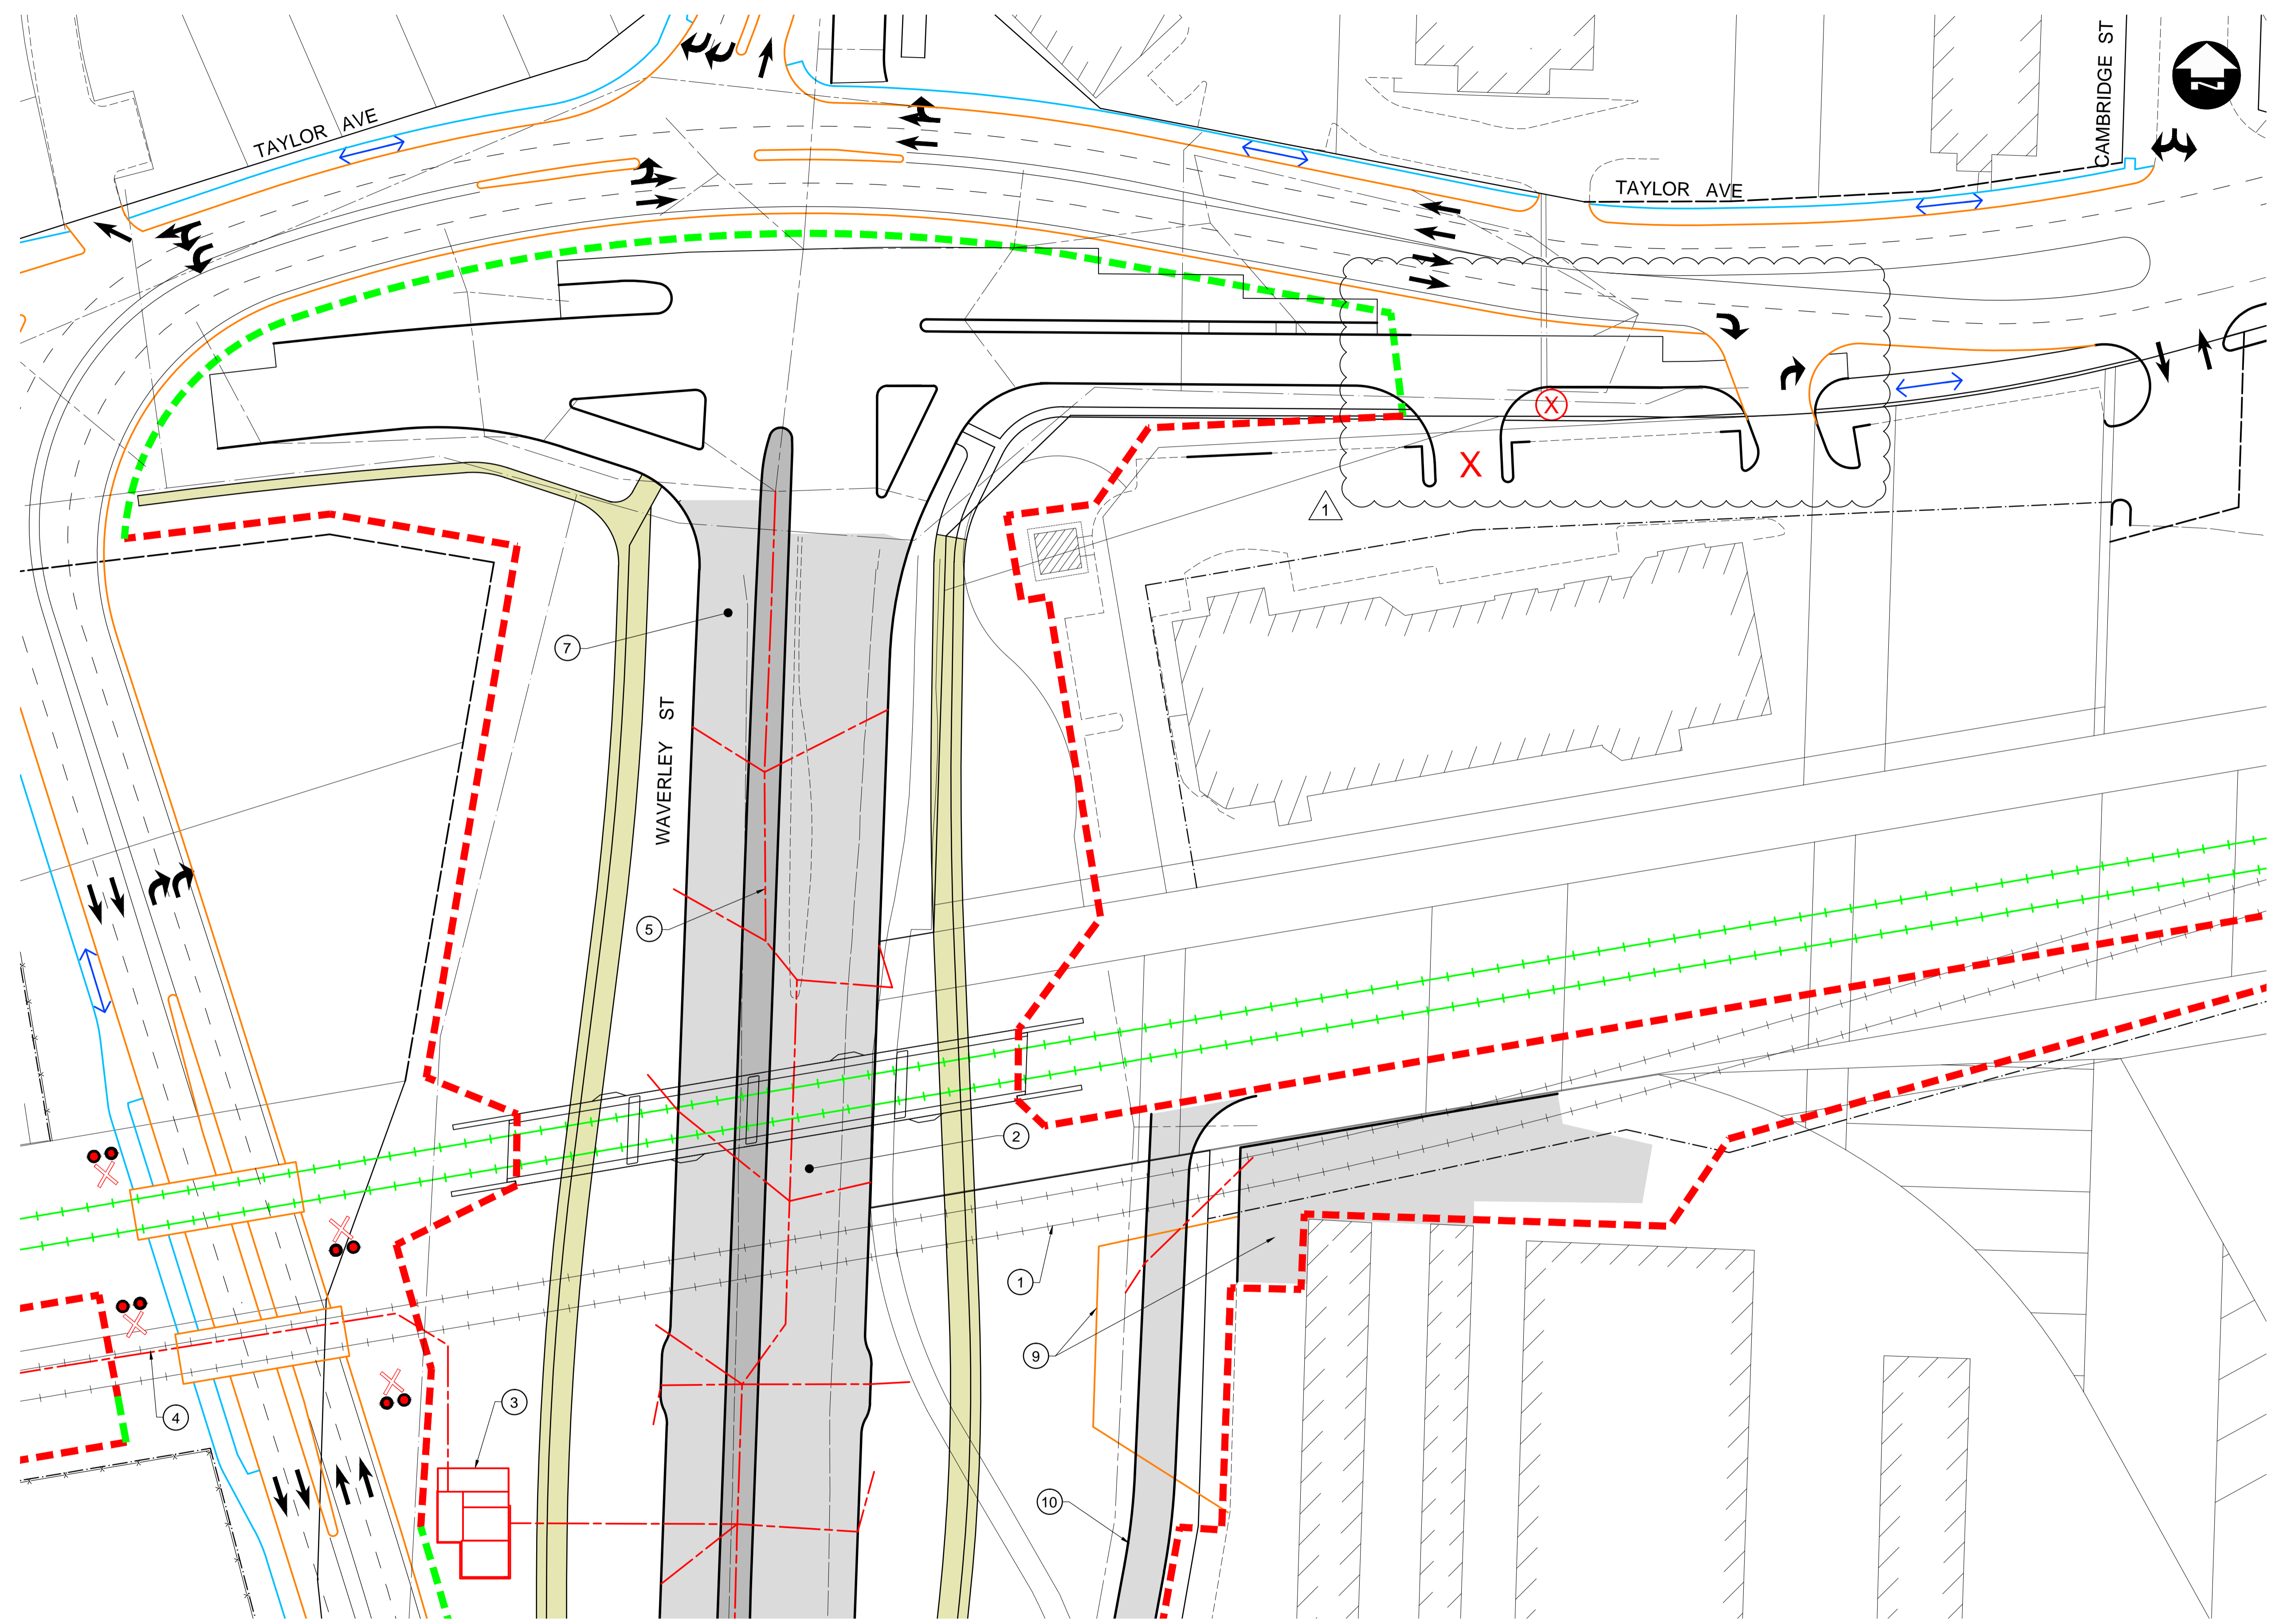

- PHASE III - STAGE 1 NOTES:**
- SUGGESTED SCHEDULE**
- 10 MONTHS
 - NOVEMBER (2018) TO SEPTEMBER (2019)
- MAJOR CONSTRUCTION ACTIVITIES**
1. DECOMMISSION RAILWAY SHOOFLY TRACKS PRIOR TO EXCAVATION (BY OTHERS)
 2. EXCAVATION OF UNDERPASS
 3. CONSTRUCTION OF LDS PUMPING STATION CONTINUES
 4. CONSTRUCTION OF LDS ALONG FORMER SHOOFLY FROM PUMPING STATION TO RETENTION POND SRB 6-22
 5. CONSTRUCTION OF LDS PARALLEL TO WAVERLEY AND UNDERPASS LDS
 6. CONSTRUCTION OF MEDIAN SEGMENT ON HURST
 7. CONSTRUCTION OF WAVERLEY ROADWAY SEGMENTS FROM WILKES TO TAYLOR/WAVERLEY INTERSECTION
 8. REHABILITATION OF WESTBOUND TAYLOR AND ASSOCIATED DRAINAGE WORKS
 9. REMOVE TEMPORARY TRUCK TURNAROUND AREA AND RESTORE PARKING LOT AT 830 WAVERLEY STREET
 10. CONSTRUCTION OF EAST CN SERVICE ROAD AND ASSOCIATED DRAINAGE WORKS
- TRAFFIC AND PEDESTRIAN CONTROL**
- TRAFFIC AND PEDESTRIANS ALONG DETOUR ROADWAY
 - ALL RAIL TRAFFIC ON PERMANENT TRACKS
 - TAYLOR WEST OF WAVERLEY TRAFFIC MOVED TO THE FUTURE EASTBOUND LANES
 - ALL 4 LANES OF TAYLOR OPEN AT END OF PHASE III - STAGE 1
 - THE FOLLOWING STREETS MUST HAVE TWO THROUGH LANES OPEN DURING THE SPECIFIED WEEKDAY PEAK PERIOD:
 - (7:00 - 9:00 & 15:30 - 17:30) NORTHBOUND DETOUR BETWEEN VICTOR LEWIS AND CAMBRIDGE
 - (15:30 - 17:30) SOUTHBOUND DETOUR BETWEEN CAMBRIDGE AND VICTOR LEWIS
 - (15:30 - 17:30) SOUTHBOUND WAVERLEY BETWEEN MATHERS AND TAYLOR



LEGEND - CONSTRUCTION STAGING		VEHICULAR TRAFFIC	
	ACTIVE RAILWAY		VEHICULAR TRAFFIC
	INACTIVE RAILWAY		PEDESTRIAN/CYCLIST TRAFFIC
	SHOOFLY CONSTRUCTION		LANE CLOSED
	PERMANENT RAILWAY CONSTRUCTION		SIDEWALK CLOSED
	MAJOR UNDERGROUNDS CONSTRUCTION		TEMPORARY CROSSING SIGNALS
	EXISTING PROPERTY LINE		
	PROPOSED PROPERTY LINE		
	CONSTRUCTION EASEMENT		
	TEMPORARY ROADWAY CONSTRUCTION		
	PERMANENT ROADWAY CONSTRUCTION		
	PERMANENT MEDIAN CONSTRUCTION		
	TEMPORARY SIDEWALK/MUP CONSTRUCTION		
	PERMANENT SIDEWALK/MUP CONSTRUCTION		
	BRIDGE CONSTRUCTION		
	CONTRACTOR LAYDOWN AREA - ACCESS		
	CONTRACTOR LAYDOWN AREA - NO ACCESS		

UNDERGROUND STRUCTURES	
SUPPLY, U/G STRUCTURES	DATE

LOCATION OF UNDERGROUND STRUCTURES AS SHOWN ARE BASED ON THE BEST INFORMATION AVAILABLE, BUT NO GUARANTEE IS GIVEN THAT ALL EXISTING UTILITIES ARE SHOWN OR THAT THE GIVEN LOCATIONS ARE EXACT. CONFIRMATION OF EXISTENCE AND EXACT LOCATION OF ALL SERVICES MUST BE OBTAINED FROM THE INDIVIDUAL UTILITIES BEFORE PROCEEDING WITH CONSTRUCTION.

B.M. ELEV.			

DESIGNED BY	TJH	CHECKED BY	RTP/DBW
DRAWN BY	TJH	APPROVED BY	DBW

ENGINEER'S SEAL
CONSULTANT PROJECT NUMBER
16-3353

		THE CITY OF WINNIPEG PUBLIC WORKS DEPARTMENT	
WAVERLEY STREET UNDERPASS AT CN MILE 3.89 RIVERS SUB CONTRACT 2: UNDERPASS STRUCTURE, RAILWORKS, ROADWORKS, LAND DRAINAGE SEWER, PUMPING STATION AND LANDSCAPING WORKS		CITY DRAWING NUMBER U-239-2016-C2-GE-044	
CONSTRUCTION STAGING PHASE III - STAGE 1 (2 OF 3)		SHEET OF 044 OF 052	
CONSULTANT DRAWING NUMBER C2-GE-044		CONSULTANT DRAWING NUMBER C2-GE-044	