


G:\CAD\163353\Technical\Workspaces\Engineering\Drawings and Figures\Roadworks\Contract\163353-C2-CON-C1-CONTROL-LINE-GEOMETRY.dwg

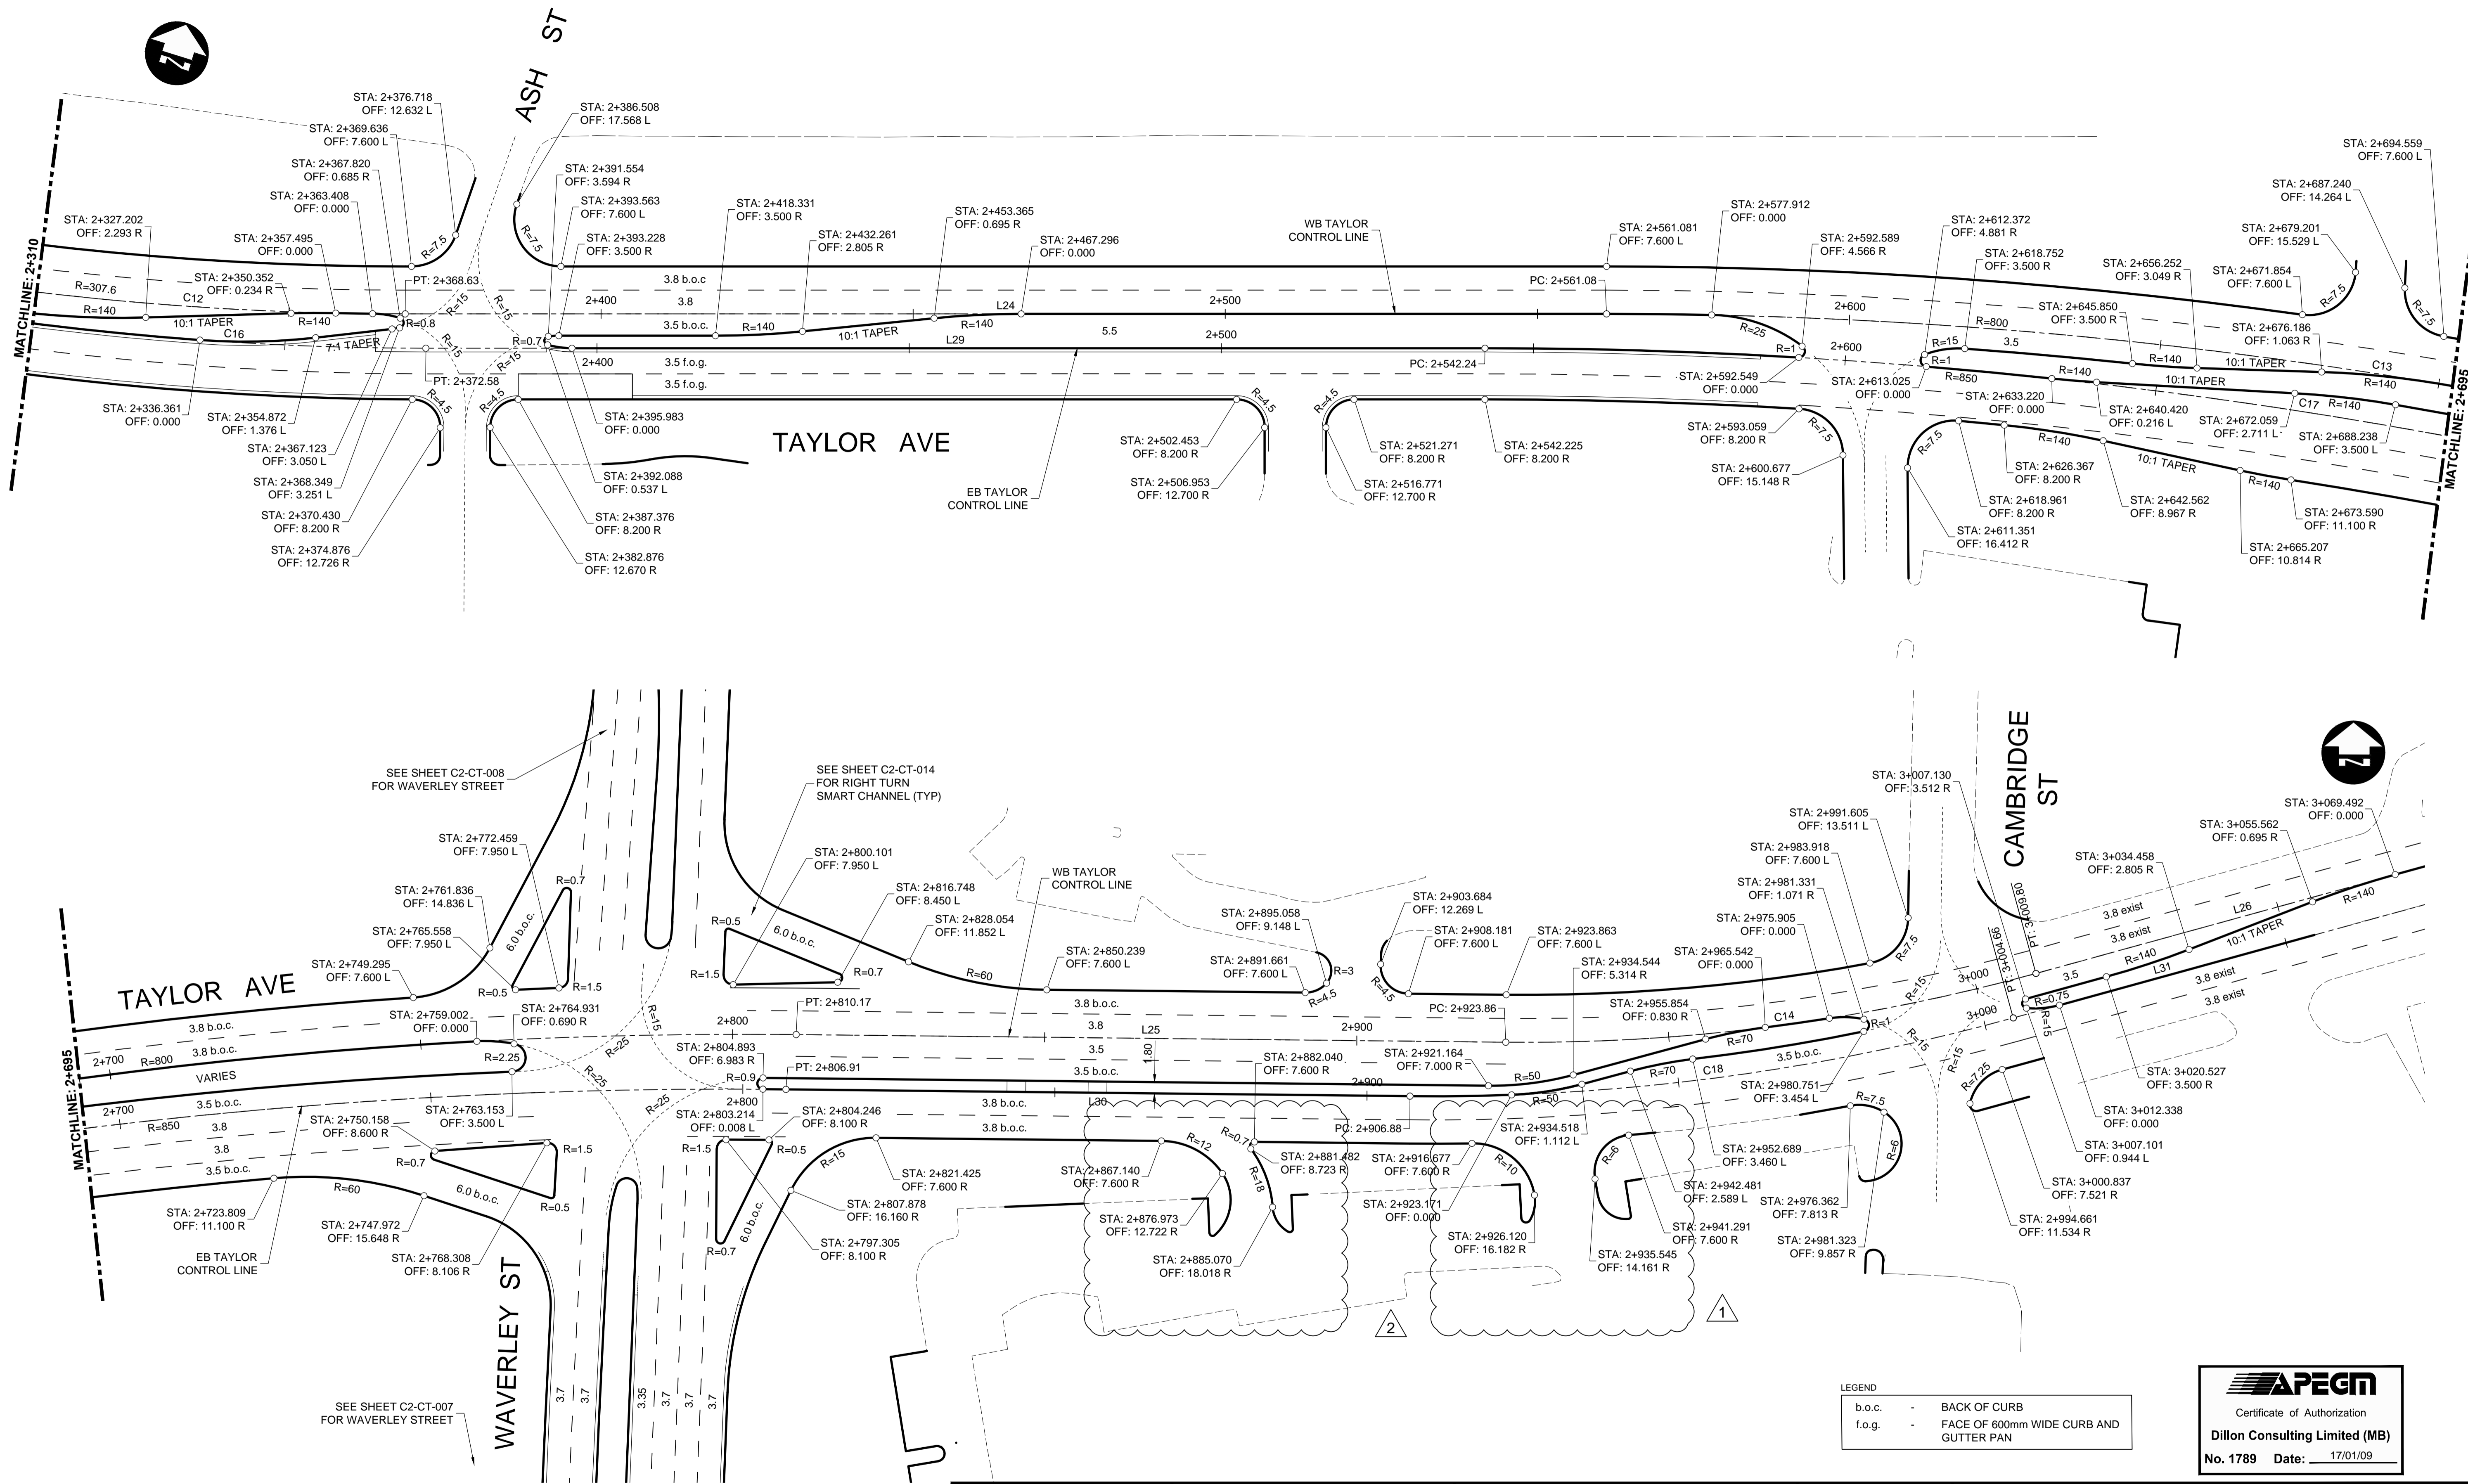

LEGEND
 b.o.c. - BACK OF CURB
 f.o.g. - FACE OF 600mm WIDE CURB AND GUTTER PAN

APEGM
 Certificate of Authorization
Dillon Consulting Limited (MB)
 No. 1789 Date: 17/01/09

UNDERGROUND STRUCTURES		B.M. ELEV.	SEE SHEET C2-CT-007 FOR CONTROL POINT INFORMATION
SUPPLY	U/G STRUCTURES	DATE	
2	ADDENDUM #2	17/02/03	DBW
1	ADDENDUM #1	17/01/25	DBW
0	ISSUED FOR TENDER	17/01/09	DBW
NO.	REVISIONS	DATE	BY

		DESIGNED BY	RTP	CHECKED BY	DBW
		DRAWN BY	TJH	APPROVED BY	DBW
HOR. SCALE		1:500		RELEASED FOR CONSTRUCTION	
VERTICAL				DATE	

ENGINEER'S SEAL
 PROVINCE OF MANITOBA
D.B. WIEBE
 Member 22480
 REGISTERED PROFESSIONAL ENGINEER
 CONSULTANT PROJECT NUMBER
16-3353

THE CITY OF WINNIPEG
 PUBLIC WORKS DEPARTMENT

WAVERLEY STREET UNDERPASS AT CN MILE 3.89 RIVERS SUB
 CONTRACT 2: UNDERPASS STRUCTURES, RAILWORKS, ROADWORKS, LAND DRAINAGE SEWER, PUMPING STATION AND LANDSCAPING WORKS
 CITY DRAWING NUMBER
 U-239-2016-C2-CT-011
 SHEET 011 OF 081
 CONSULTANT DRAWING NUMBER
C2-CT-011

LOCATION OF UNDERGROUND STRUCTURES AS SHOWN ARE BASED ON THE BEST INFORMATION AVAILABLE, BUT NO GUARANTEE IS GIVEN THAT ALL EXISTING UTILITIES ARE SHOWN OR THAT THE GIVEN LOCATIONS ARE EXACT. CONFIRMATION OF EXISTENCE AND EXACT LOCATION OF ALL SERVICES MUST BE OBTAINED FROM THE INDIVIDUAL UTILITIES BEFORE PROCEEDING WITH CONSTRUCTION.