


CHAINAGE ALONG CL OF TAYLOR AVE

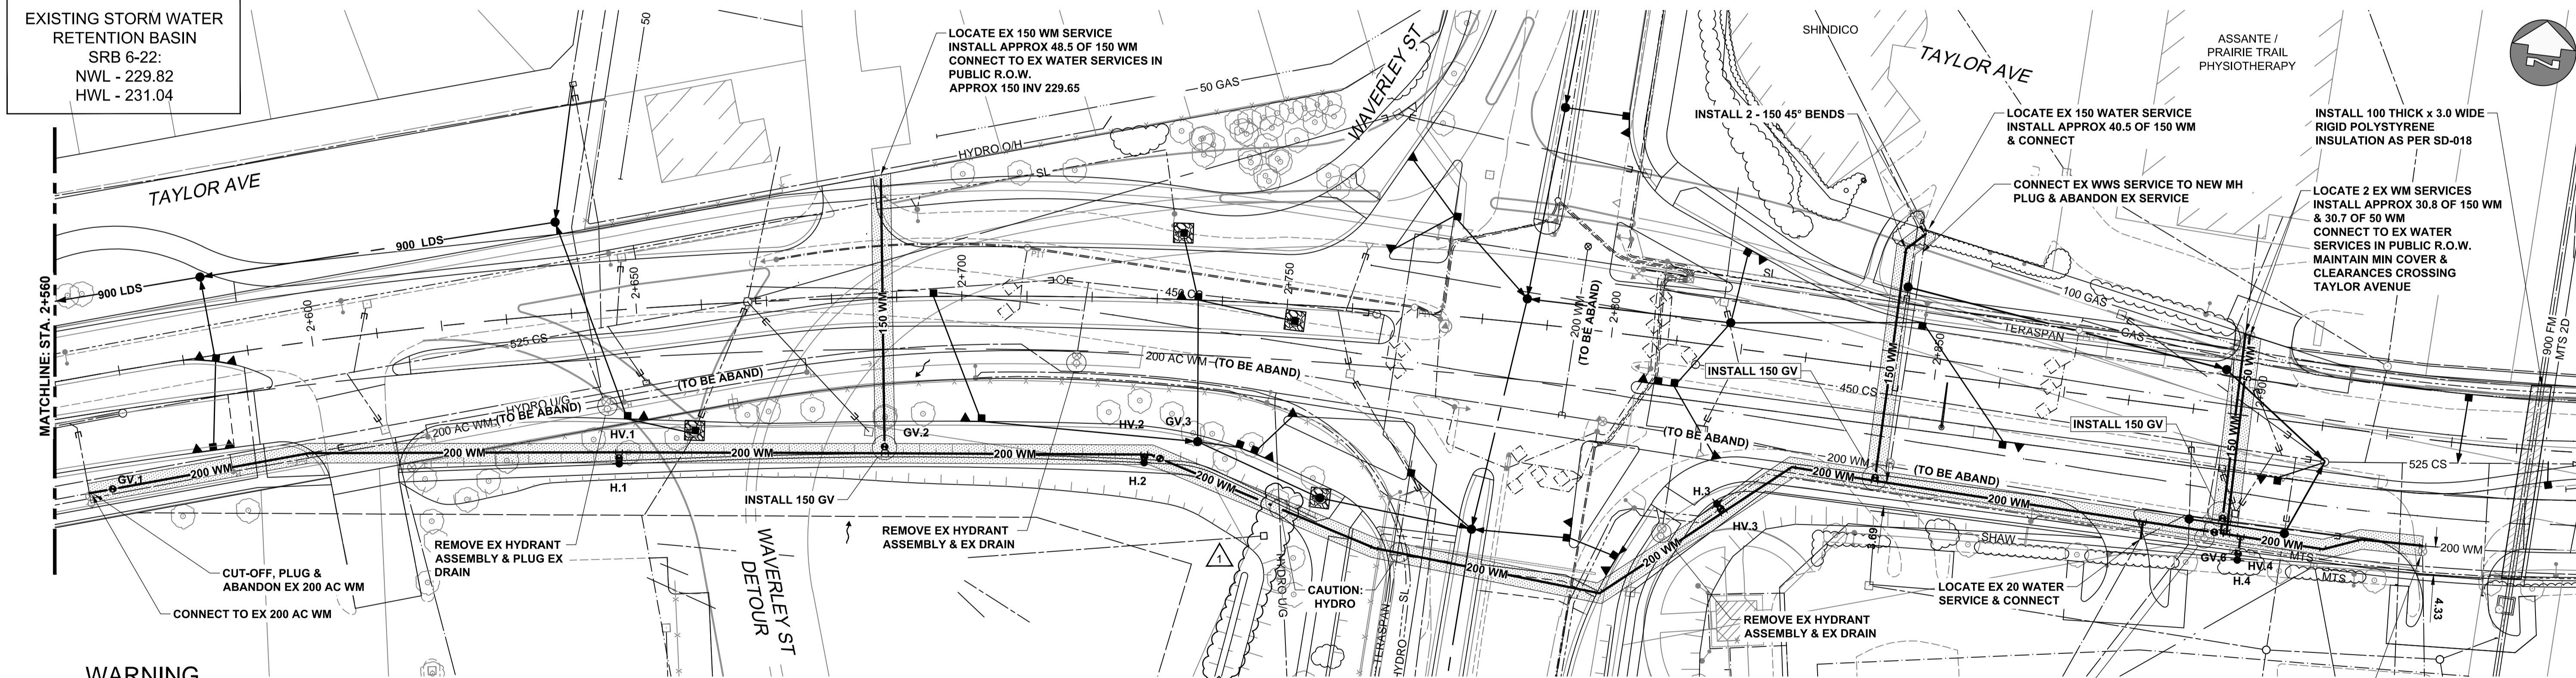

**WARNING**

IF POWER EQUIPMENT OR EXPLOSIVES ARE TO BE USED FOR EXCAVATION ON THIS PROJECT THE CONTRACTOR MUST:  
 1. NOTIFY THE GAS COMPANY OF THE PROPOSED LOCATION OF EXCAVATION.  
 2. TAKE PRECAUTION TO AVOID DAMAGE TO GAS COMPANY INSTALLATIONS SEE PROVINCIAL REGULATION 210/72 FOR DETAILS.  
 3. OBTAIN EXCAVATION PERMITS PRIOR TO CONSTRUCTION.

**NOTE:** REFER TO LDS STRUCTURE & LOCATION SCHEDULE ON DRAWING C2-CU-037 FOR FURTHER WATER MAIN, HYDRANT, VALVE & FITTINGS INFORMATION

**AECOM**  
 Certificate of Authorization  
 AECOM Canada Ltd.  
 No. 4671 Date:

**METRIC**  
 WHOLE NUMBERS INDICATE MILLIMETRES  
 DECIMALIZED NUMBERS INDICATE METRES

BID OPPORTUNITY NO. 473-2016

150 WM	WATER MAIN	150 WM	PIPE ABANDONMENTS	150 WM	WATER MAIN	150 WM
Hydrant	Hydrant	Hydrant	Survey Bar	Hydrant	Hydrant	Hydrant
Valve	Valve	Valve	Curb Stop	Valve	Valve	Valve
300 LDS	LAND DRAINAGE SEWER	300 LDS	Reducer	300 LDS	LAND DRAINAGE SEWER	300 LDS
250 WWS	WASTE WATER SEWER	250 WWS	Coupling	250 WWS	WASTE WATER SEWER	250 WWS
SSP	SEWER SERVICE PIPE	SSP	Anode	SSP	PAVEMENT CROWN	SSP
Drainage Connection Pipe	Drainage Connection Pipe	Drainage Connection Pipe	Hydro	Drainage Connection Pipe	N/W PROPERTY LINE	Drainage Connection Pipe
Manhole	Manhole	Manhole	MTS	Manhole	S/E PROPERTY LINE	Manhole
Catch Basin	Catch Basin	Catch Basin	Gas	Catch Basin	N/W GUTTER	Catch Basin
Curb Inlet	Curb Inlet	Curb Inlet	Testhole	Curb Inlet	S/E GUTTER	Curb Inlet
Culvert	Culvert	Culvert	Lamp Standard	Culvert	Legend - Profile	Culvert
Existing	Legend - Plan	New	Existing	Legend - Plan	New	Existing

**UNDERGROUND STRUCTURES**

SUPV. U/G STRUCTURES	DATE

LOCATION OF UNDERGROUND STRUCTURES AS SHOWN ARE BASED ON THE BEST INFORMATION AVAILABLE BUT NO GUARANTEE IS GIVEN THAT ALL EXISTING UTILITIES ARE SHOWN OR THAT THE GIVEN LOCATIONS ARE EXACT. CONFIRMATION OF EXISTENCE AND EXACT LOCATION OF ALL SERVICES MUST BE OBTAINED FROM THE INDIVIDUAL UTILITIES BEFORE PROCEEDING WITH CONSTRUCTION.

**B.M. ELEV.**


**AECOM**

DESIGNED BY	MPG	CHECKED BY	
DRAWN BY	KLC	APPROVED BY	
HOR. SCALE	1:500	RELEASED FOR CONSTRUCTION	
VERTICAL	1:100		

ENGINEER'S SEAL  
 PROVINCE OF MANITOBA  
**M.P.A. GAUDREAU**  
 Member  
 32167  
 REGISTERED PROFESSIONAL ENGINEER

**THE CITY OF WINNIPEG**  
 PUBLIC WORKS DEPARTMENT

Waverley Street Underpass at CN Mile 3.89 Rivers Sub  
 Contract 2: Underpass Structure, Railworks, Roadworks, Land Drainage Sewer, Pumping Station and Landscaping Works

Taylor Avenue - Plan/Profile  
 WM Relocation  
 STA 2+560 to STA 2+940

CITY DRAWING NUMBER  
 U239-2016-C2-CU-020  
 SHEET 20 OF 41  
 CONSULTANT DRAWING NUMBER  
 C2-CU-020

PA:60321148;900-WorkX;9100-DD\_CAD;200-SHEETS\Municipal\63353-C2-CON-CU-Taylor-WM-001.dwg