


CHAINAGE ALONG CL OF WAVERLEY ST

EXISTING STORM WATER RETENTION BASIN
SRB 6-22:
NWL - 229.82
HWL - 231.04

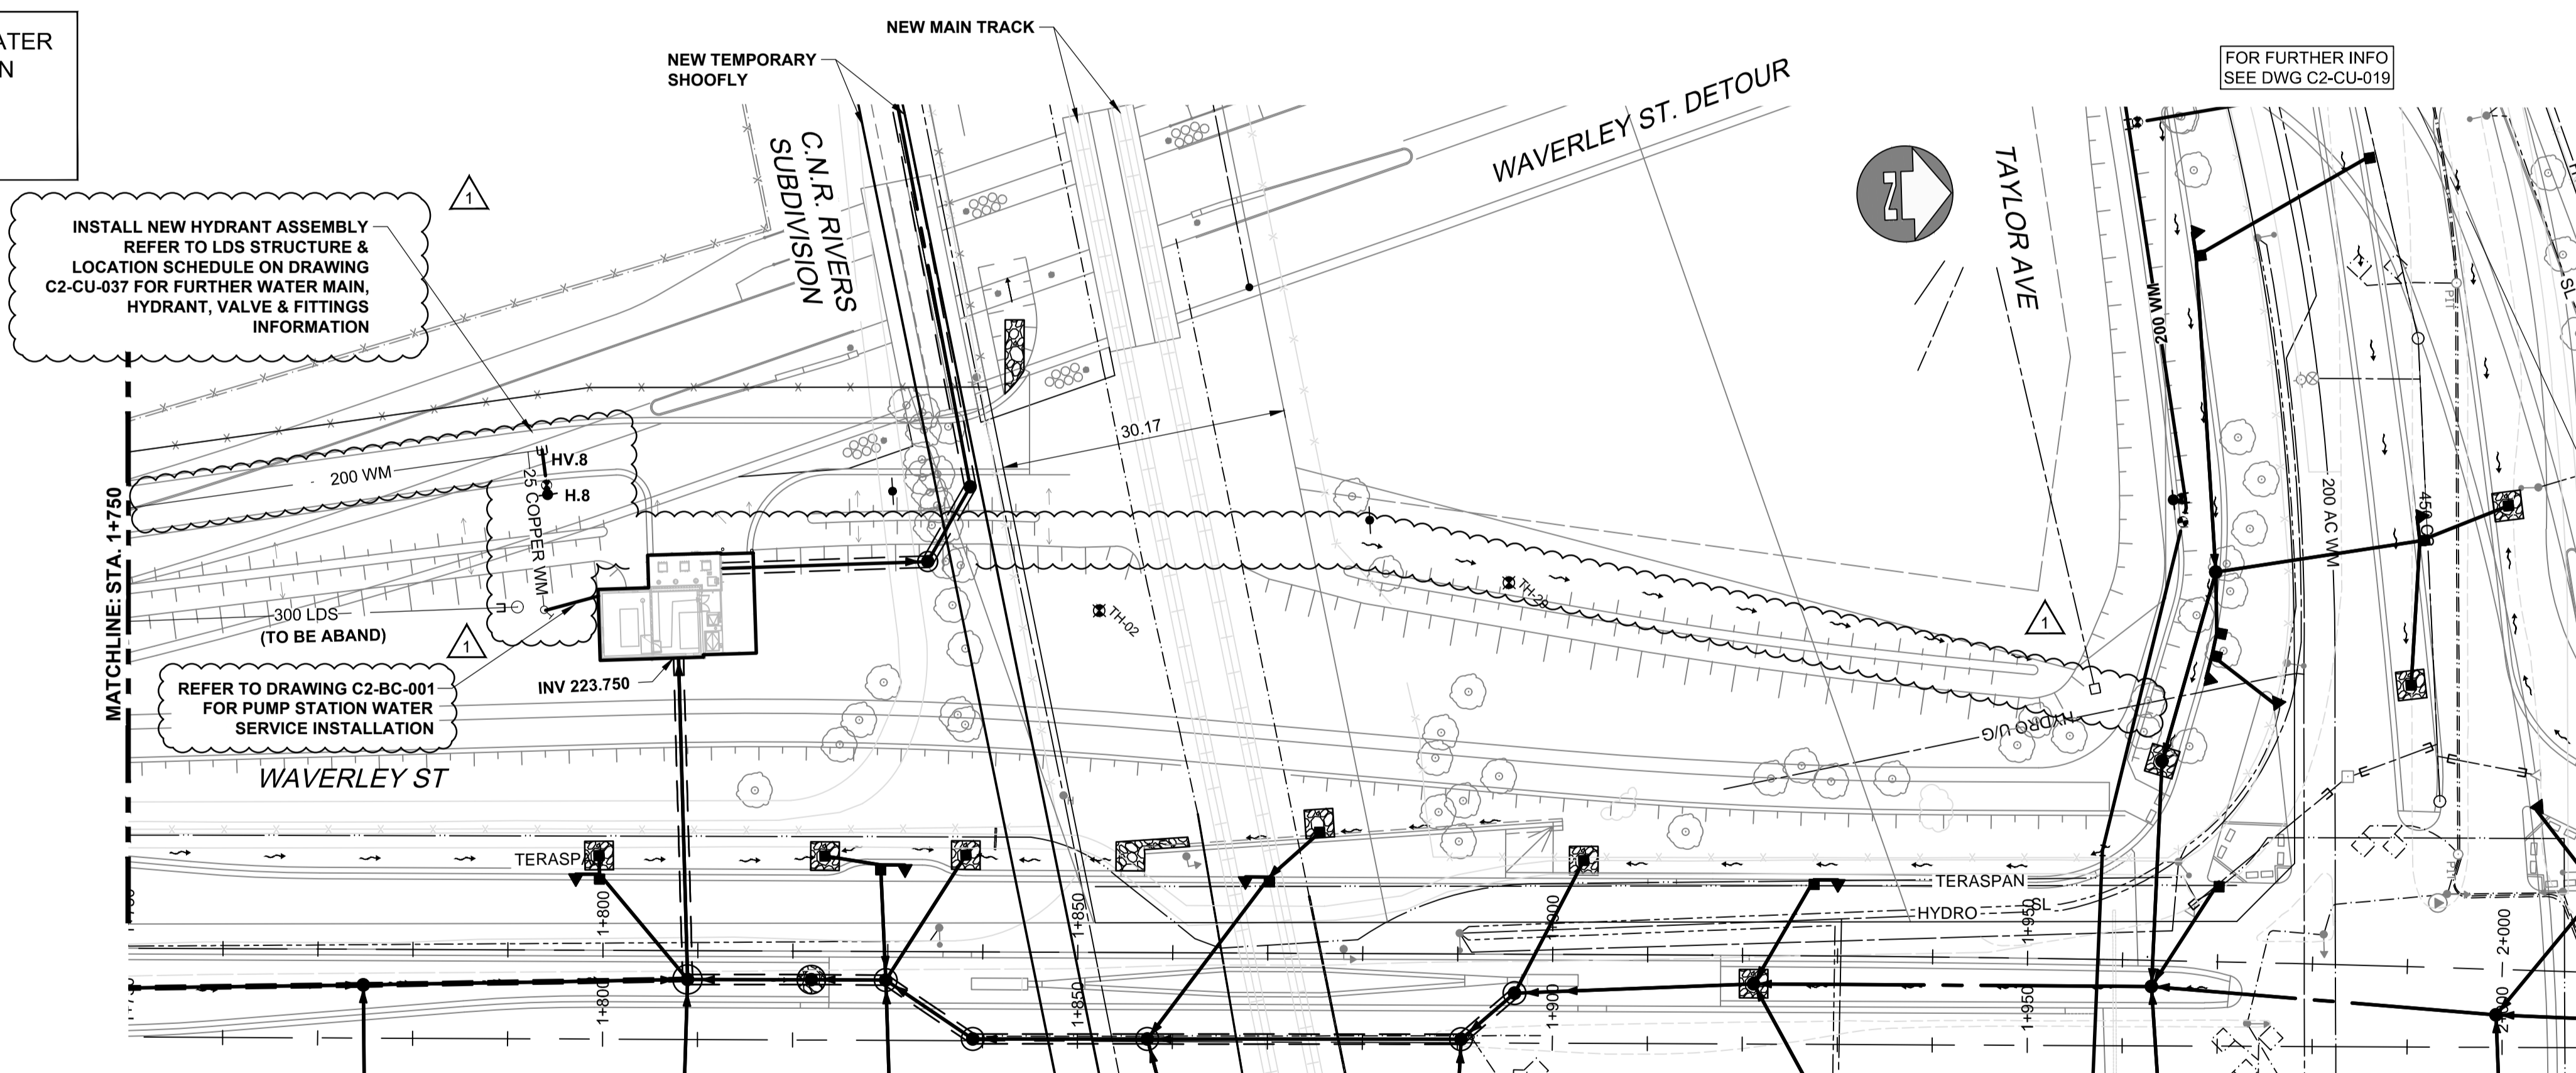

WARNING

IF POWER EQUIPMENT OR EXPLOSIVES ARE TO BE USED FOR EXCAVATION ON THIS PROJECT THE CONTRACTOR MUST:

1. NOTIFY THE GAS COMPANY OF THE PROPOSED LOCATION OF EXCAVATION.
2. TAKE PRECAUTION TO AVOID DAMAGE TO GAS COMPANY INSTALLATIONS SEE PROVINCIAL REGULATION 210/72 FOR DETAILS.
3. OBTAIN EXCAVATION PERMITS PRIOR TO CONSTRUCTION.

METRIC
WHOLE NUMBERS INDICATE MILLIMETRES
DECIMALIZED NUMBERS INDICATE METRES

APEGM
Certificate of Authorization
AECOM Canada Ltd.
No. 4671 Date: _____

BID OPPORTUNITY NO. 473-2016

EXISTING	LEGEND - PLAN	NEW	EXISTING	LEGEND - PLAN	NEW	EXISTING	LEGEND - PROFILE	NEW
150 WM	WATER MAIN	150 WM	PIPE ABANDONMENTS	150 WM	WATER MAIN	150 WM	WATER MAIN	150 WM
Hydrant symbol	HYDRANT	Valve symbol	Survey bar symbol	Hydrant symbol	HYDRANT	Valve symbol	Valve symbol	Valve symbol
300 LDS	LAND DRAINAGE SEWER	300 LDS	Reducer symbol	300 LDS	LAND DRAINAGE SEWER	300 LDS	LAND DRAINAGE SEWER	300 LDS
250 WWS	WASTE WATER SEWER	250 WWS	Coupling symbol	250 WWS	WASTE WATER SEWER	250 WWS	WASTE WATER SEWER	250 WWS
SSP	SEWER SERVICE PIPE	SSP	Anode symbol	Hydro symbol	PAVEMENT CROWN	Hydro symbol	PAVEMENT CROWN	Hydro symbol
Manhole symbol	MANHOLE	Manhole symbol	Hydro symbol	MTS symbol	N/W PROPERTY LINE	Hydro symbol	N/W PROPERTY LINE	Hydro symbol
Catch basin symbol	CATCH BASIN	Catch basin symbol	Gas symbol	MTS symbol	S/E PROPERTY LINE	Gas symbol	S/E PROPERTY LINE	Gas symbol
Curb inlet symbol	CURB INLET	Curb inlet symbol	Testhole symbol	Testhole symbol	N/W GUTTER	Testhole symbol	N/W GUTTER	Testhole symbol
Culvert symbol	CULVERT	Culvert symbol	Lamp standard symbol	Lamp standard symbol	S/E GUTTER	Lamp standard symbol	S/E GUTTER	Lamp standard symbol

UNDERGROUND STRUCTURES	
SUPV. U/G STRUCTURES	DATE

LOCATION OF UNDERGROUND STRUCTURES AS SHOWN ARE BASED ON THE BEST INFORMATION AVAILABLE BUT NO GUARANTEE IS GIVEN THAT ALL EXISTING UTILITIES ARE SHOWN OR THAT THE GIVEN LOCATIONS ARE EXACT. CONFIRMATION OF EXISTENCE AND EXACT LOCATION OF ALL SERVICES MUST BE OBTAINED FROM THE INDIVIDUAL UTILITIES BEFORE PROCEEDING WITH CONSTRUCTION.

B.M. ELEV.				

AECOM	
DESIGNED BY: MPG	CHECKED BY: []
DRAWN BY: KLC	APPROVED BY: []
HOR. SCALE: 1:500	RELEASED FOR CONSTRUCTION: []
VERTICAL: 1:100	DATE: []

ENGINEER'S SEAL
PROVINCE OF MANITOBA
MPA. GAUDREAU
Member 32167
REGISTERED PROFESSIONAL ENGINEER

THE CITY OF WINNIPEG
PUBLIC WORKS DEPARTMENT

WAVERLEY STREET UNDERPASS AT CN MILE 3.89 RIVERS SUB
CONTRACT 2: UNDERPASS STRUCTURE, RAILWORKS,
ROADWORKS, LAND DRAINAGE SEWER, PUMPING STATION
AND LANDSCAPING WORKS

WAVERLEY STREET - PLAN/PROFILE
WM
PUMPING STATION ACCESS ROAD

CITY DRAWING NUMBER: U239-2016-C2-CU-025
SHEET 25 OF 41
CONSULTANT DRAWING NUMBER: C2-CU-025

PA:60321148;900-Work\9100-DD CAD;200-SHEETS\Municipal\163353-C2-CON-CU-Waverley-002.dwg