



**2 INTERMEDIATE LEVEL PLAN**  
 BP-002 REF: BP-003 SCALE: 1 : 50

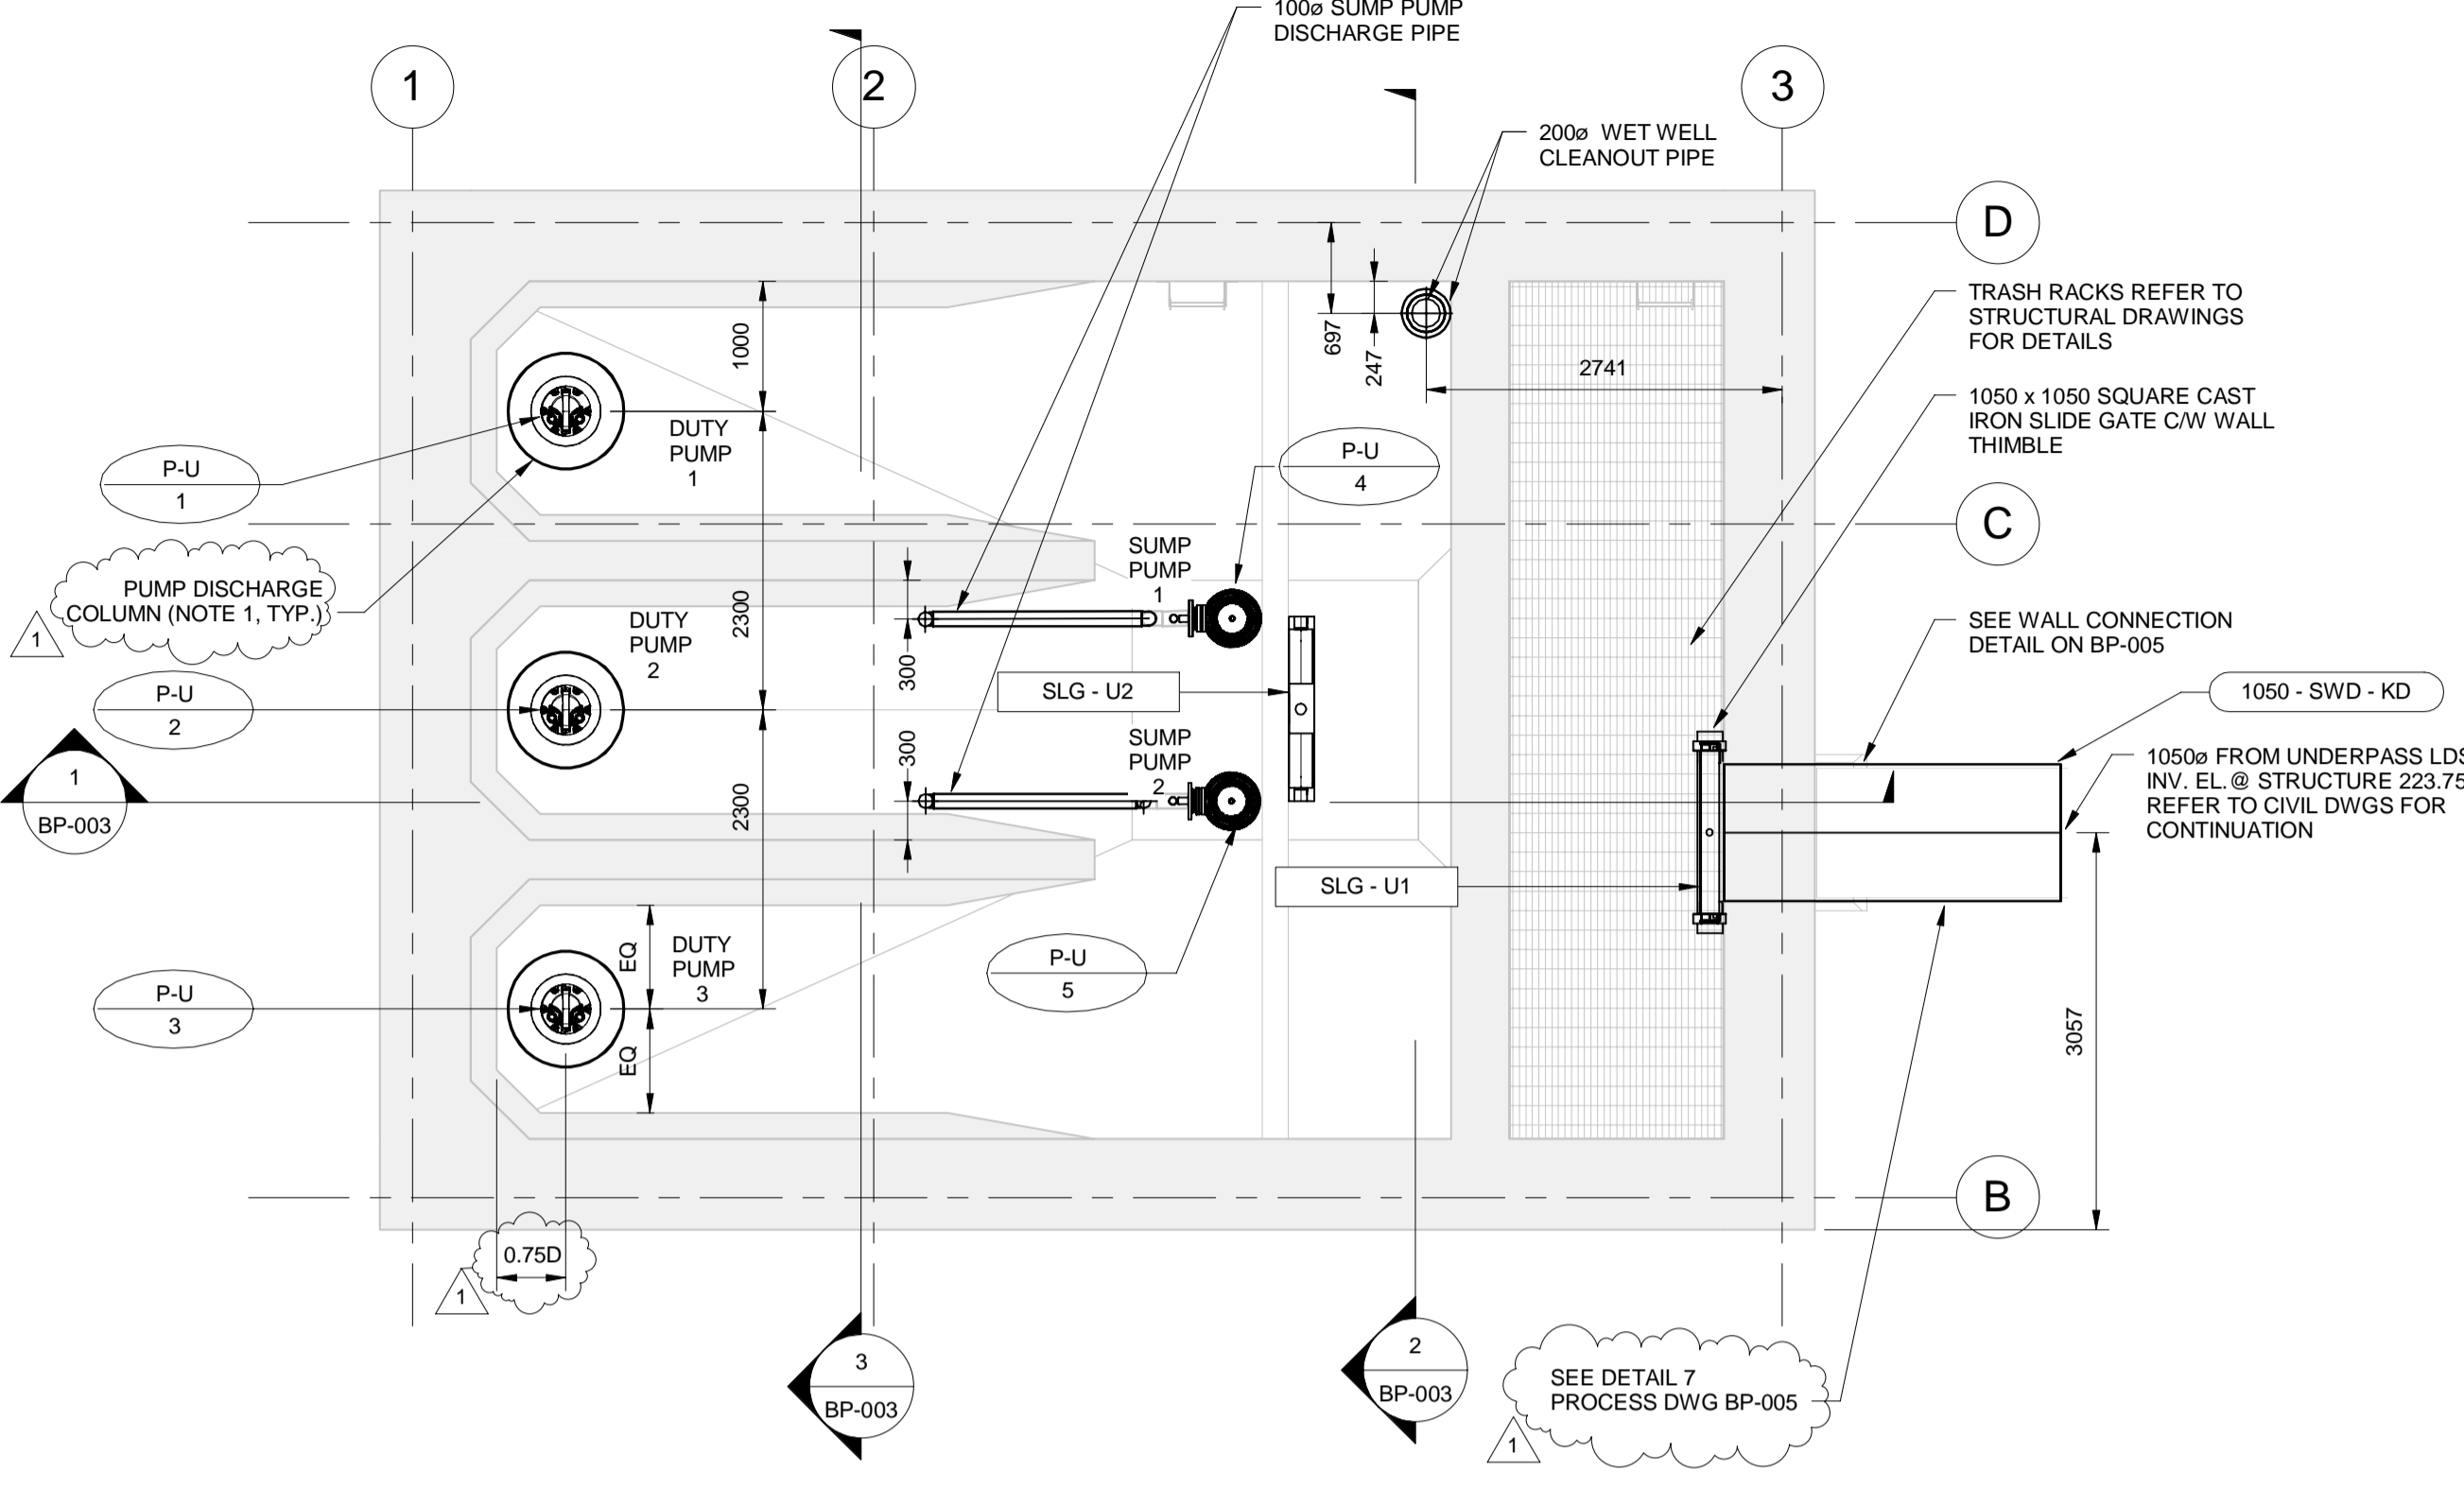

**3 LOWER LEVEL PLAN**  
 BP-002 REF: BP-003 SCALE: 1 : 50

**GENERAL NOTE:**

1. PUMP COLUMN DIAMETER (D) SHALL SUIT SELECTED PUMPS IN ACCORDANCE WITH THE SPECIFICATIONS.
2. BENCHING SHALL SUIT INLET BELL DIAMETER OF THE SELECTED PUMPS.

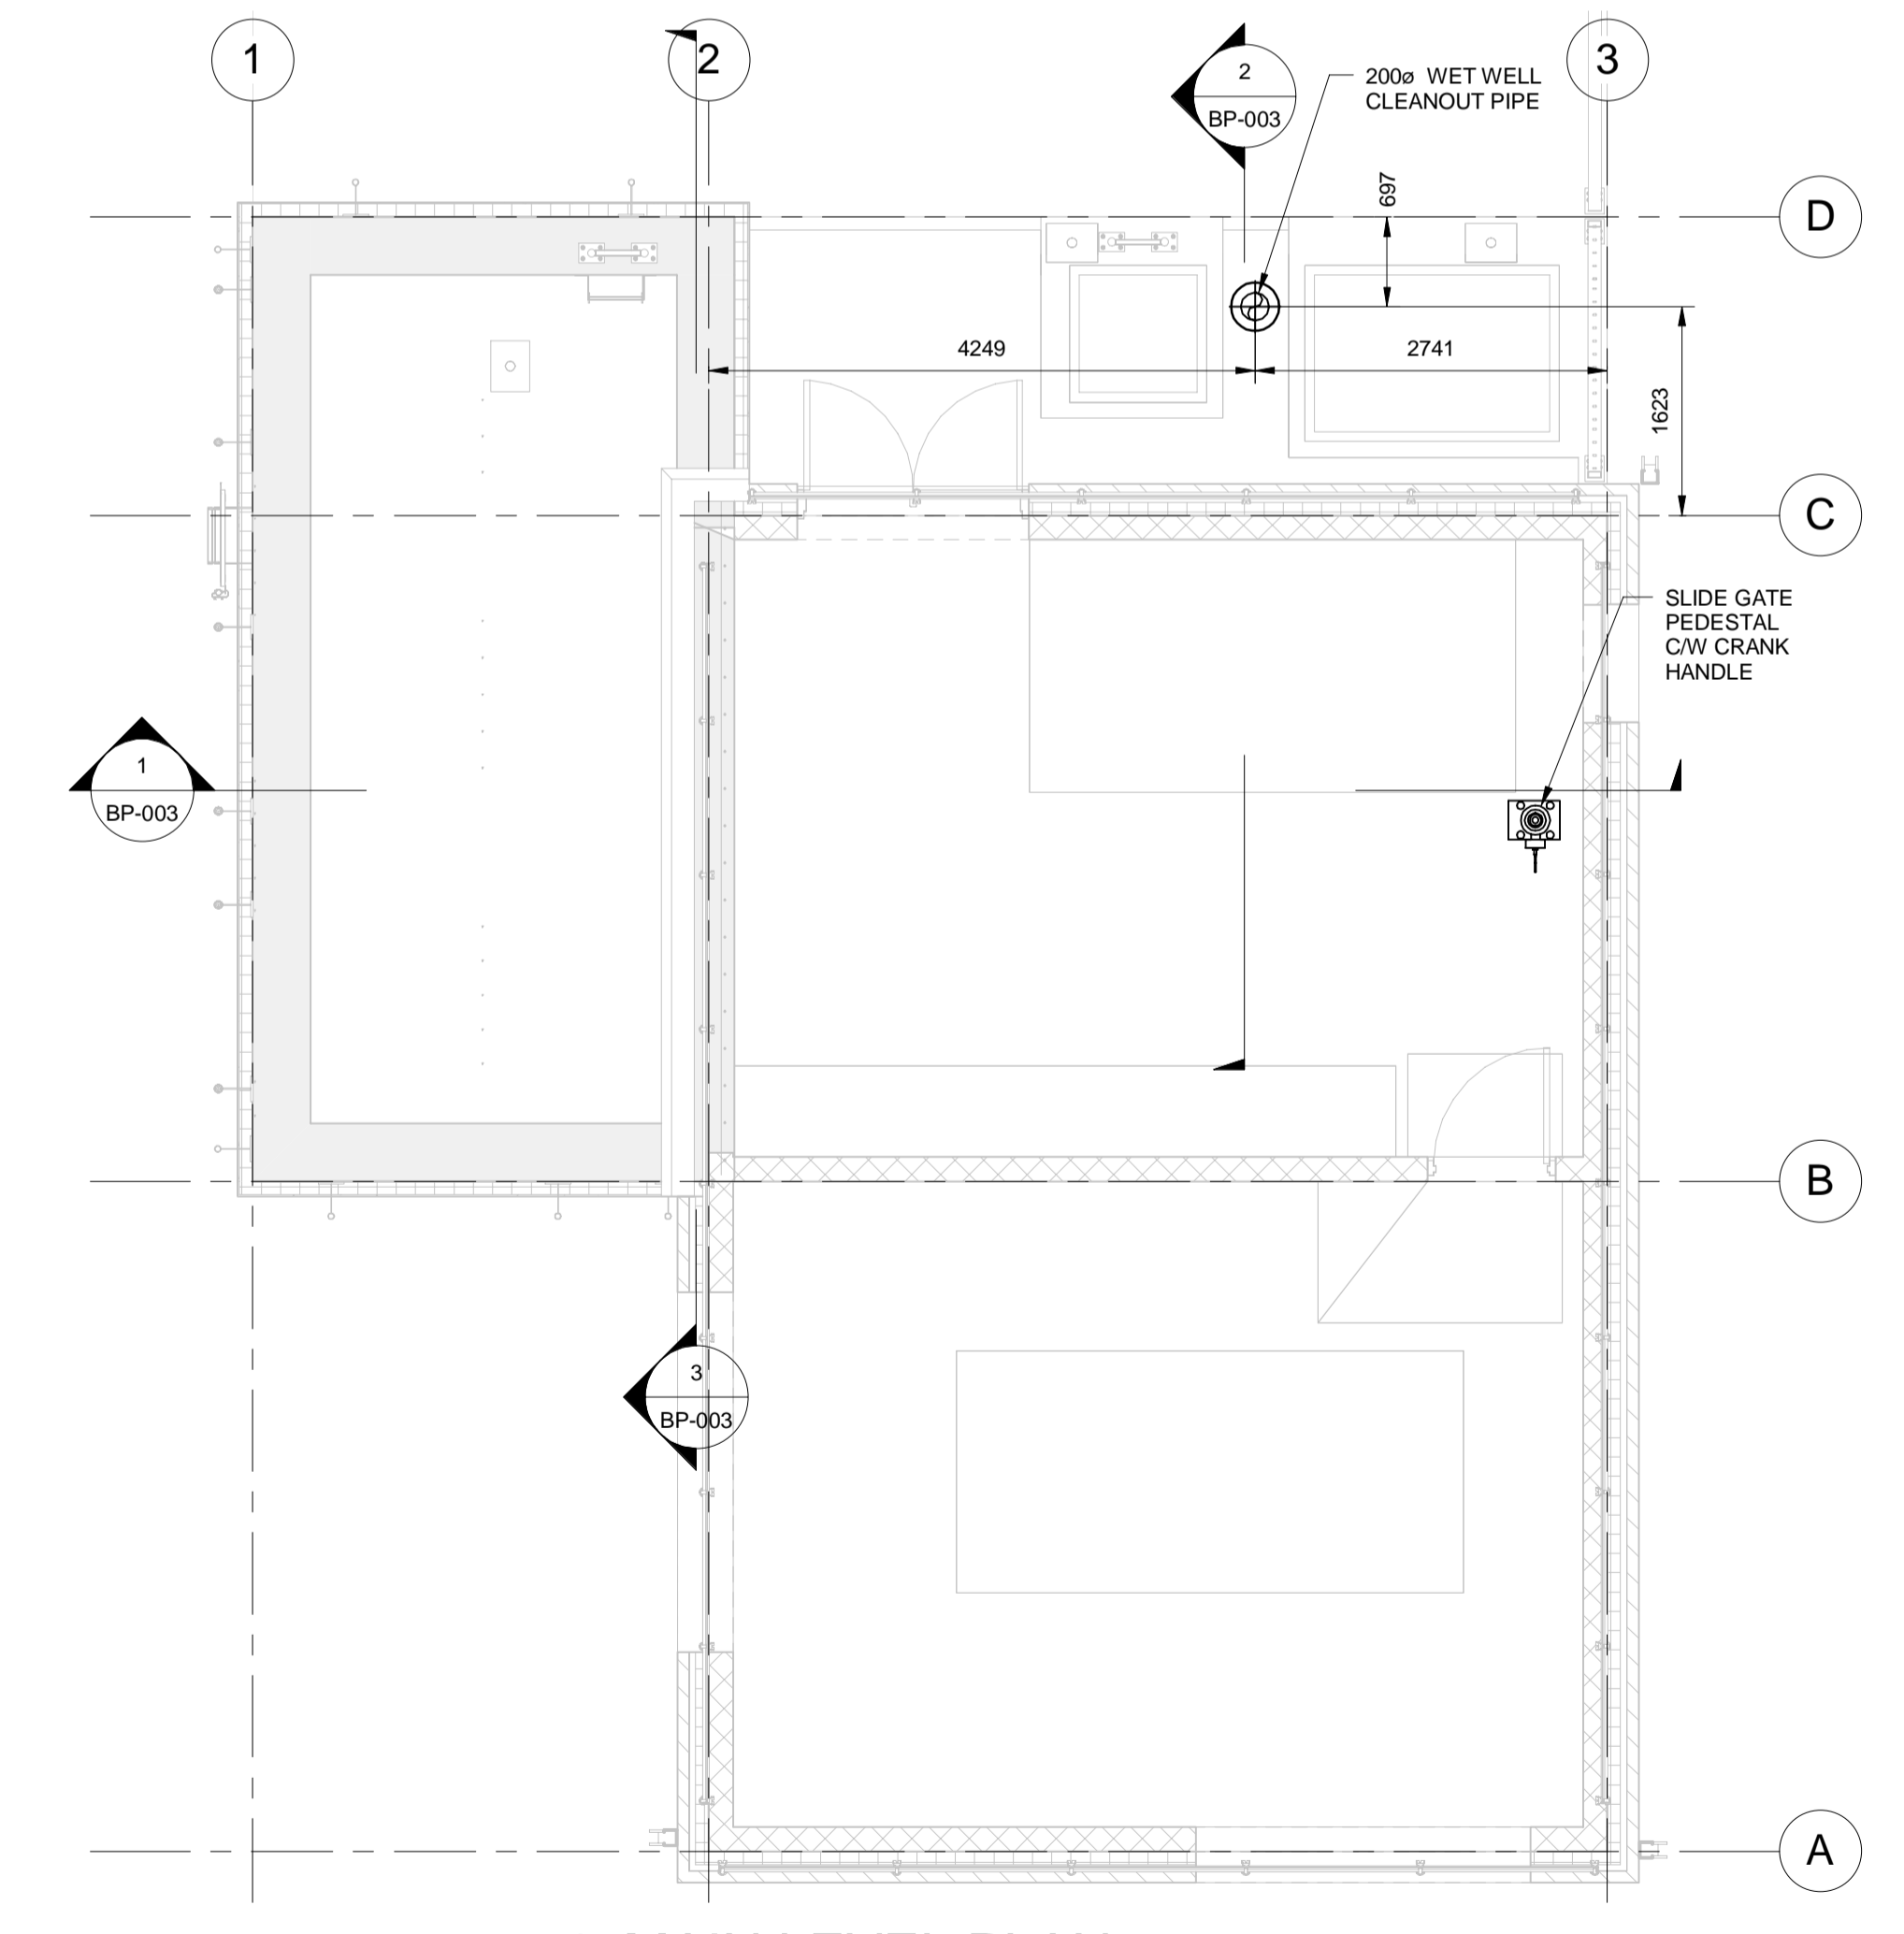

**1 MAIN LEVEL PLAN**  
 BP-002 REF: BP-003 SCALE: 1 : 50

P:\60321148\9000\_Work\910-CAD\99-SUPPORT\PROJECT\_TITLE\_BLOCKS\Title\_Block\_for\_Pump\_Station\_works\163383-XTB-C1-CU.dwg



**METRIC**  
 WHOLE NUMBERS INDICATE MILLIMETRES  
 DECIMALIZED NUMBERS INDICATE METRES

UNDERGROUND STRUCTURES				B.M. ELEV.		AECOM		ENGINEER'S SEAL		THE CITY OF WINNIPEG PUBLIC WORKS DEPARTMENT				
SUPV. U/G STRUCTURES	DATE					DESIGNED BY	JAT	CHECKED BY	MPG		<b>Waverley Street Underpass at CN Mile 3.89 Rivers Sub</b> CONTRACT 2: UNDERPASS STRUCTURE, RAILWORKS, ROADWORKS, LAND DRAINAGE SEWER, PUMPING STATION AND LANDSCAPING WORKS	CITY DRAWING NUMBER	U-239-2016-C2-BP-002	
						DRAWN BY	DJP	APPROVED BY	AN			SHEET	2 OF 5	
LOCATION OF UNDERGROUND STRUCTURES AS SHOWN ARE BASED ON THE BEST INFORMATION AVAILABLE. BUT NO GUARANTEE IS GIVEN THAT ALL EXISTING UTILITIES ARE SHOWN OR THAT THE GIVEN LOCATIONS ARE EXACT. CONFIRMATION OF EXISTENCE AND EXACT LOCATION OF ALL SERVICES MUST BE OBTAINED FROM THE INDIVIDUAL UTILITIES BEFORE PROCEEDING WITH CONSTRUCTION.				NO.	REVISIONS	DATE	BY	DATE	06/01/2016	RELEASED FOR CONSTRUCTION	CONSULTANT PROJECT NUMBER	60321148	<b>PUMPING STATION</b> PROCESS MAIN FLOOR AND INTERMEDIATE CONSULTANT DRAWING NUMBER <b>C2-BP-002</b>	