SHEET: COW-A1 (05/2005)

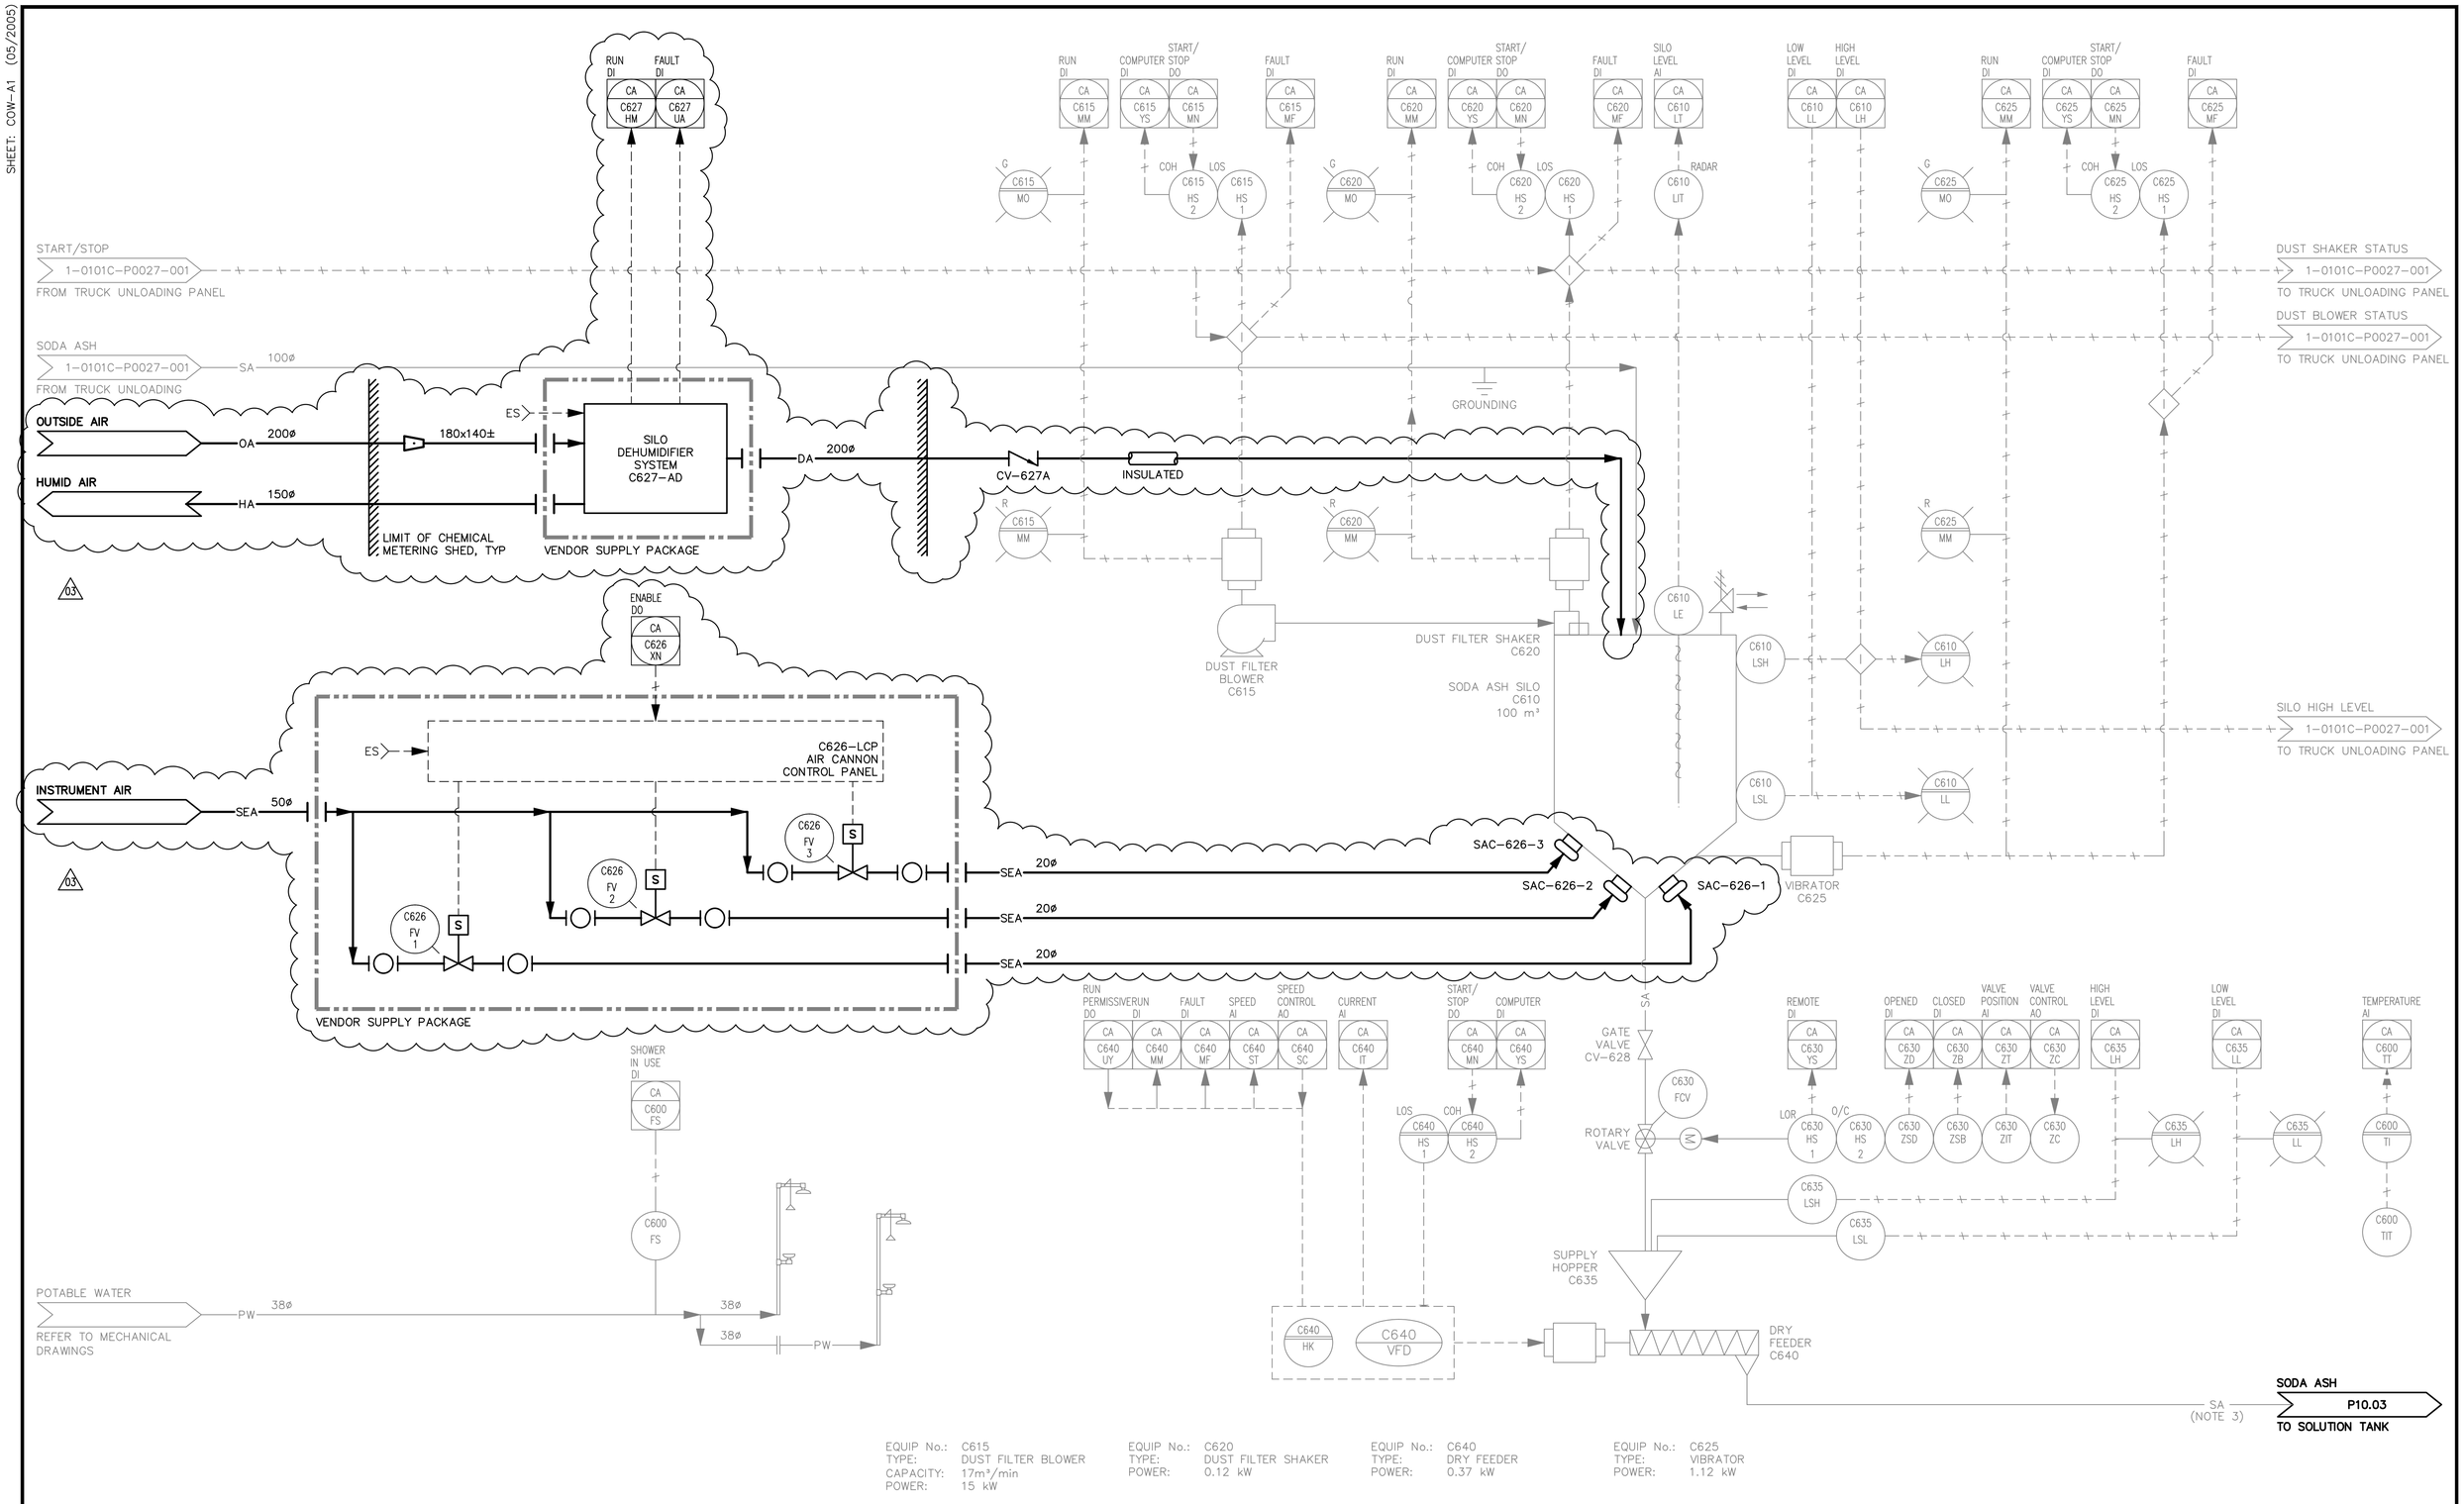

EQUIP No.: C615
TYPE: DUST FILTER BLOWER
CAPACITY: 17m³/min
POWER: 15 kW

EQUIP No.: C620
TYPE: DUST FILTER SHAKER
POWER: 0.12 kW

EQUIP No.: C640
TYPE: DRY FEEDER
POWER: 0.37 kW

EQUIP No.: C625
TYPE: VIBRATOR
POWER: 1.12 kW

NOTICE:
AS-CONSTRUCTED DIMENSIONS, MEASUREMENTS AND OTHER DETAILS CONTAINED IN THIS RECORD DRAWING HAVE BEEN OBTAINED BY AECOM CANADA LTD. ("AECOM") FROM VARIOUS SOURCES. SUCH INFORMATION REPRESENTS THE BEST INFORMATION AVAILABLE TO AECOM AT THE TIME OF PREPARATION OF THIS RECORD DRAWING. AECOM DOES NOT IN ANY WAY REPRESENT OR WARRANT THAT SUCH INFORMATION IS ACCURATE AND ASSUMES NO RESPONSIBILITY FOR ANY ERRORS OR OMISSIONS CONTAINED THEREIN.

REVISION 03 CHANGES THE ENGINEER'S DESIGN RESPONSIBILITIES ARE LIMITED TO THE CHANGES INDICATED IN THE CLOUDED WORK

DESIGNED BY:	NK	CHECKED BY:	KJS
DRAWN BY:	SRG	APPROVED BY:	KJS
DATE:	16/06/23	RELEASED FOR CONSTR. DATE:	–

KEY PLAN

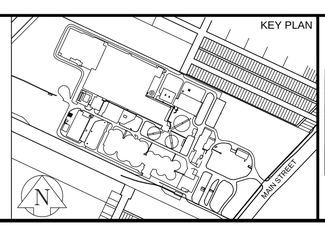

APEGM
Certificate of Authorization
AECOM Canada Ltd.
No. 4671 Date: June 23/16

B.M.
ELEV.

NO.	REVISIONS	DATE	BY
03	ISSUED FOR TENDER: BID OP 547-2016	16/06/23	SRG
02	AS-CONSTRUCTED DRAWING	09/02/18	CD
01	ISSUED FOR CONSTRUCTION	06/08/30	GLG
00	ISSUED FOR TENDER	06/05/15	GLG

EarthTech
A Tyco International Ltd. Company

DESIGNED BY	LW/CD	CHECKED BY	SB/PS
DRAWN BY	SRP	APPROVED BY	
SCALE:	NONE	RELEASED FOR CONSTRUCTION BY:	
DATE	2006/01/16	DATE	

PROVINCE OF MANITOBA
June 23/16
K.J. SEARS
REGISTERED PROFESSIONAL ENGINEER

CONSULTANT DRAWING NO.
P10.02

Winnipeg
THE CITY OF WINNIPEG
WATER AND WASTE DEPARTMENT
ENGINEERING DIVISION

NEWPCC CENTRATE NUTRIENT TREATMENT NITROGEN REMOVAL FACILITY

CITY FILE NUMBER
SHEET OF

PROCESS
SODA ASH BLOWER SYSTEM
PROCESS & INSTRUMENTATION DIAGRAM

CITY DRAWING NUMBER
1-0101C-P0028-001-03

Last Save: 2016_06_23 12:29 PM