


EAST SIDE RETAINING WALL PLAN – NORTH OF MATCH LINE
1:150



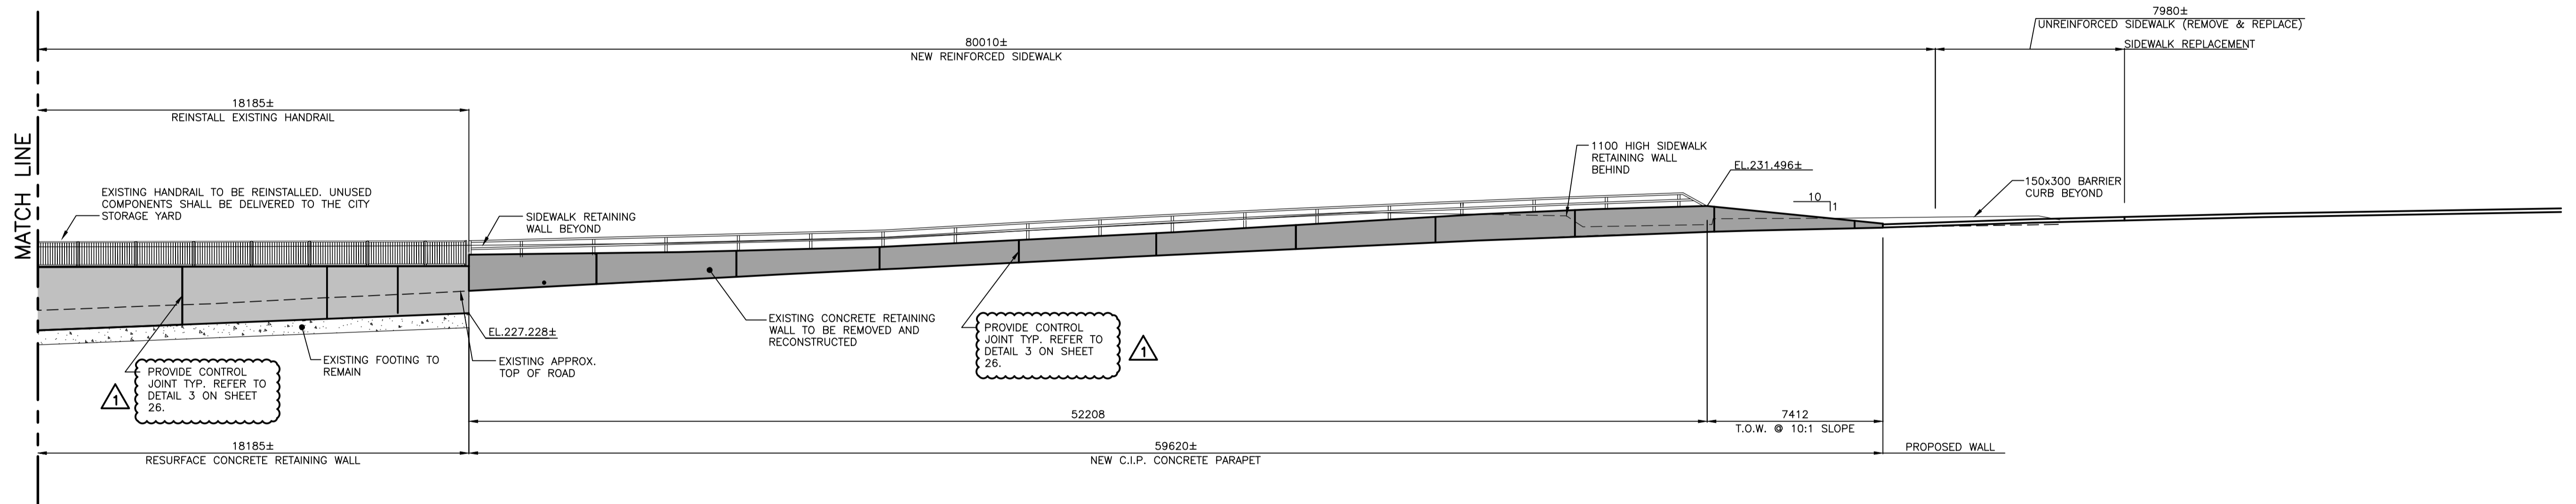


EAST SIDE RETAINING WALL ELEVATION – NORTH OF MATCH LINE
1:150

NOTES:

- REFER TO DRAWING S102 FOR GENERAL NOTES.
- SIDEWALK CONTROL JOINTS SHALL MATCH EXISTING RETAINING WALL CONTROL JOINTS OR PAVEMENT JOINTS.

LEGEND:

-  - EXISTING CONCRETE
-  - RESURFACED/RECONSTRUCTED RETAINING WALL
-  - RECONSTRUCTED PARAPET WALL

150 WM	WATERMAIN	150 WM	HYDRO	150 WM	WATERMAIN	150 WM
+	HYDRANT VALVE	+	M.T.S. CONCRETE	+	HYDRANT, VALVE	+
⊗	LAND DRAINAGE SEWER	⊗	MILL AND FILL OVERLAY	⊗	LAND DRAINAGE SEWER	⊗
300 LDS	WASTE WATER SEWER	300 LDS	CONCRETE SIDEWALK	300 LDS	WASTE WATER SEWER	300 LDS
250 WWS	MANHOLE	250 WWS	BOREHOLE	250 WWS	WASTE WATER SEWER	250 WWS
○	CATCH BASIN/CATCH PIT CURB INLET	○	SEEDING	○	NORTH OR WEST GUTTER	○
▽	CURB RENEWAL	▽	PROPERTY LINE	▽	SOUTH OR EAST GUTTER	▽
---	GRAVEL	---	SURVEY BAR	---	NORTH OR WEST R.	---
---	GAS	---	ELEVATION	---	SOUTH OR EAST R.	---
---	EXISTING	---	SIDEWALK DETECTABLE	---	NORTH OR WEST DITCH	---
---	LEGEND-PLAN	---	PROPOSED	---	SOUTH OR EAST DITCH	---

LOCATION APPROVED UNDERGROUND STRUCTURES	
SUPV. U/G STRUCTURES COMMITTEE	DATE
NOTE: LOCATION OF UNDERGROUND STRUCTURES AS SHOWN ARE BASED ON THE BEST INFORMATION AVAILABLE BUT NO GUARANTEE IS GIVEN THAT ALL EXISTING UTILITIES ARE SHOWN OR THAT THE GIVEN LOCATIONS ARE EXACT. CONFIRMATION OF EXISTENCE AND EXACT LOCATION OF ALL SERVICES MUST BE OBTAINED FROM THE INDIVIDUAL UTILITIES BEFORE PROCEEDING WITH CONSTRUCTION.	

B.M. ELEV.			
1	ISSUED FOR ADDENDUM No.1	16.07.13	K.S.A.
0	ISSUED FOR TENDER	16.07.04	K.S.A.
NO.	REVISIONS	DATE	BY

Stantec
500 - 311 Portage Avenue, Winnipeg MB Canada
www.stantec.com

DESIGNED BY	S.Y.	CHECKED BY	K.S.A.
DRAWN BY	T.B.C.	APPROVED BY	B.J.W.
HOR. SCALE:	AS NOTED	RELEASED FOR CONSTRUCTION:	
VERTICAL:		DATE	2016.07.04

ENGINEER'S SEAL
CONSULTANT DRAWING NO.
S-115

THE CITY OF WINNIPEG
PUBLIC WORKS DEPARTMENT
ENGINEERING DIVISION

2016 REGIONAL STREET PROGRAM
ARCHIBALD UNDERPASS
ST+ 130 TO ST+ 370
WEST RETAINING WALL PLAN (2 OF 2)

SHEET 31 OF 62
CAD FILE DRAWING NUMBER 06880s-111-884.dwg
CITY DRAWING NUMBER U205-16-31