

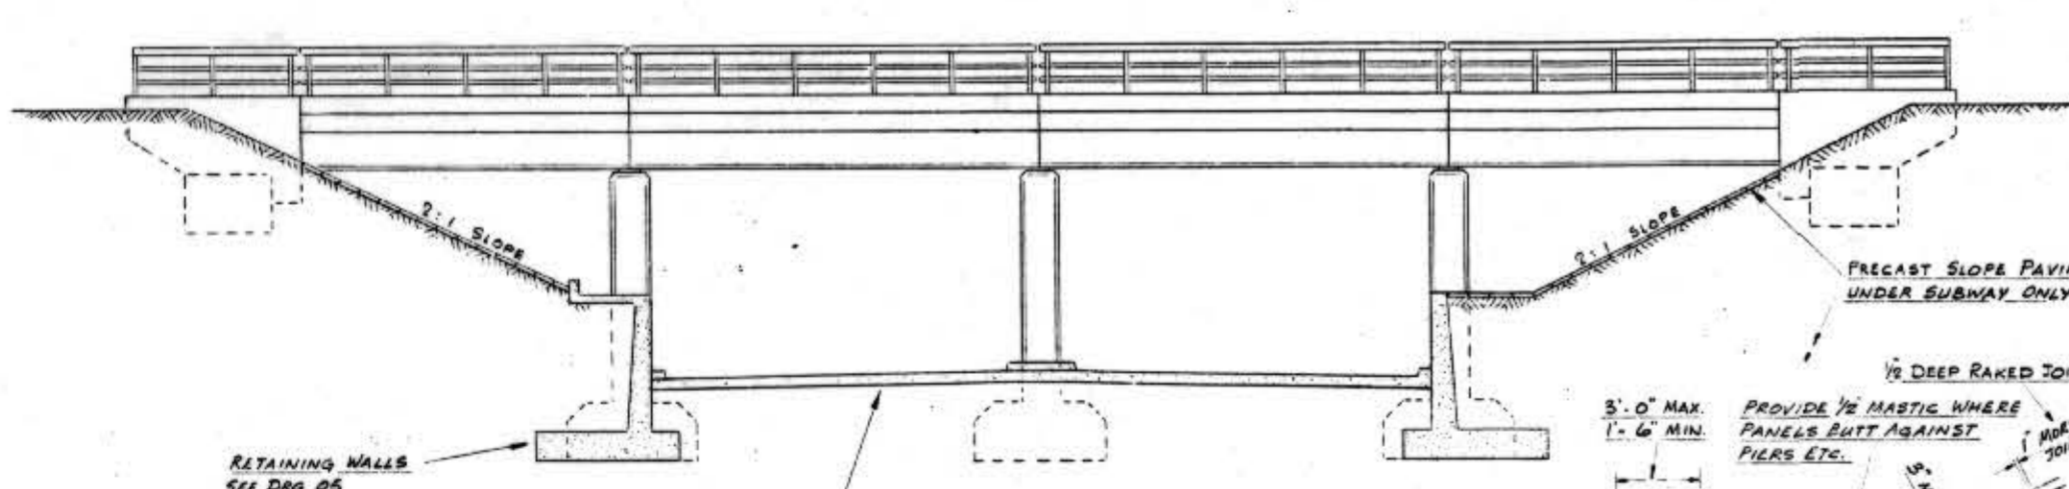
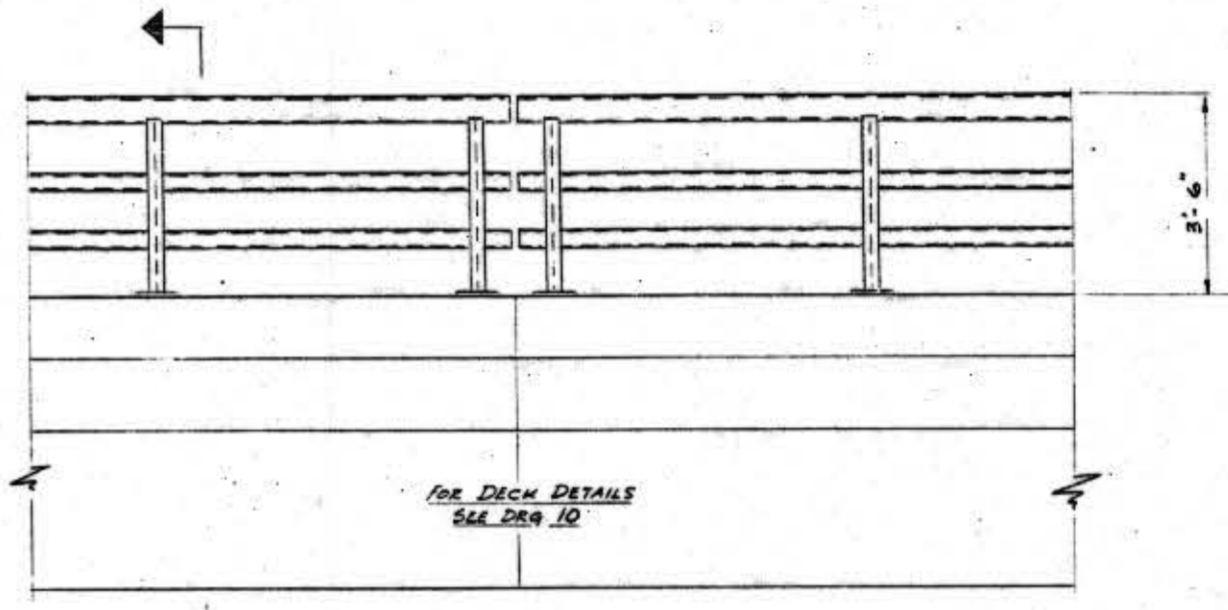
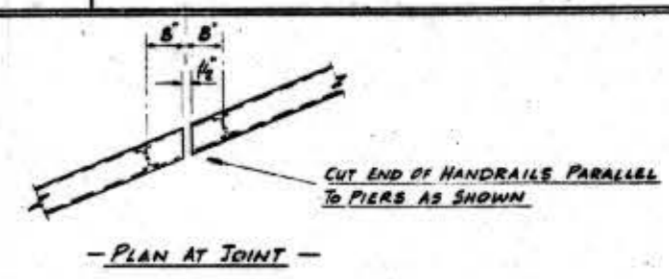
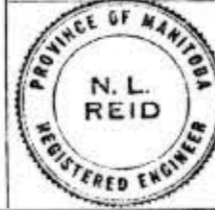
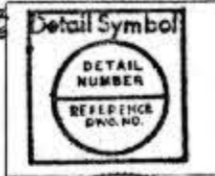
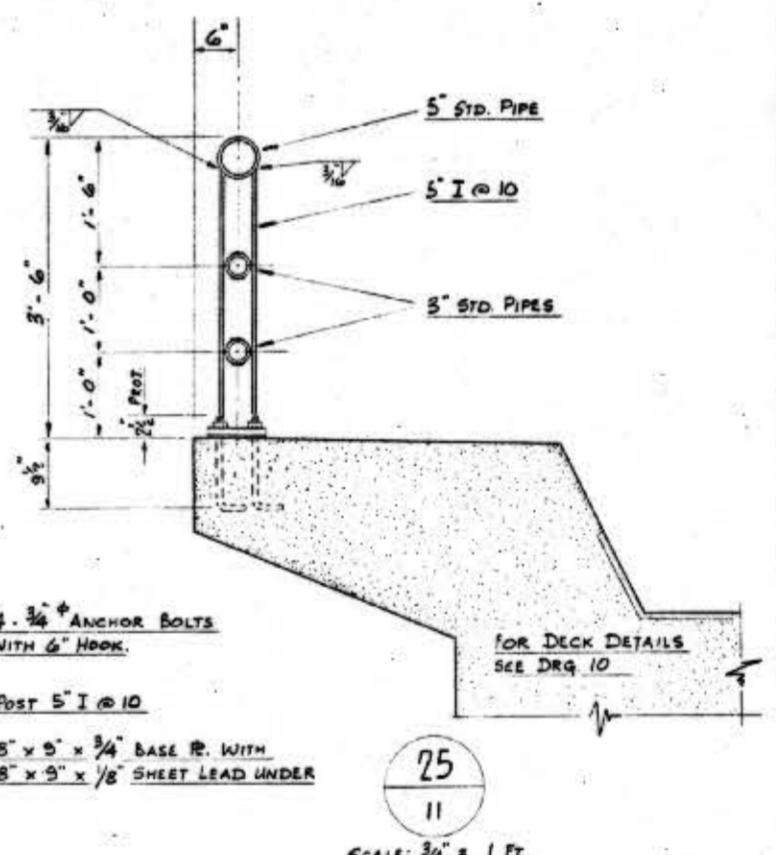


PLAN
SCALE: 1/8" = 1 FT.

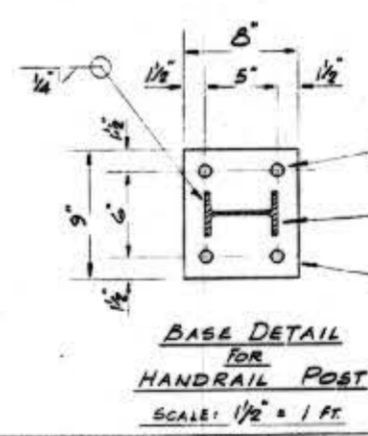

SECTION
SCALE: 1/8" = 1 FT.

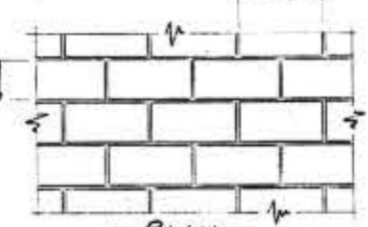

BY	APP	REVISIONS	DATE
LSA	AS	CONSTRUCTED	28 11 52

HADDIN, DAVIS & BROWN (MANITOBA) LIMITED
CONSULTING ENGINEERS
WINNIPEG MANITOBA

CITY of ST. BONIFACE, MANITOBA
ARCHIBALD ST. SUBWAY

**RAILWAY STRUCTURE
HANDRAIL DETAILS**

SCALE AS SHOWN
DATE AUG 1959
DGN. BY W. J. S.
DRN. BY W. G.

CHKD. BY W. T. G.
APP. BY N. L. R.
JOB No. 4102
SHEET No. 11 OF 22

DWG. No. SW2-11

