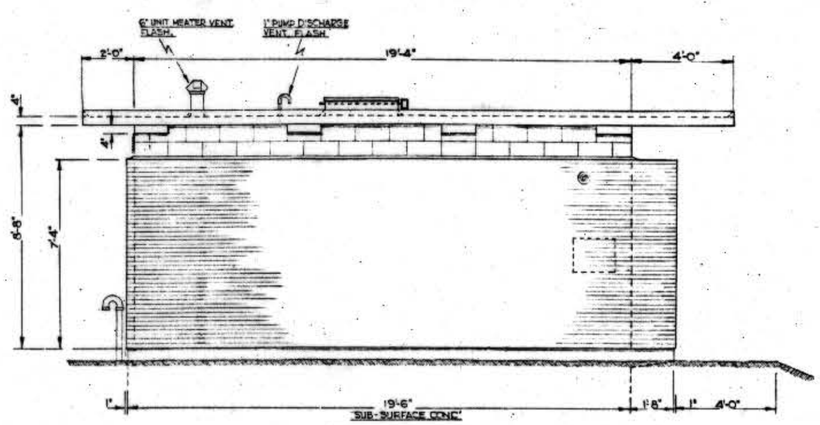

SOUTH ELEVATION

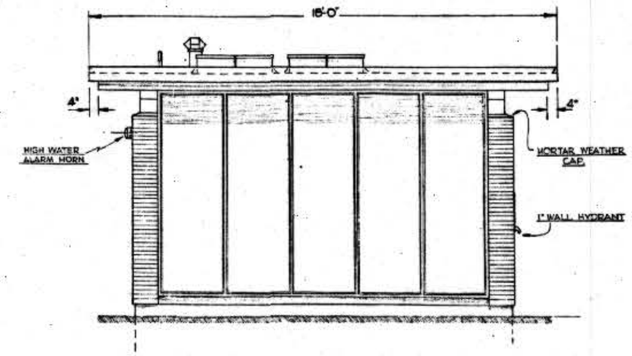

EAST ELEVATION.
SCALE. 3/16"=1'-0"

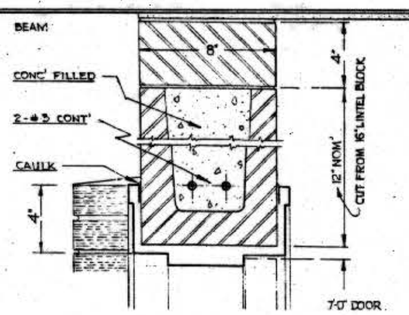

HEAD

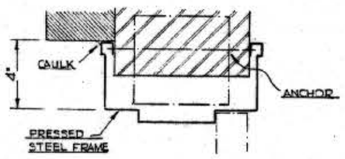

JAMB

DOOR FRAME DETAILS
SCALE 3"=1'-0"

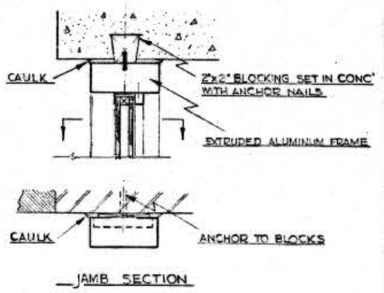

JAMB SECTION

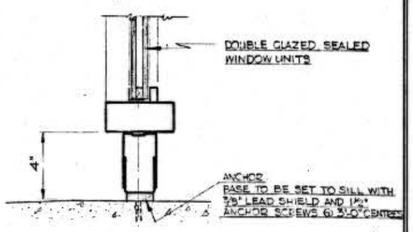

WINDOW DETAILS
SCALE : 3" = 1'-0"

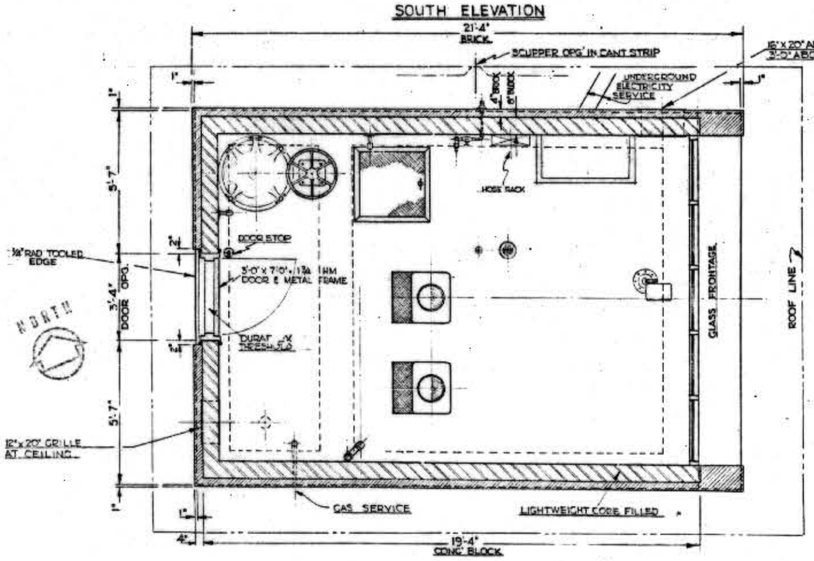

PLAN
SCALE: 3/8"=1'-0"

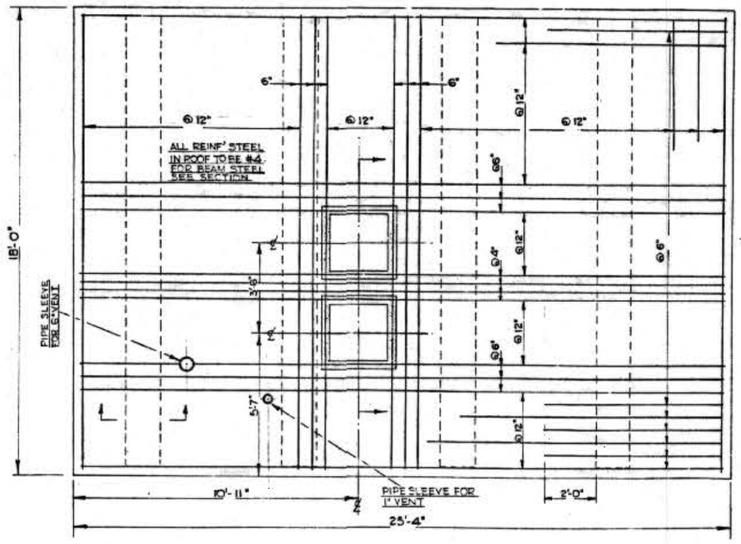

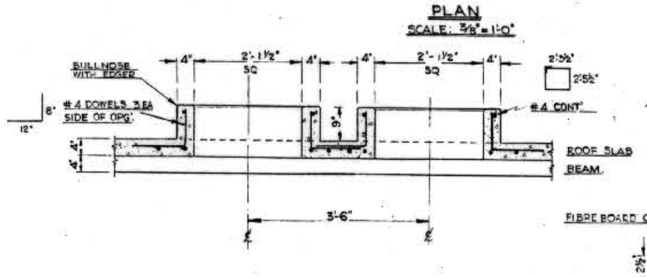

ROOF OPENING DETAILS
SCALE : 3/4"=1'-0"

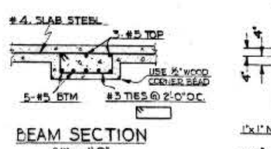

BEAM SECTION
3/4" = 1'-0"

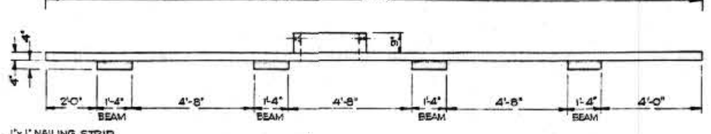

ROOF SLAB
SCALE : 3/8" = 1'-0"

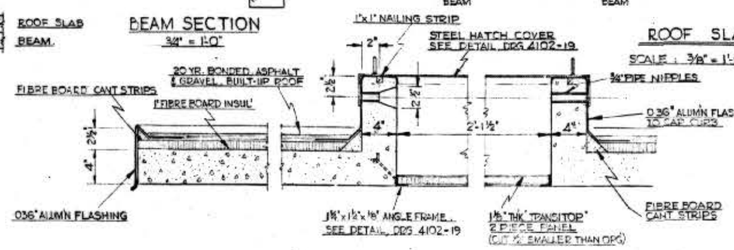

ROOFING DETAILS
SCALE : 1½" = 1'-0"

Detail Symbol
DETAIL NUMBER
REFERENCE DWG. NO.

BY	APP	REVISIONS	DATE
L.S.R.		AS CONSTRUCTED	28 11 62

HADDIN, DAVIS & BROWN (MANITOBA) LIMITED
CONSULTING ENGINEERS
WINNIPEG MANITOBA

CITY of ST. BONIFACE, MANITOBA
ARCHIBALD ST. SUBWAY

PUMP STATION ARCHITECTURAL DETAILS

SCALE	AS SHOWN	CKD. BY	G.R.B.
DATE	SEPT. 1959	APP. BY	J.E.D.
DSGN. BY	G.D./W.T.G.	JOB No.	4102
DRN. BY	A.W.H.	SHEET No.	18 OF 22

DWG. No. SW2-18