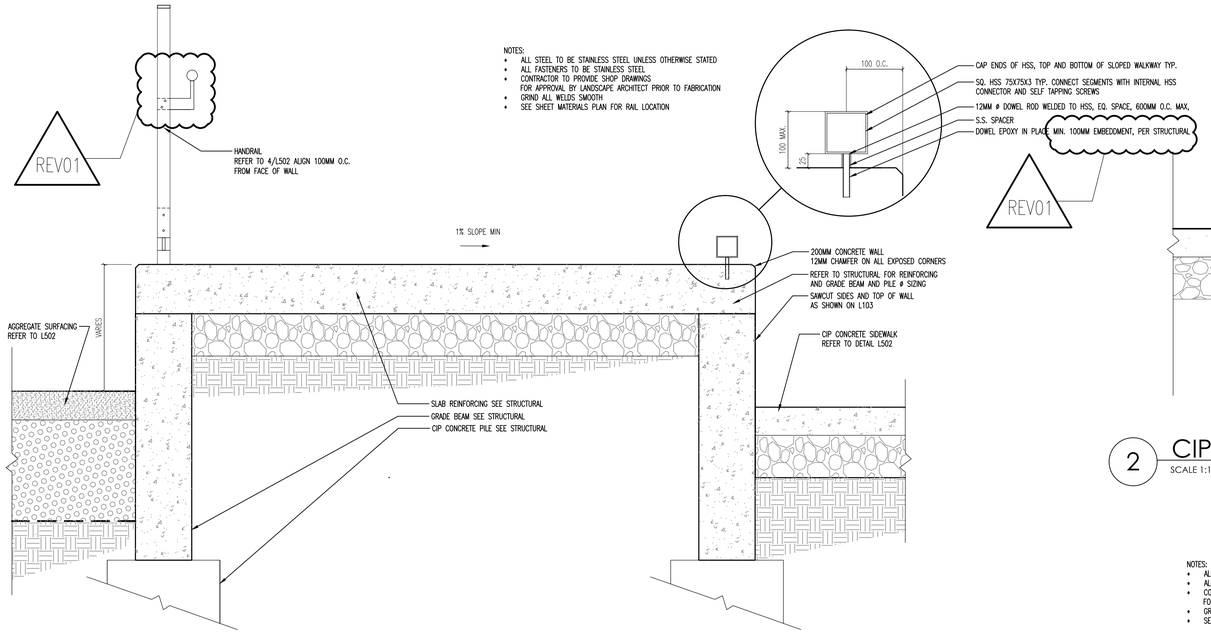

1 CIP CONCRETE SLOPED WALK-WAY W/ BULL-RAIL & RAILING

SCALE 1:10 (@24x36)

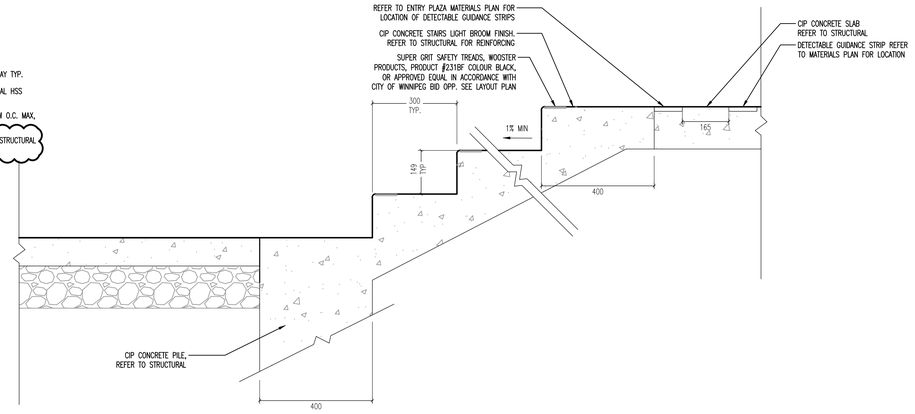

2 CIP CONCRETE STAIRS

SCALE 1:10 (@24x36)

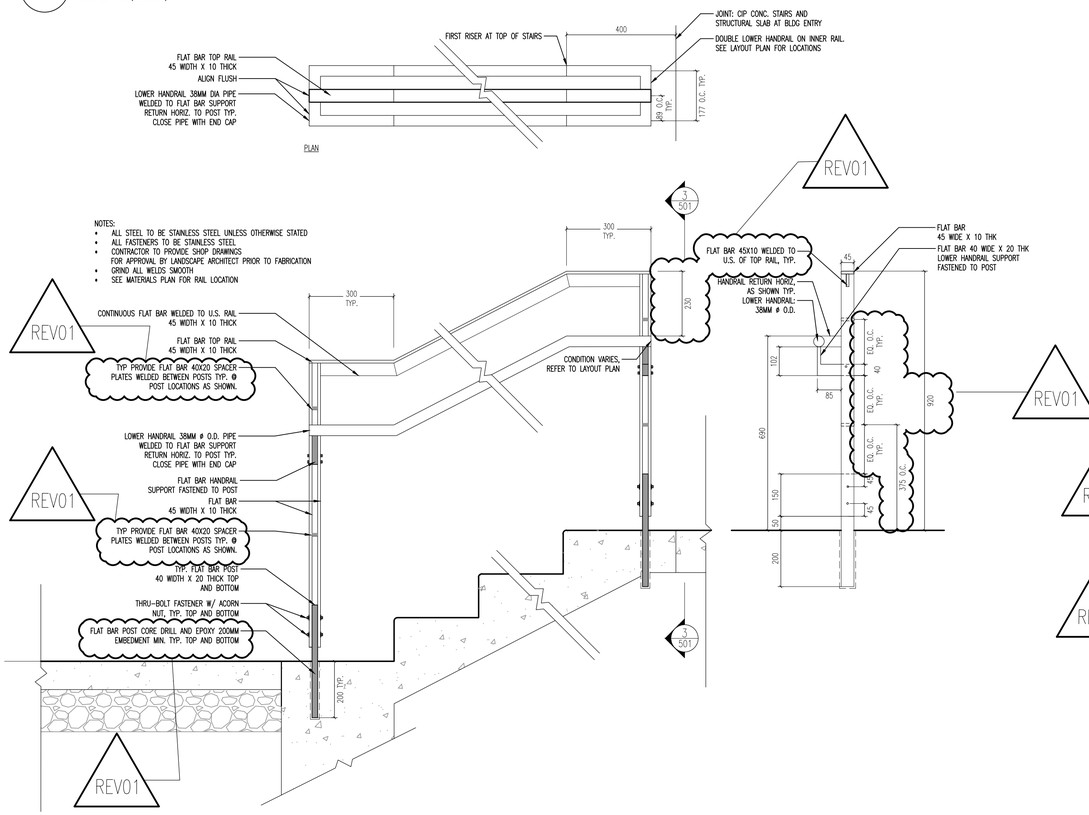

3 S.S. HANDRAIL AT STAIRS

SCALE 1:10 (@24x36)

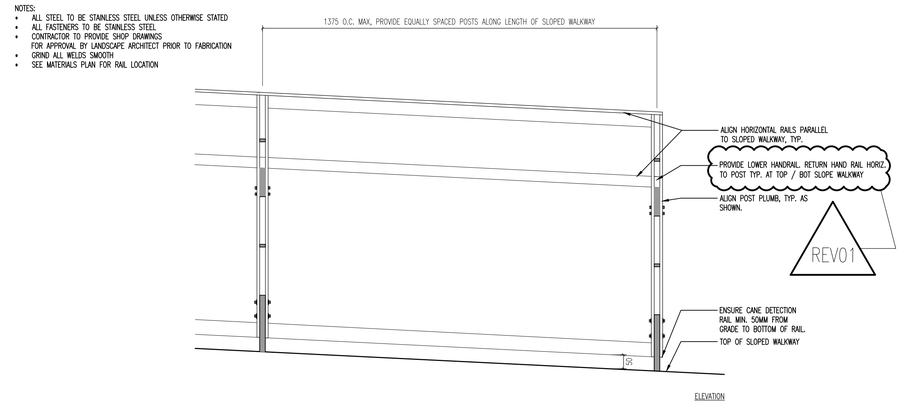

5 S.S. RAILING AT SLOPED WALKWAY

SCALE 1:10 (@24x36)

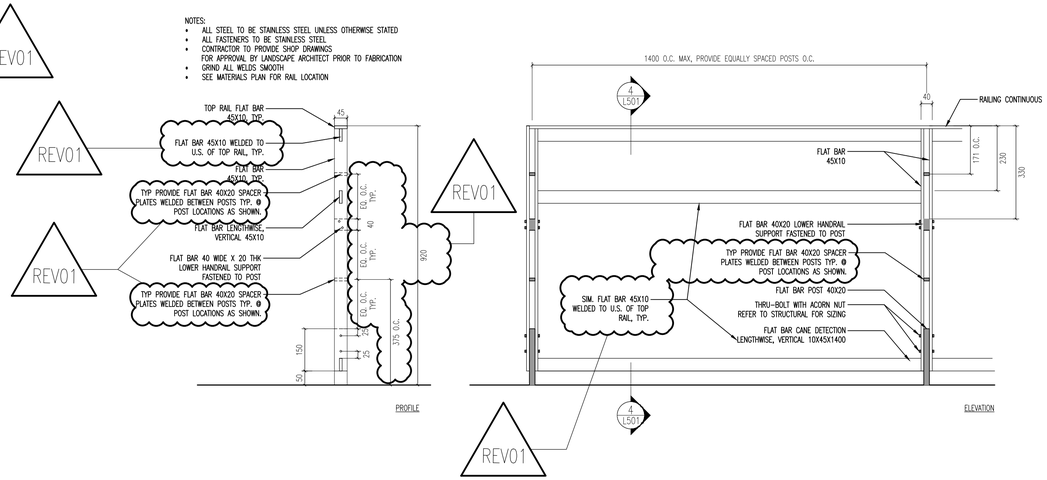

4 S.S. RAILING

SCALE 1:10 (@24x36)

No.	DATE	REVISION / ISSUANCE
5	YY.MM.DD	-
4	YY.MM.DD	-
3	YY.MM.DD	-
2	16.08.15	- REV01
1	16.07.15	- ISSUED FOR CONSTRUCTION

Seal

Consultant

PLAIN PROJECTS
LANDSCAPE ARCHITECTURE & ENVIRONMENTAL DESIGN
562 Academy Road / Winnipeg, MB / R3N 0E3
(204) 930 0272 / www.plainprojects.ca

Project

SEVEN OAKS POOL

Sheet Title

DETAIL SECTIONS

Project No. 645-2016

Date JULY 2016

Sheet **L501**