


Issue / rev.

#	date	issue notes
1	2016/08/18	RE-ISSUED FOR CONSTRUCTION
0	2016/07/15	ISSUED FOR CONSTRUCTION

professional seals

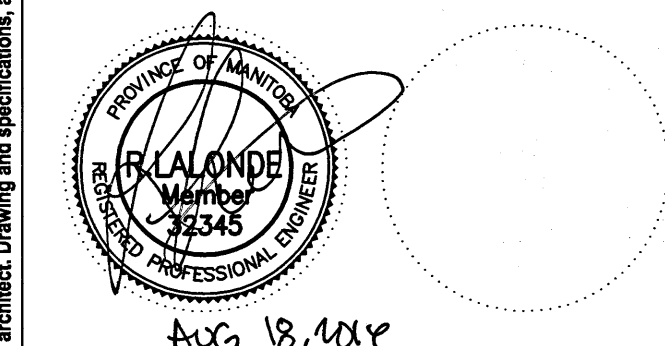

project information

**SEVEN OAKS POOL**

444 Adsum Drive  
Winnipeg, MB  
Canada

client

City of Winnipeg  
4th Floor - 86 King Street  
Winnipeg, MB

drawing information

**ELECTRICAL MEZZANINE POWER & SYSTEMS - NEW**

drawn by: GCN

approved by: *[Signature]*

scale: AS NOTED



date issued: 2016.07.15

proj. #: 14-1736-008

rev. #: R-1


**NOTES:**

1. NEW STROBE TO BE MOUNTED ABOVE EXISTING GLAZING.
2. PROVIDE A SECOND FIRE ALARM CABINET FOR ADDITIONAL POWER FOR NOTIFICATION DEVICES. CONTRACTOR TO CONFIRM FIRE ALARM EQUIPMENT WITH MANUFACTURER.
3. PROVIDE AND INSTALL PLYWOOD BACKING WITHIN THE ELECTRICAL ROOM 200.
4. THIS AREA HAS A NUMBER OF WALLS THAT ARE NOT SHOWN. CONTRACTOR TO COORDINATE ALL STROBE LOCATIONS ON SITE.
5. PROVIDE TELECOM OUTLET COMPLETE WITH THREE (3) CAT 6 CABLES AND TERMINATIONS FOR SECURITY PANEL. INSTALL IN THE MEZZANINE OFFICE ROOM. COORDINATE MOUNTING LOCATION WITH OWNER PRIOR TO INSTALLATION.

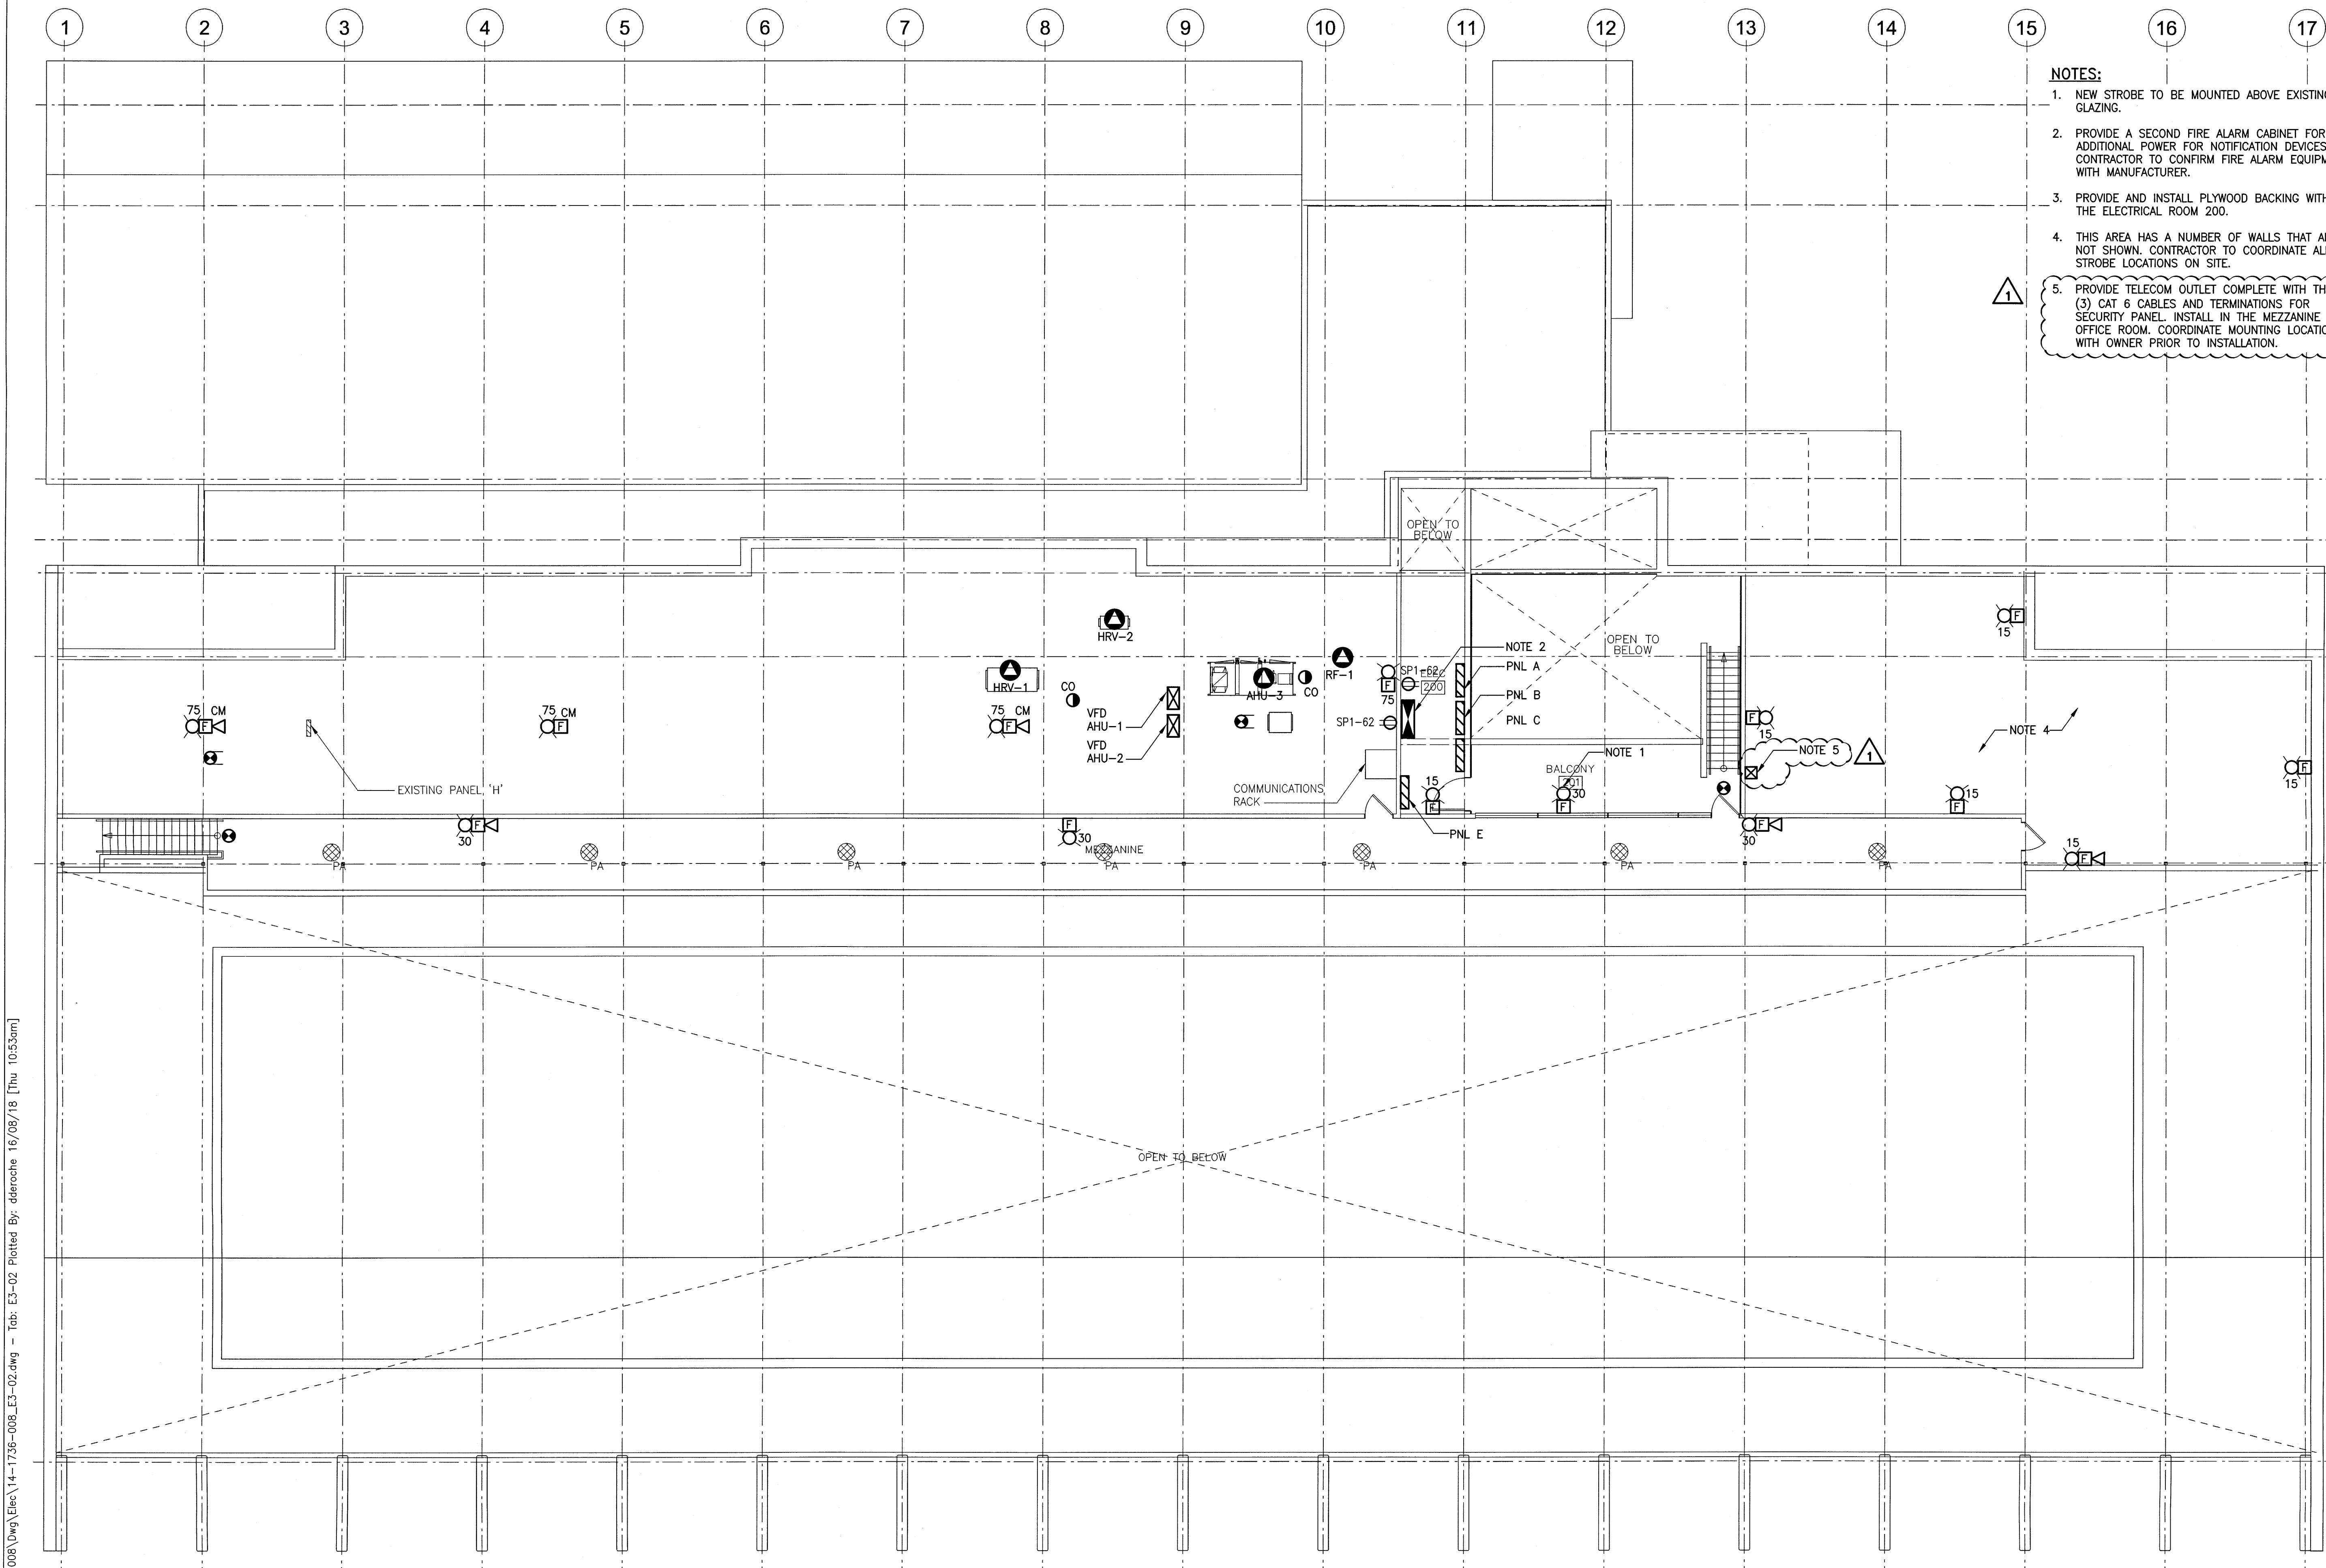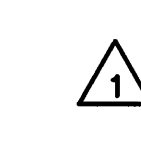

**1** MEZZANINE POWER/SYSTEMS PLAN - NEW

2000 0 2000 4000 6000 8000  
SCALE: 1:100mm (24"x36")

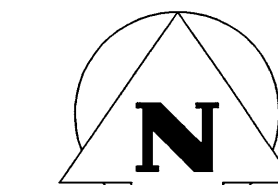

File Name: P:\Projects\2014\14-1736-008\Dwg\Elec\14-1736-008\_E3-02.dwg - Tab: E3-02 Plotted By: dderoché 16/08/18 [Thu 10:53am]

This drawing must not be scaled. The contractor shall verify all dimensions and other data on site prior to commencement of work. All discrepancies, errors, and omissions are to be reported to the architect. Drawing and specifications, as instruments of service, are the property of the architect, and when made, must bear his name. All prints to be returned to the architect on request. No reproduction may be made without the permission of the architect, and when made, must bear his name.

**SEVEN OAKS POOL RENOVATION & ADDITION**  
BID OPPORTUNITY NO. 645-2016