




A MECHANICAL ROOF TOP EQUIPMENT RECEPTACLE
SCALE: 1:10mm (24"x36")

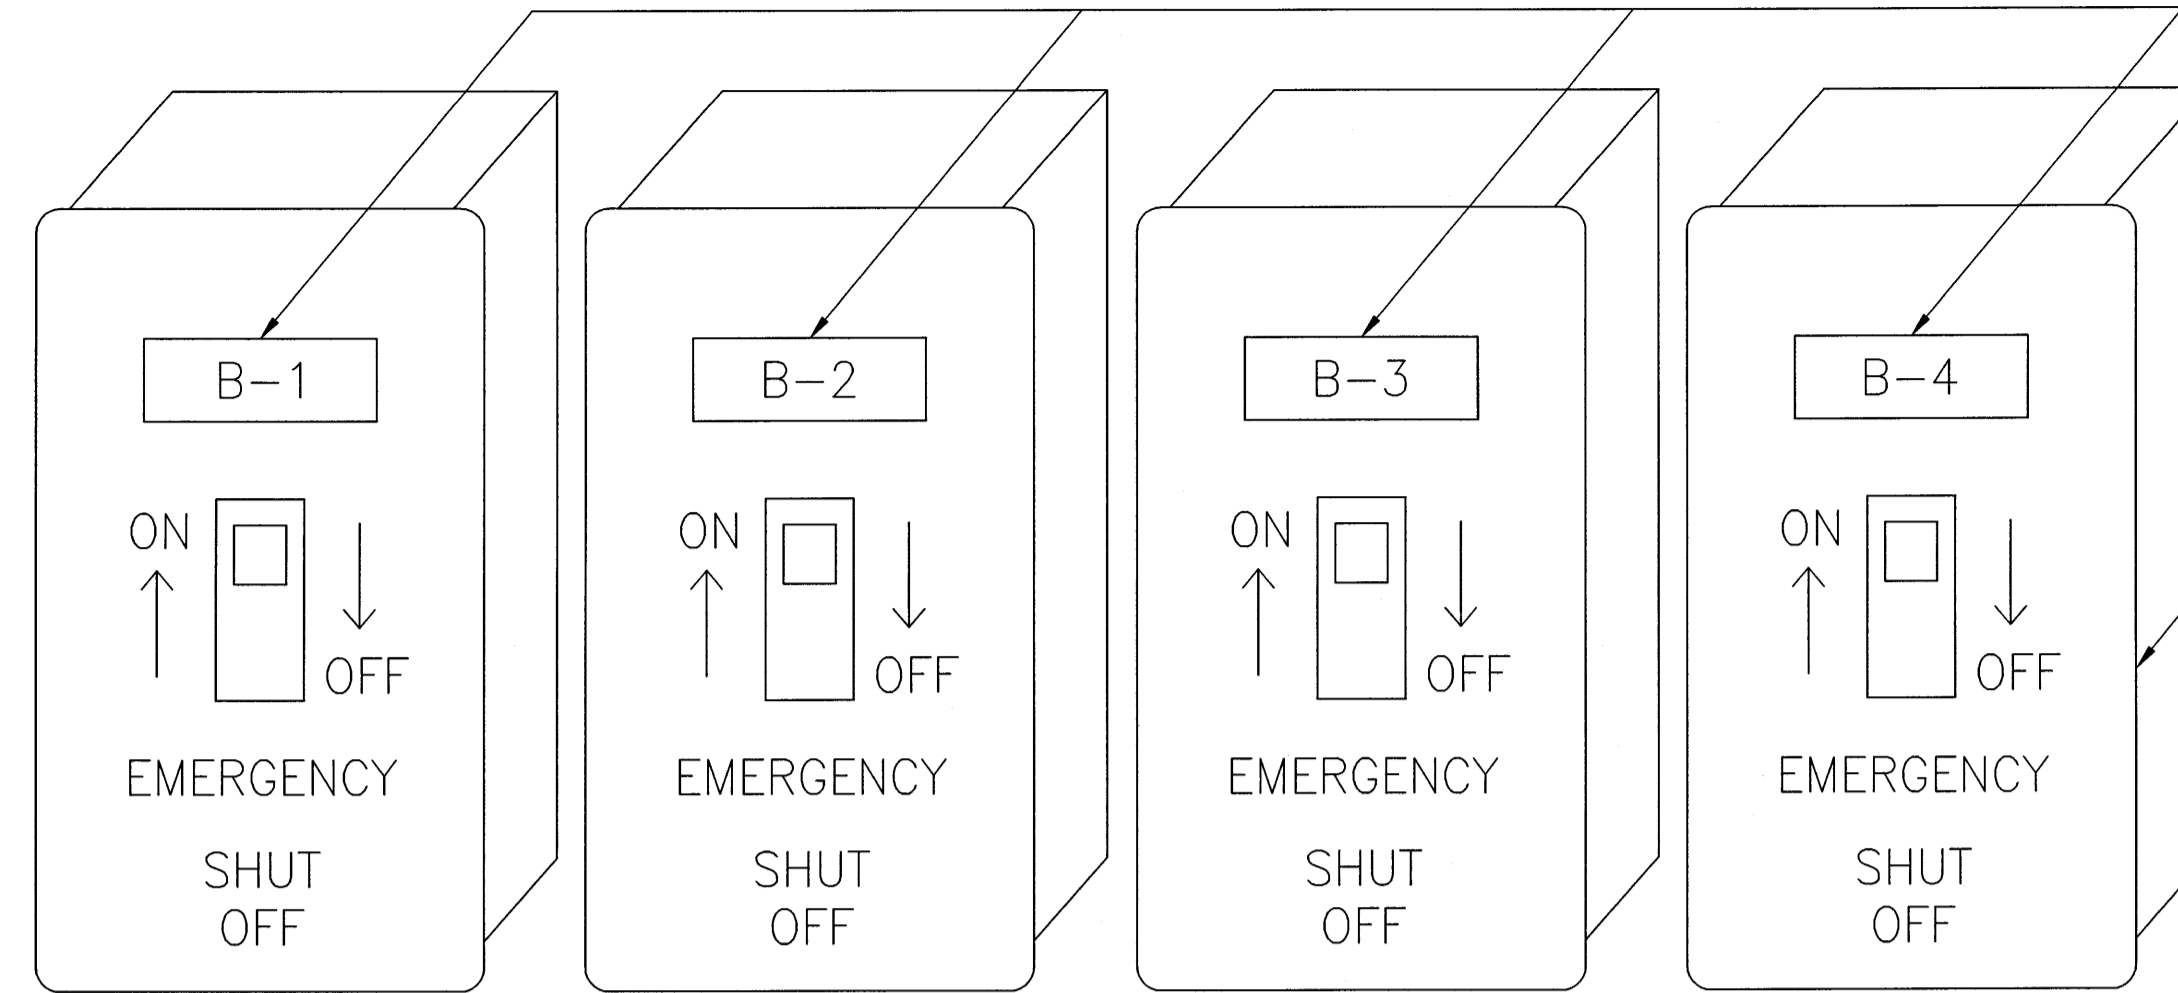


B BOILER GAS EMERGENCY SHUT OFF SWITCH
SCALE: N.T.S.

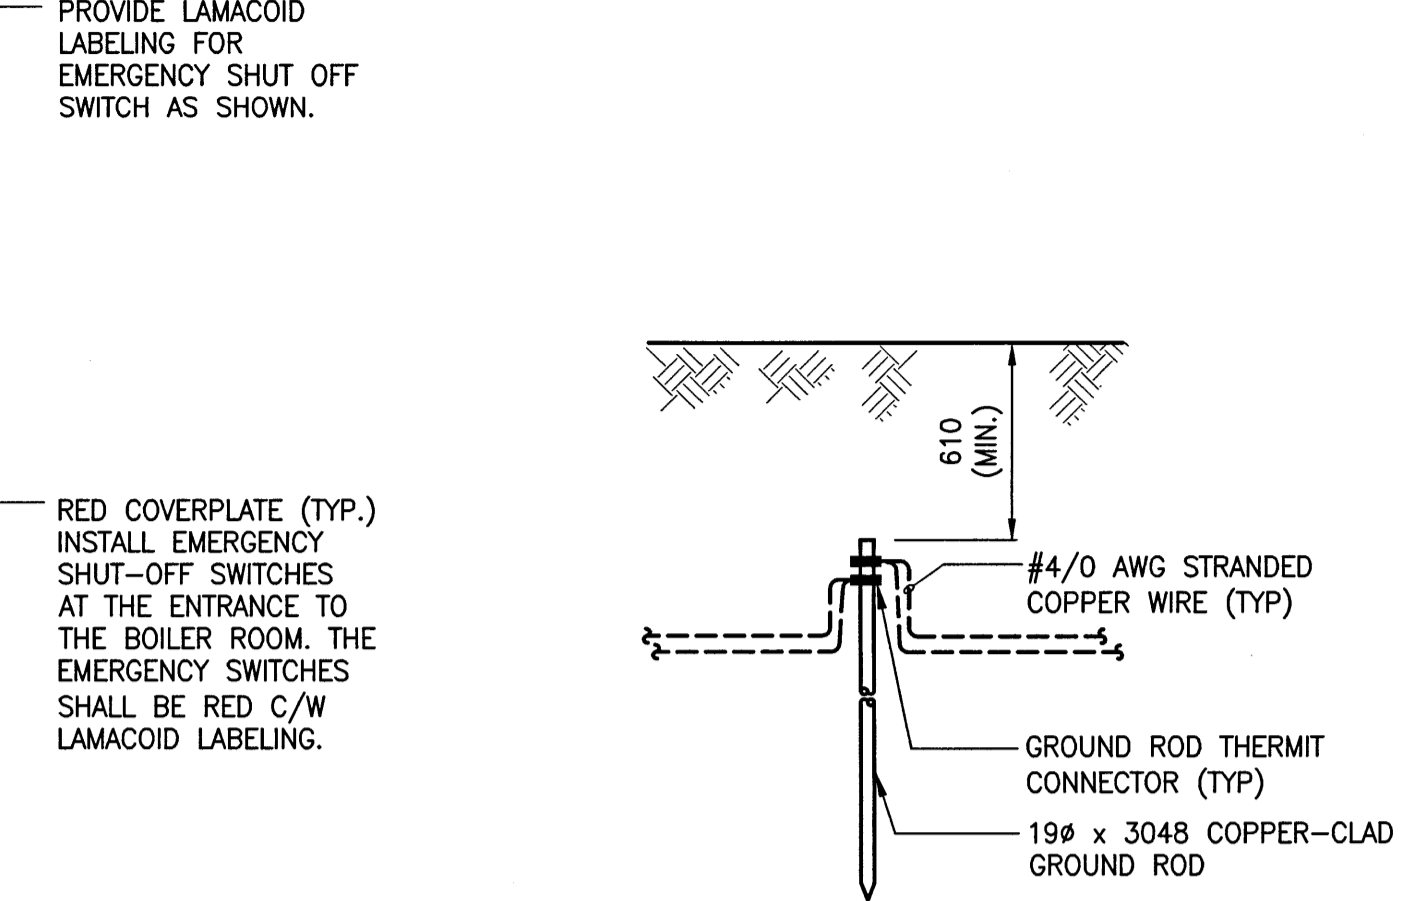

E GROUND ROD DETAIL
SCALE: N.T.S.

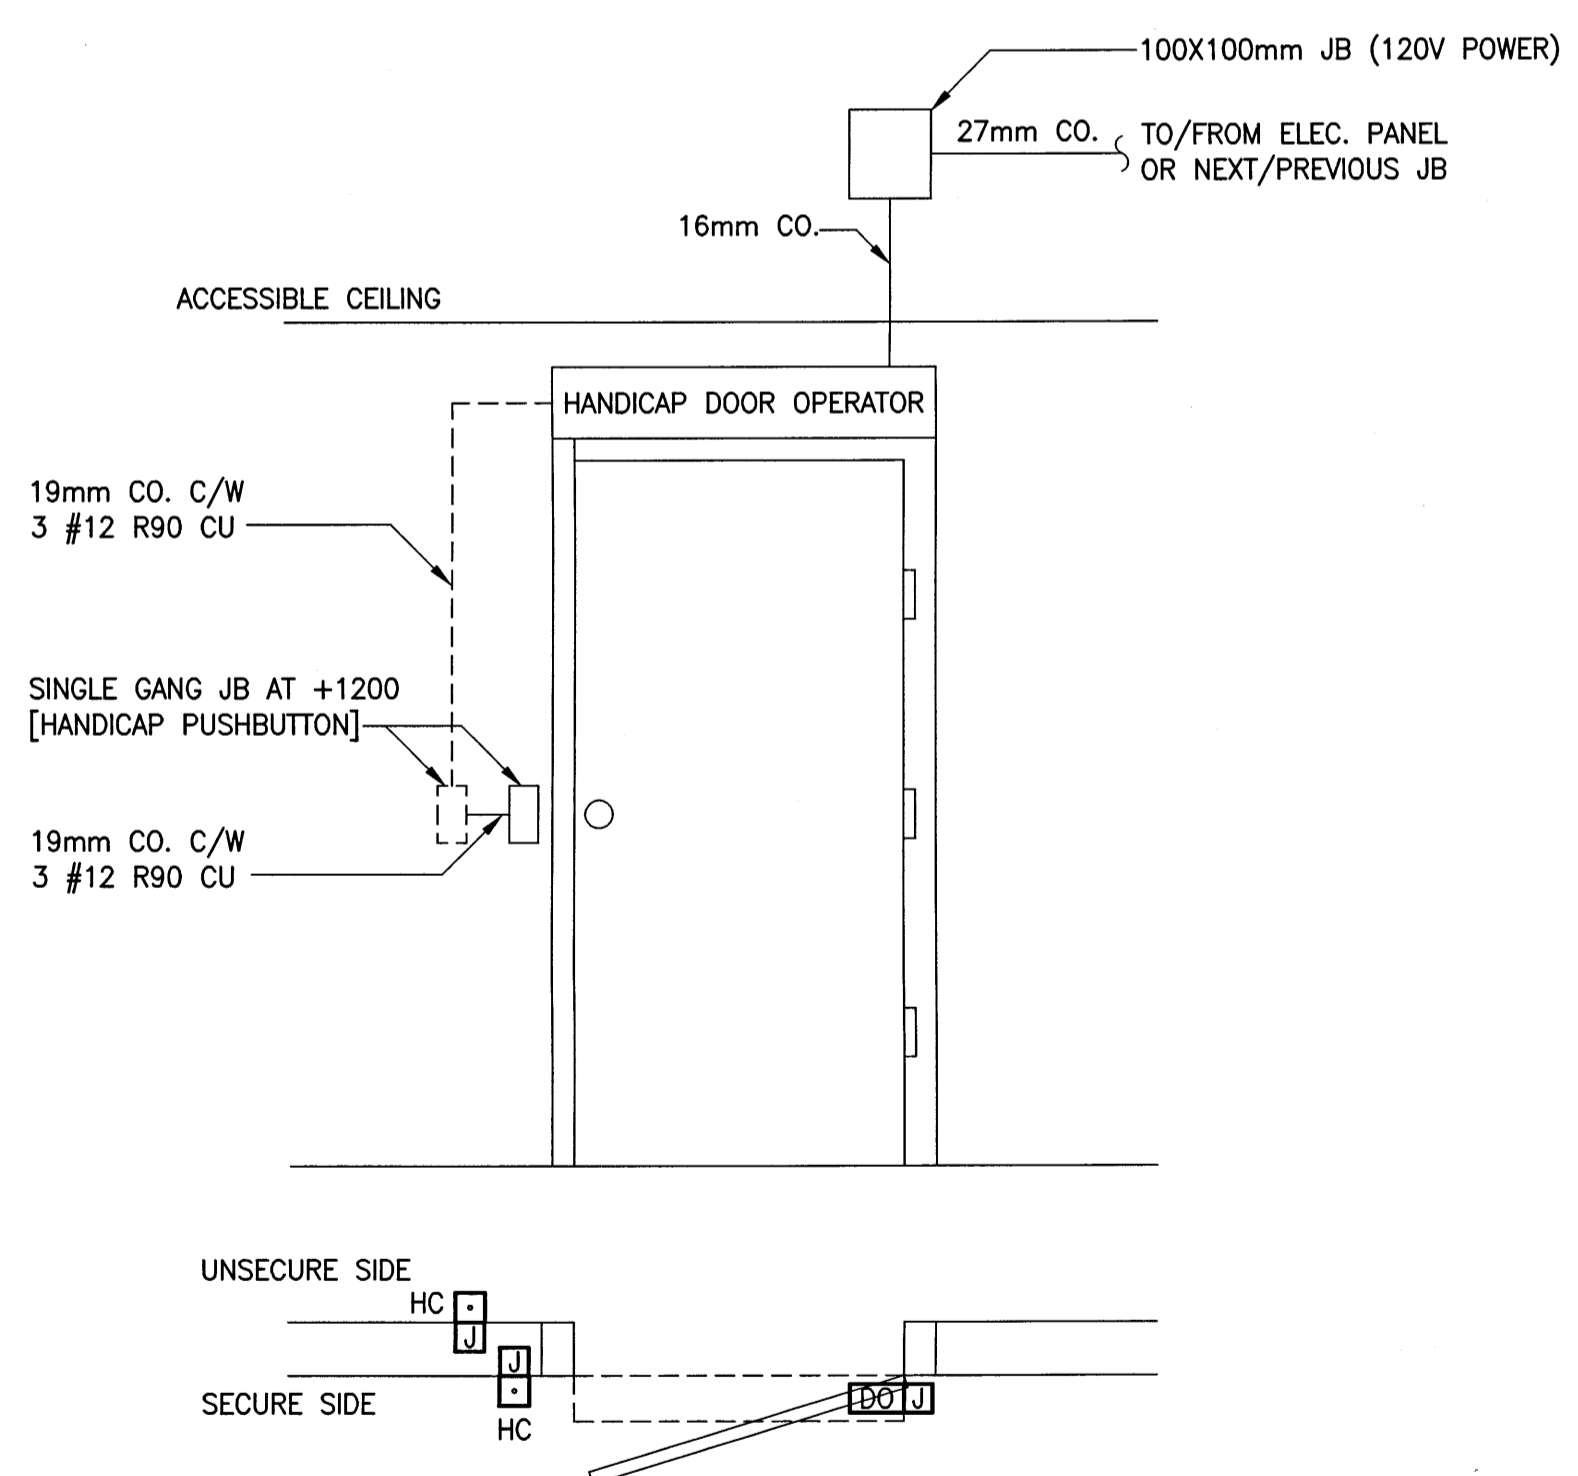


C HANDICAP DOOR DETAIL
SCALE: N.T.S.

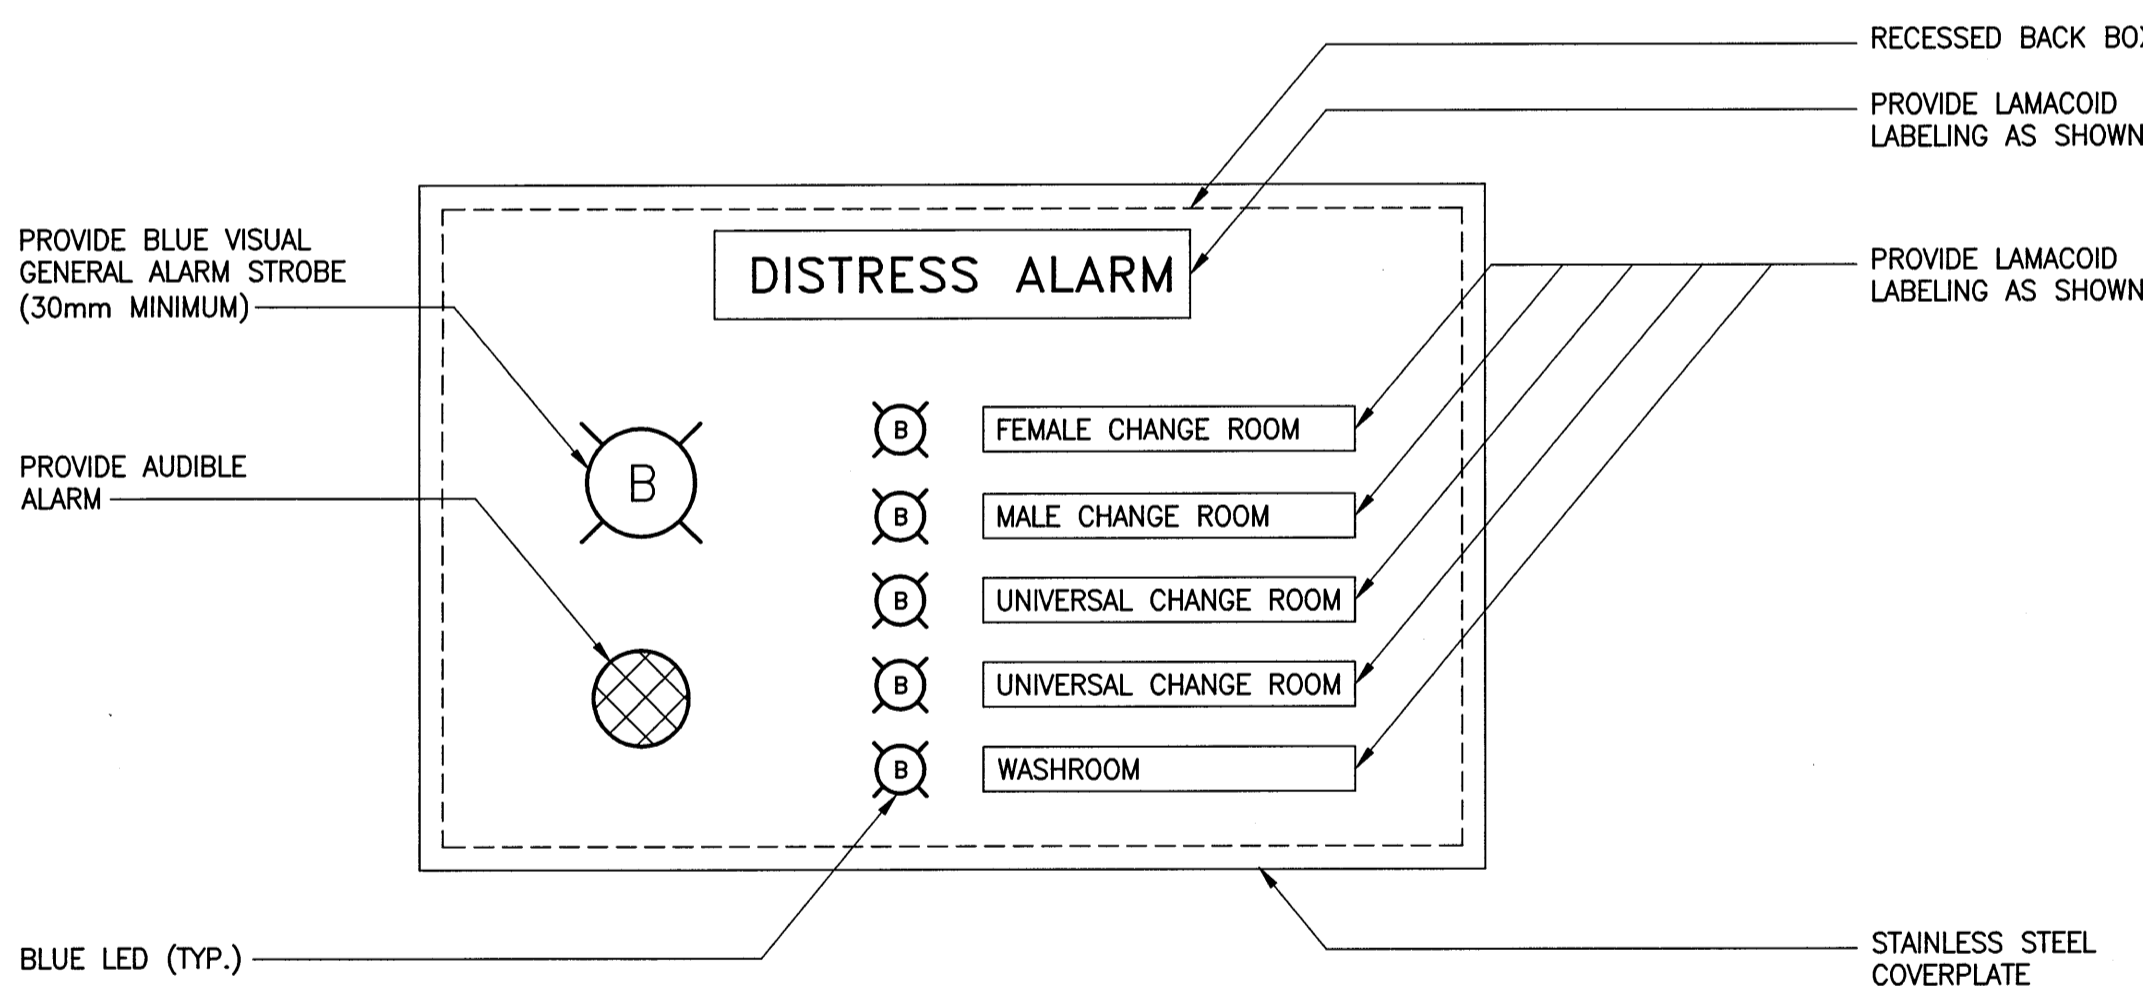


- NOTES:**
1. CONTRACTOR SHALL SUBMIT SHOP DRAWINGS INCLUDING WIRING DIAGRAM TO ENGINEER FOR REVIEW.
 2. PUSH BUTTONS IN WASHROOMS/CHANGE ROOMS SHALL TRIGGER THE GENERAL ALARM STROBE, THE AUDIBLE ALARM AND THE LED INDICATING THAT ROOM ON THE CONTROL PANEL.
 3. RESET OF ALARM IS ONLY BY THE SAME PUSHBUTTON IN THE WASHROOM/CHANGE ROOM.
 4. CONTRACTOR TO ENSURE CONTROL PANEL IS FULLY RECESSED AND FLUSH WITH NEW WALL FINISH. BACK BOX SHALL BE COORDINATED AT TIME OF SHOP DRAWING STAGE WITH GENERAL CONTRACTOR PRIOR TO WALL CONSTRUCTION.

D DISTRESS ALARM PANEL
SCALE: N.T.S.

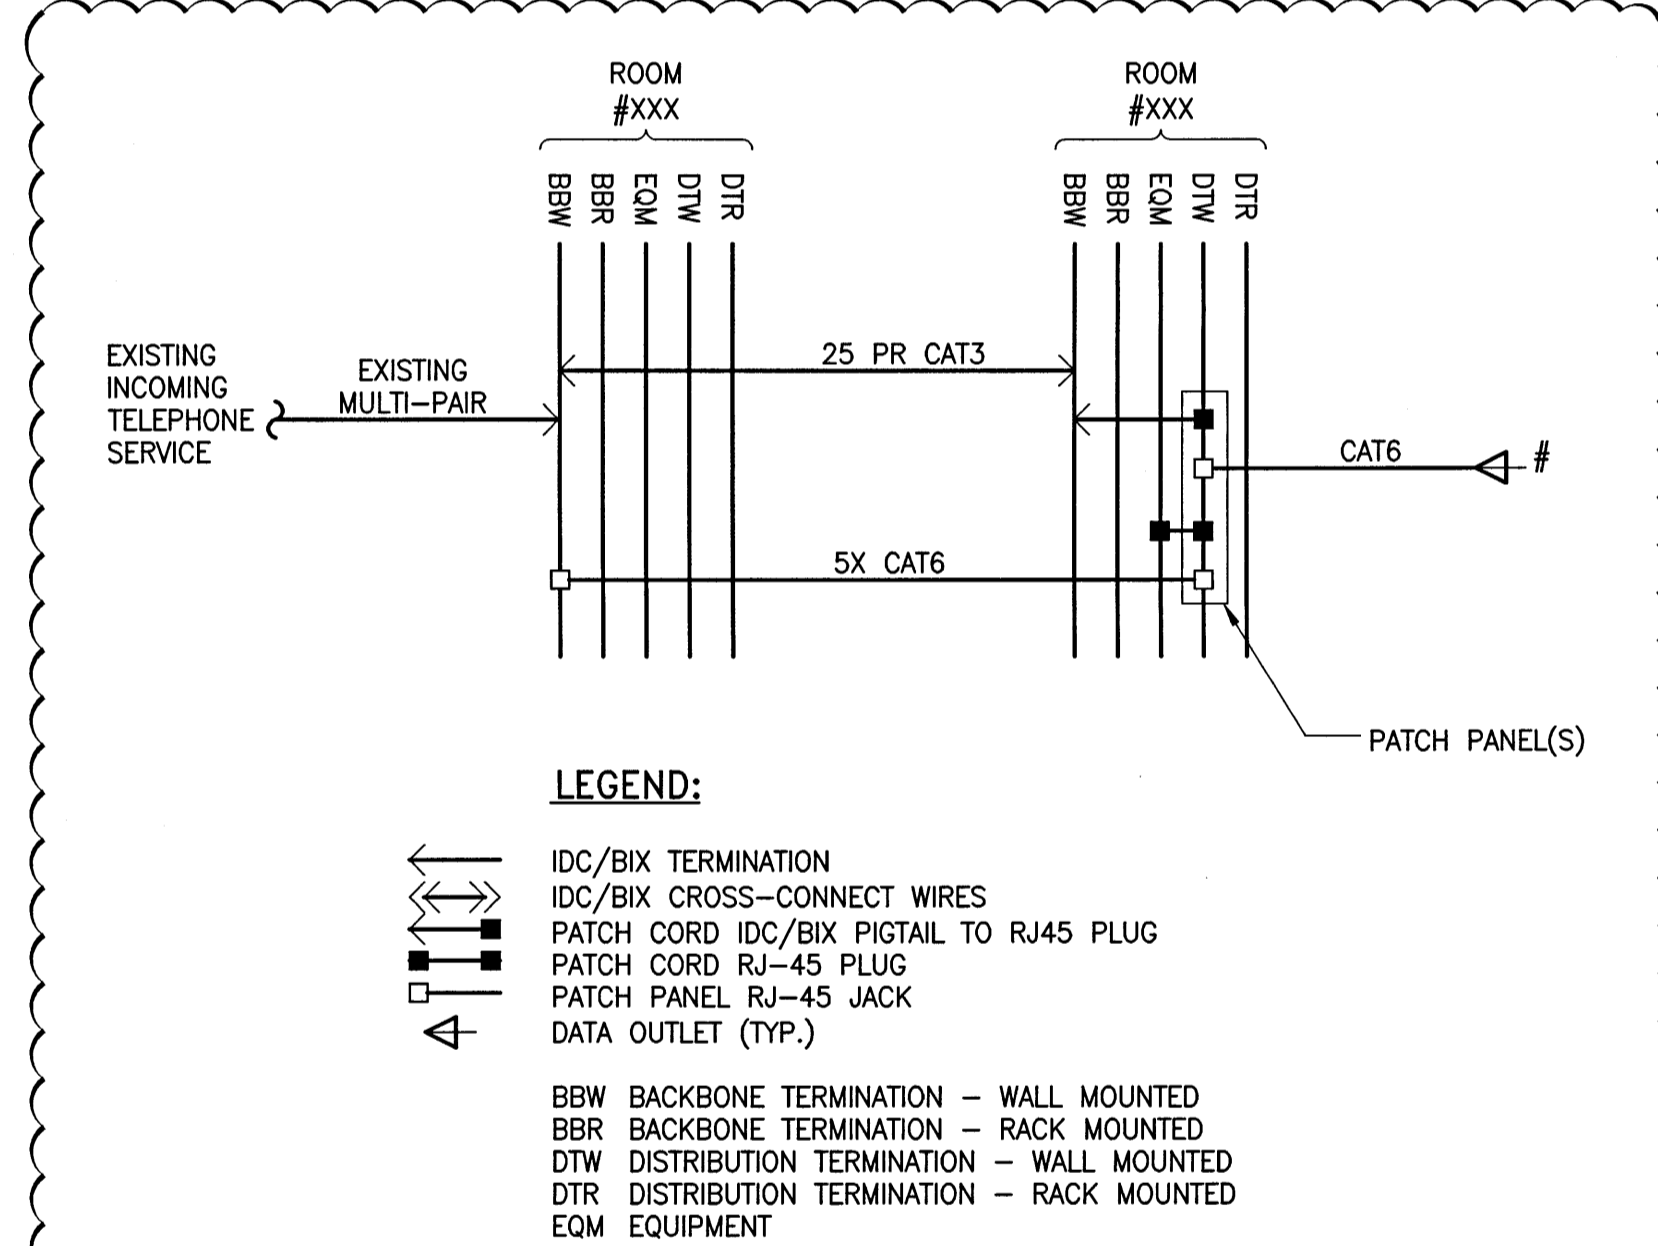

F STRUCTURED CABLING SCHEMATIC
SCALE: N.T.S.

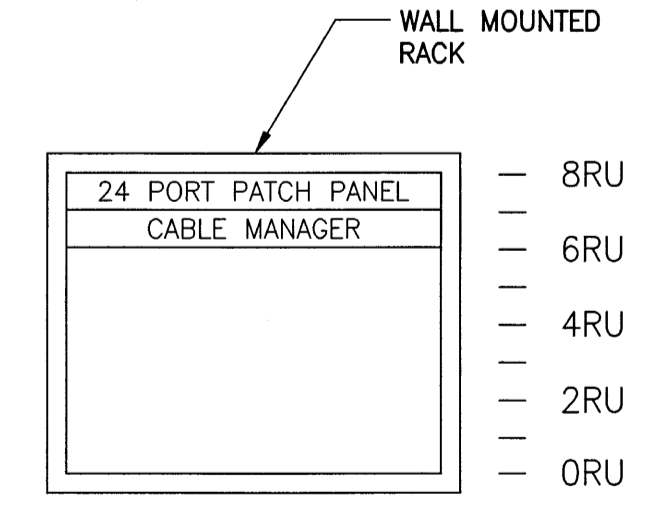

G PROPOSED TELECOM RACK LAYOUT
SCALE: N.T.S.

Issue / rev.	date	issue notes
2	2016/08/18	RE-ISSUED FOR CONSTRUCTION
1	2016/07/27	RE-ISSUED FOR CONSTRUCTION
0	2016/07/15	ISSUED FOR CONSTRUCTION

professional seals

project information

SEVEN OAKS POOL

444 Adsum Drive
Winnipeg, MB
Canada

client

City of Winnipeg
4th Floor - 86 King Street
Winnipeg, MB

drawing information

ELECTRICAL SCHEMATIC DIAGRAMS AND DETAILS

drawn by: GCN
approved by: [Signature]
scale: AS NOTED
date issued: 2016.07.15
proj. #: 14-1736-008
rev. #: R-2

SEVEN OAKS POOL RENOVATION & ADDITION
BID OPPORTUNITY NO. 645-2016