KEYNOTES:

1. NOT USED.
2. REMOVE ELECTRIC DUCT HEATERS AND ASSOCIATED DUCT. RETAIN EXISTING 300x300 DUCT.
3. REMOVE DRAINAGE PIPING AND DISPOSE OF OFF SITE. CAP REMAINING PIPING AND PATCH HOLES IN FLOOR.
4. EXISTING WATER SERVICE TO BE MODIFIED. REFER TO DRAWING M2-00 FOR DETAILS.
5. REMOVE AND RELOCATE TRAPS & VENTS SUCH THAT NEW VENT PIPING IS ROUTED UP THROUGH THE ROOF THROUGH NEW PARTITION WALLS.

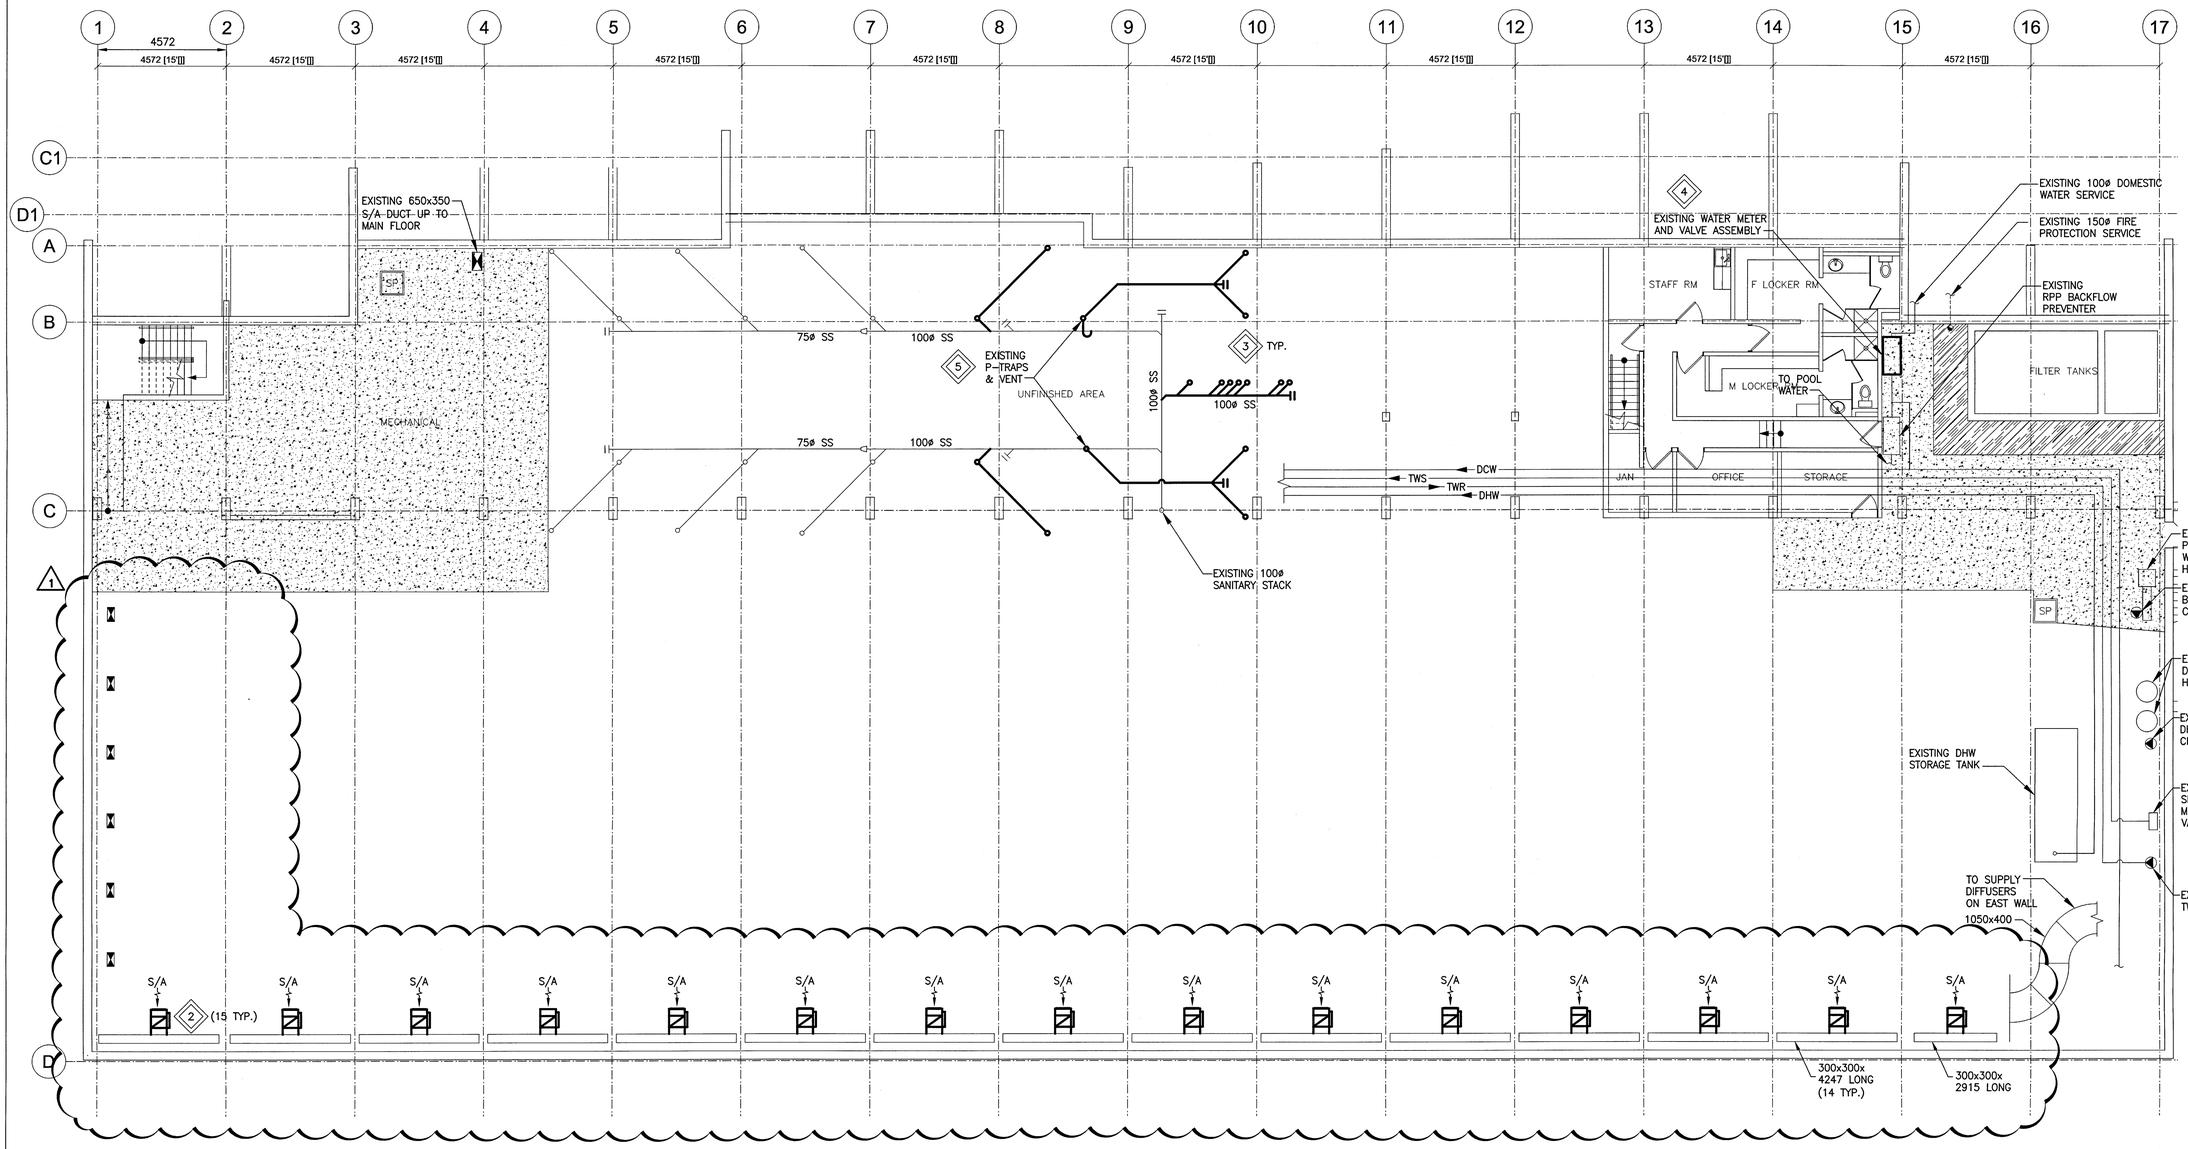

1 BASEMENT PLAN – PLUMBING AND HVAC DEMO
SCALE: 1:100

SCALE VERIFIED BY: AHC

APEGM Certificate of Authorization KGS Group No. 245

This drawing must not be scaled. The contractor shall verify all dimensions and other data on site prior to commencement of work. All discrepancies, errors, and omissions are to be reported to the architect. Drawing and specifications, as instruments of service, are the property of the architect, the copyright in this same being reserved to him. No reproduction may be made without the permission of the architect, and when made, must bear his name. All prints to be returned to the architect on request.

PRAIRIE ARCHITECTS INC.
Creating Sustainable Futures
300 - 141 Bannatyne Ave., Winnipeg, MB, R3B 0R3
telephone 204.956.0938 fax 204.943.5597
web www.prairiearchitects.ca

KGS GROUP CONSULTING ENGINEERS

issue / rev.

#	date	issue notes
1	2016/08/18	RE-ISSUED FOR CONSTRUCTION
0	2016/07/15	ISSUED FOR CONSTRUCTION

professional seals

PROVINCE OF MANITOBA T.S. Hu CORDEN Member 30527 REGISTERED PROFESSIONAL ENGINEER Aug. 18/16

project information

SEVEN OAKS POOL

444 Adsum Drive
Winnipeg, MB
Canada

client

City of Winnipeg
4th Floor - 86 King Street
Winnipeg, MB

drawing information

SEVEN OAKS POOL RENOVATION & ADDITION

BID OPPORTUNITY NO. 645-2016

MECHANICAL
BASEMENT FLOOR PLAN
PLUMBING AND HVAC - DEMO

drawn by: RLR
approved by:
scale: AS NOTED
date issued: 2016.08.18
proj. #: 14-1736-008
rev. #: R-1

M1
00

Printed on post-consumer recycled content paper.

FileName: P:\Projects\2014\14-1736-008\Dwg\Mech\14-1736-008_M1-00.dwg - Tab: M1-00 Plotted By: dderoche 16/08/18 [Thu 10:51am]