


#	date	issue notes
2	2016/08/18	RE-ISSUED FOR CONSTRUCTION
1	2016/07/27	RE-ISSUED FOR CONSTRUCTION
0	2016/07/15	ISSUED FOR CONSTRUCTION

professional seals

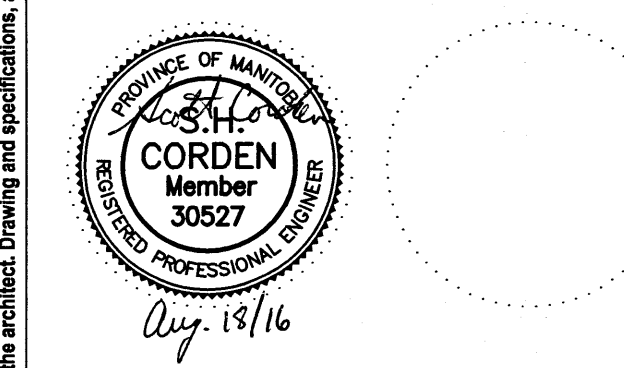

project information

SEVEN OAKS POOL
444 Adsum Drive
Winnipeg, MB
Canada

client



City of Winnipeg
4th Floor - 86 King Street
Winnipeg, MB

drawing information

MECHANICAL MAIN FLOOR PLAN NEW PLUMBING

drawn by: RLR
approved by: [Signature]
scale: AS NOTED
date issued: 2016.08.18
proj. #: 14-1736-008
rev. #: R-2

SEVEN OAKS POOL RENOVATION & ADDITION
BID OPPORTUNITY NO. 645-2016

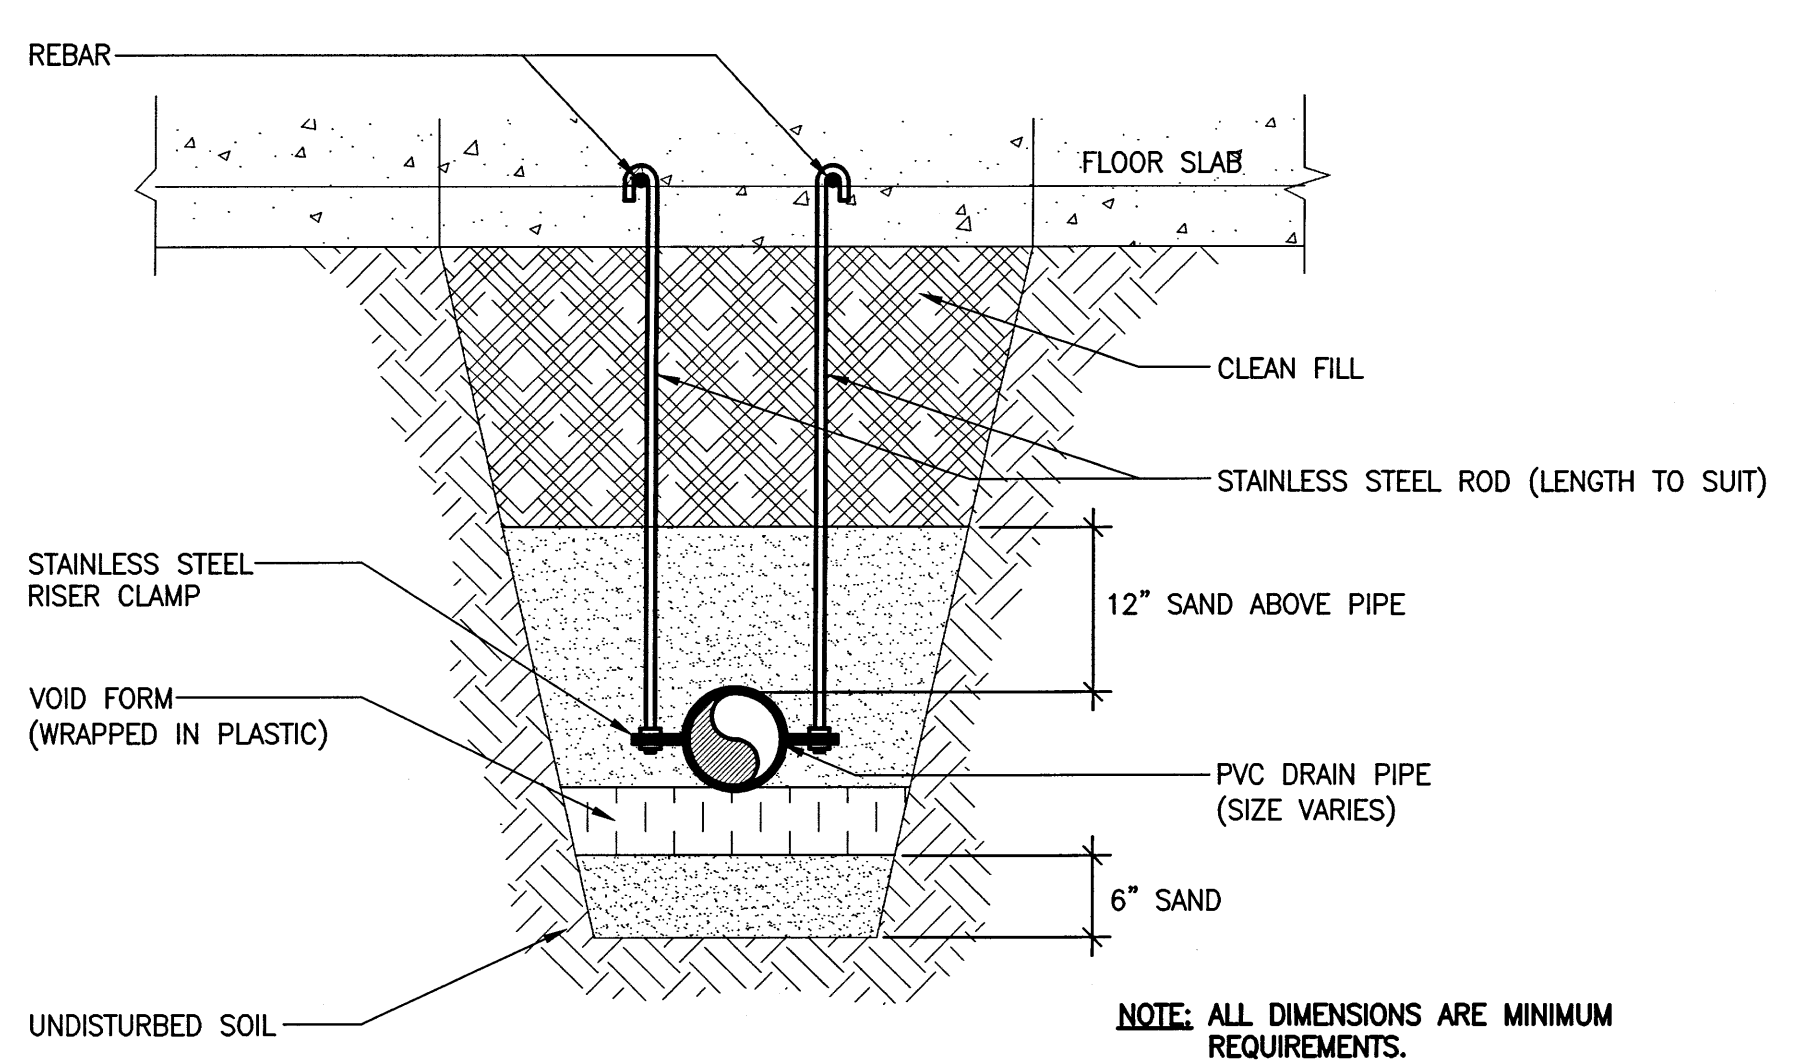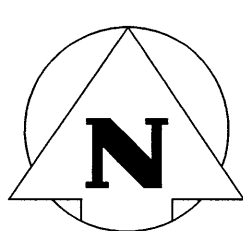


2 UNDER FLOOR PIPING SUPPORT DETAIL
SCALE: N.T.S.

LEGEND:

- | | | | |
|------|------------------------------------|-------|-------------------------------|
| P 1 | WATER CLOSET | P 9 | STANDARD FLOOR DRAIN |
| P 2 | BARRIER FREE WATER CLOSET | P 10 | DRINKING FOUNTAIN (SPASH PAD) |
| P 3 | LAVATORY | P 10g | DRINKING FOUNTAIN (LOBBY) |
| P 4 | WALL MOUNTED BARRIER FREE LAVATORY | P 11 | WALL HYDRANT |
| P 5 | URINAL | P 12 | COUNTER MOUNTED SINK (MPR) |
| P 6 | SHOWER | P 13 | NON-FREEZE WALL HYDRANT |
| P 6a | SHOWER (TEMPERED WATER) | P 14 | JANITOR SINK |
| P 7 | BARRIER FREE SHOWER | P 15 | POOL GUTTER DRAIN |
| P 8 | LINEAR FLOOR DRAIN | | |


KEYNOTES:

- 1 NEW SANITARY SEWER PIPING HUNG FROM CEILING IN BASEMENT BELOW.
- 2 PROVIDE NEW DOMESTIC WATER AND SEWER CONNECTIONS FOR NEW SINK. TIE INTO NEAREST LOCATION IN BASEMENT CEILING SPACE.
- 3 LOCATE DRAIN NEAR AHU DRAIN PAN AND GAS CONDENSATE DRAIN. RUN ALL CONDENSATE DRAINS FROM AHU-1 TO DRAIN COMPLETE WITH P-TRAP (INDIRECT CONNECTION).
- 4 RUN RAIN WATER LEADER IN CEILING SPACE INTO STORAGE ROOMS. MOUNT NEW RAIN WATER LEADER TIGHT TO WALL IN LOCATIONS SHOWN.
- 5 DRAINAGE PIPING TO BE HUNG FROM STRUCTURAL SLAB. REFER TO DETAIL 2 ON THIS DRAWING.
- 6 INSULATED, TEMPERED, COPPER WATER SUPPLY LINE TO BE RUN DOWN TO BASEMENT THROUGH CONCRETE BLOCK WALL. PUSH BUTTON TO BE MOUNTED ON A 100mmX100mm POWDER COATED 316 STAINLESS STEEL PLATE AND SECURED TO THE CONCRETE BLOCK WALL. CONTROL WIRING FOR BUTTON TO BE INSTALLED IN CONDUIT IN CONCRETE BLOCK WALL TO PERMIT FUTURE REPLACEMENT. SEAL ALL JOINTS/CONNECTIONS WATER TIGHT. REFER TO DETAIL 4 ON DWG. M5-02.
- 7 SUPPLY AND INSTALL TRENCH DRAIN SYSTEM AROUND PERIMETER OF SPLASH PAD. TIE INTO DRAIN PIPING AT LOCATIONS SHOWN. PROVIDE ALL CORNERS AND END CAPS NEEDED FOR INSTALLATION.
- 8 CONTRACTOR TO INSTALL EXTERIOR DRAIN PIPING BELOW AHU. CONFIRM NUMBER OF DRAINS WITH AHU SUPPLIER. CONNECTIONS TO AHU DRAINS SHALL BE DONE THROUGH FLOOR HATCHES IN AHU. ALL PIPING SHALL BE INSULATED IN ACCORDANCE WITH DETAIL 2 ON DRAWING M5-02. ALL TRAPS SHALL BE INSTALLED IN THE BASEMENT TO PREVENT FROM FREEZING.
- 9 SUPPLY AND INSTALL TRENCH DRAINS FOR SPLASH PAD. DRAIN CONNECTIONS TO POOL WATER CIRCULATION SYSTEM BY OTHERS. CONFIRM DRAIN SIZE WITH POOL EQUIPMENT SUPPLIER.
- 10 SUPPLY AND INSTALL POOL GUTTER DRAIN. DRAIN CONNECTIONS TO POOL WATER CIRCULATION SYSTEM BY OTHERS. CONFIRM DRAIN SIZE AND QUANTITY OF DRAINS WITH POOL EQUIPMENT SUPPLIER.

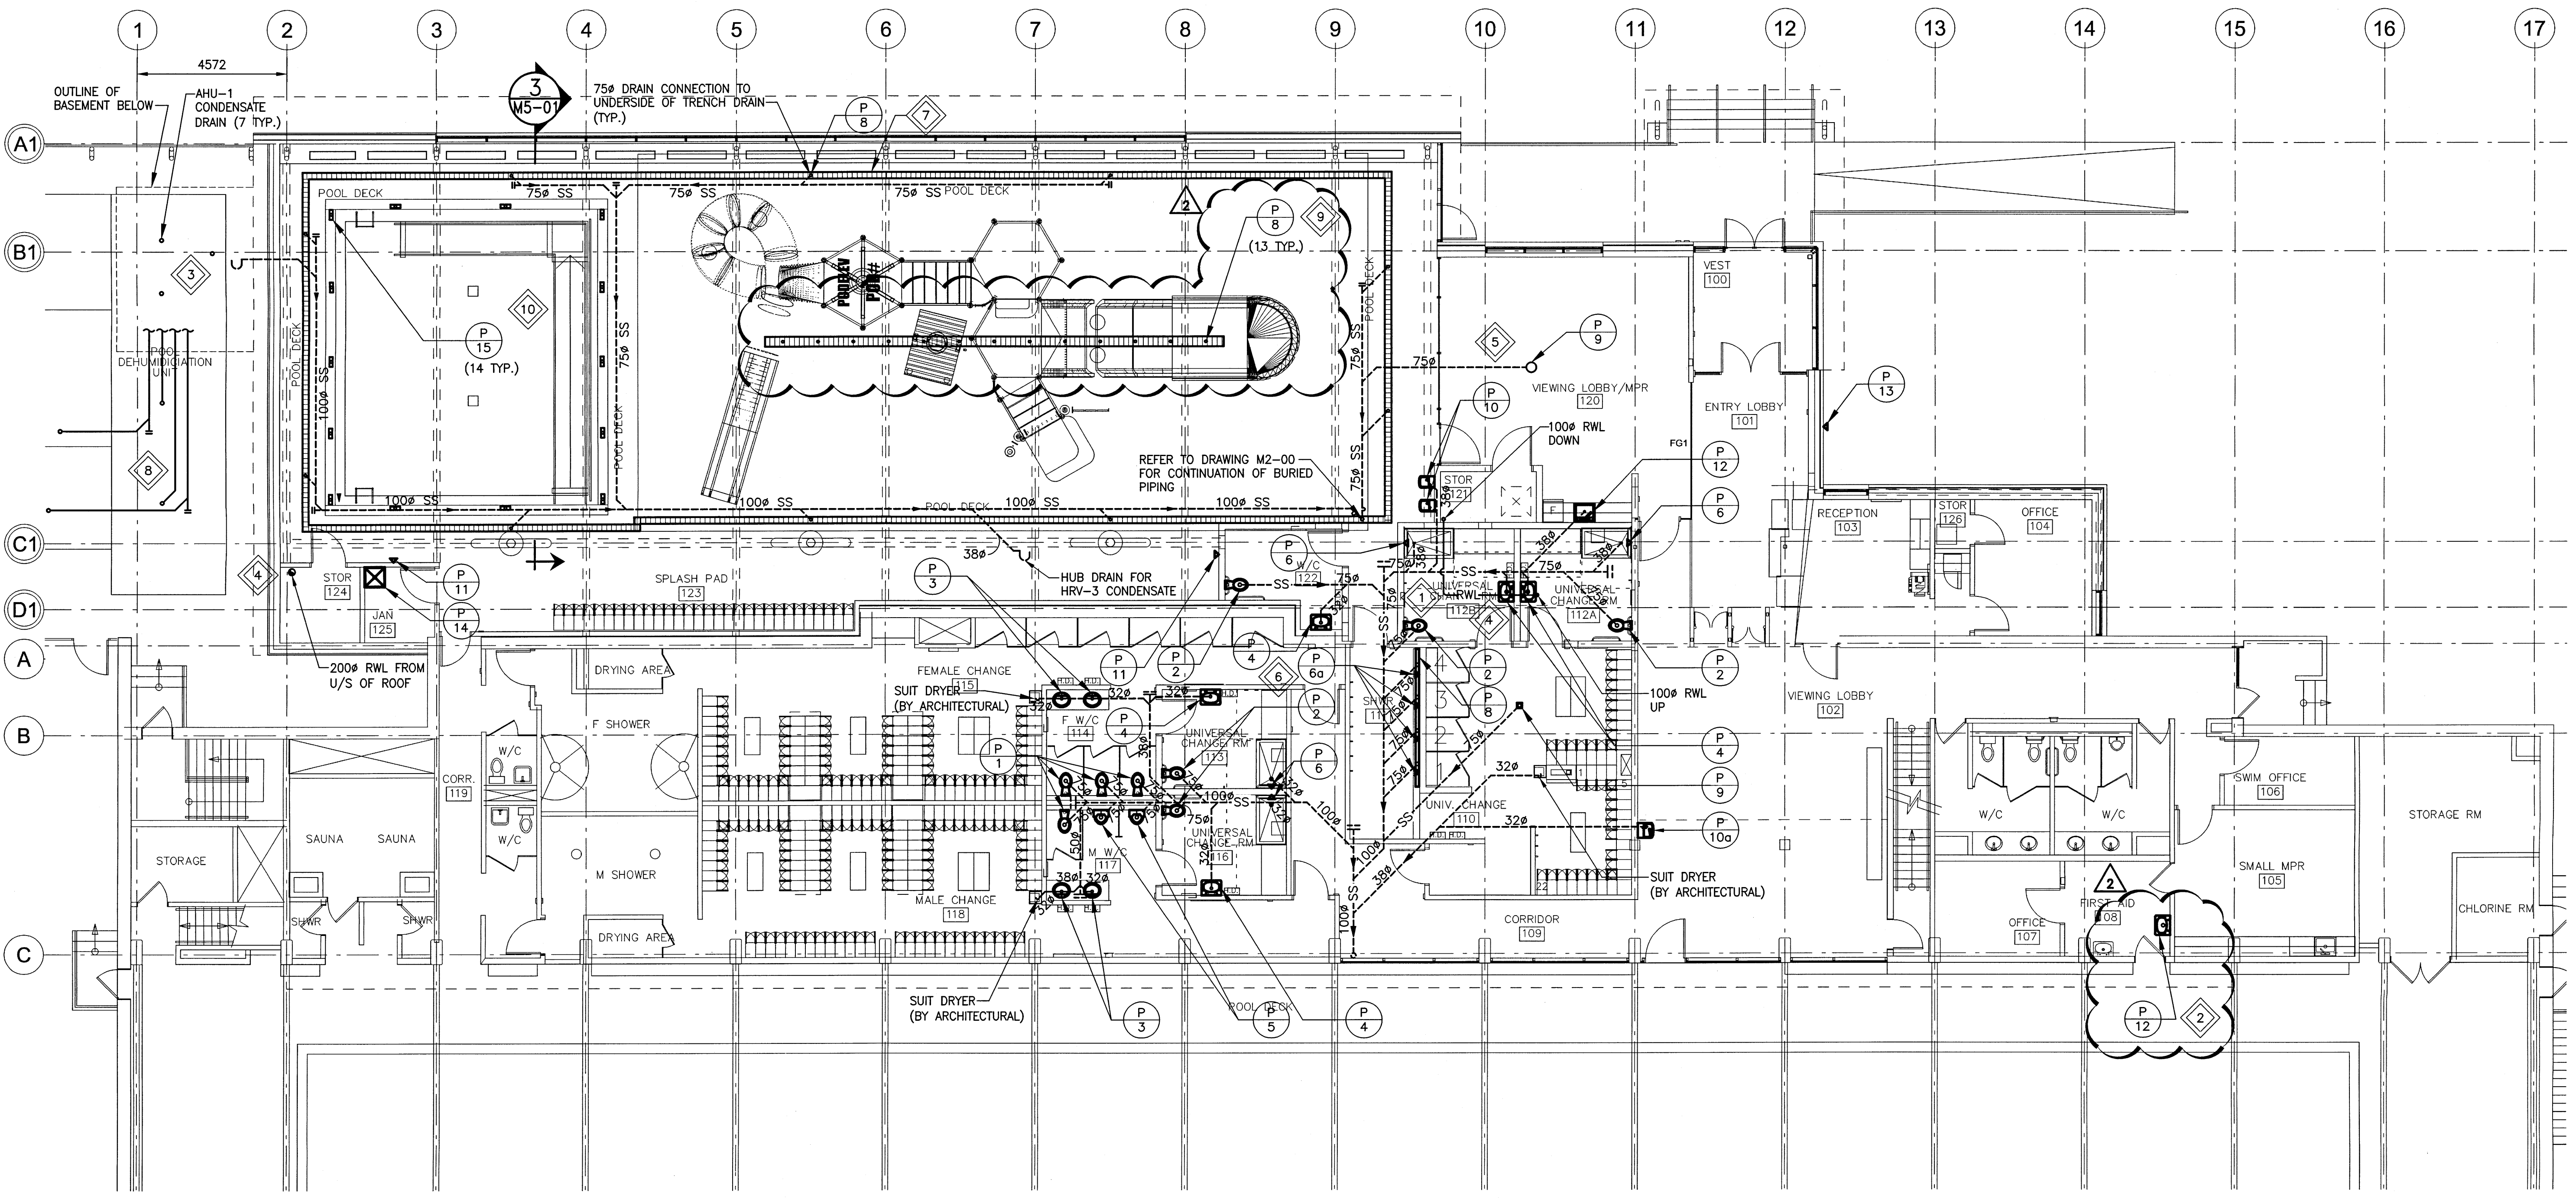

1 MAIN FLOOR PLAN - NEW PLUMBING
SCALE: 1:100

SCALE VERIFIED BY: [Signature]

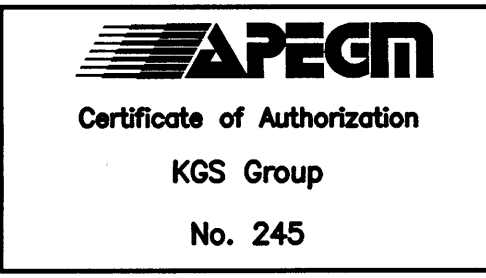

File Name: P:\Projects\2014\14-1736-008\DWG\Mech\14-1736-008_M2-01.dwg - Tab: M2-01 Plotted By: cderoché 16/08/18 [Thu 10:51am]

This drawing must not be scaled. The contractor shall verify all dimensions and other data on the prior to commencement of work. All discrepancies, errors, and omissions are to be reported to the architect. Drawing and specifications, as instruments of service, are the property of the architect. No reproduction may be made without the permission of the architect, and when made, must bear the same. All prints to be returned to the architect on request.