



2 UNIVERSAL CHANGE RM 113, 116, & W/C 114, 117 ENLARGED PLAN
1:50

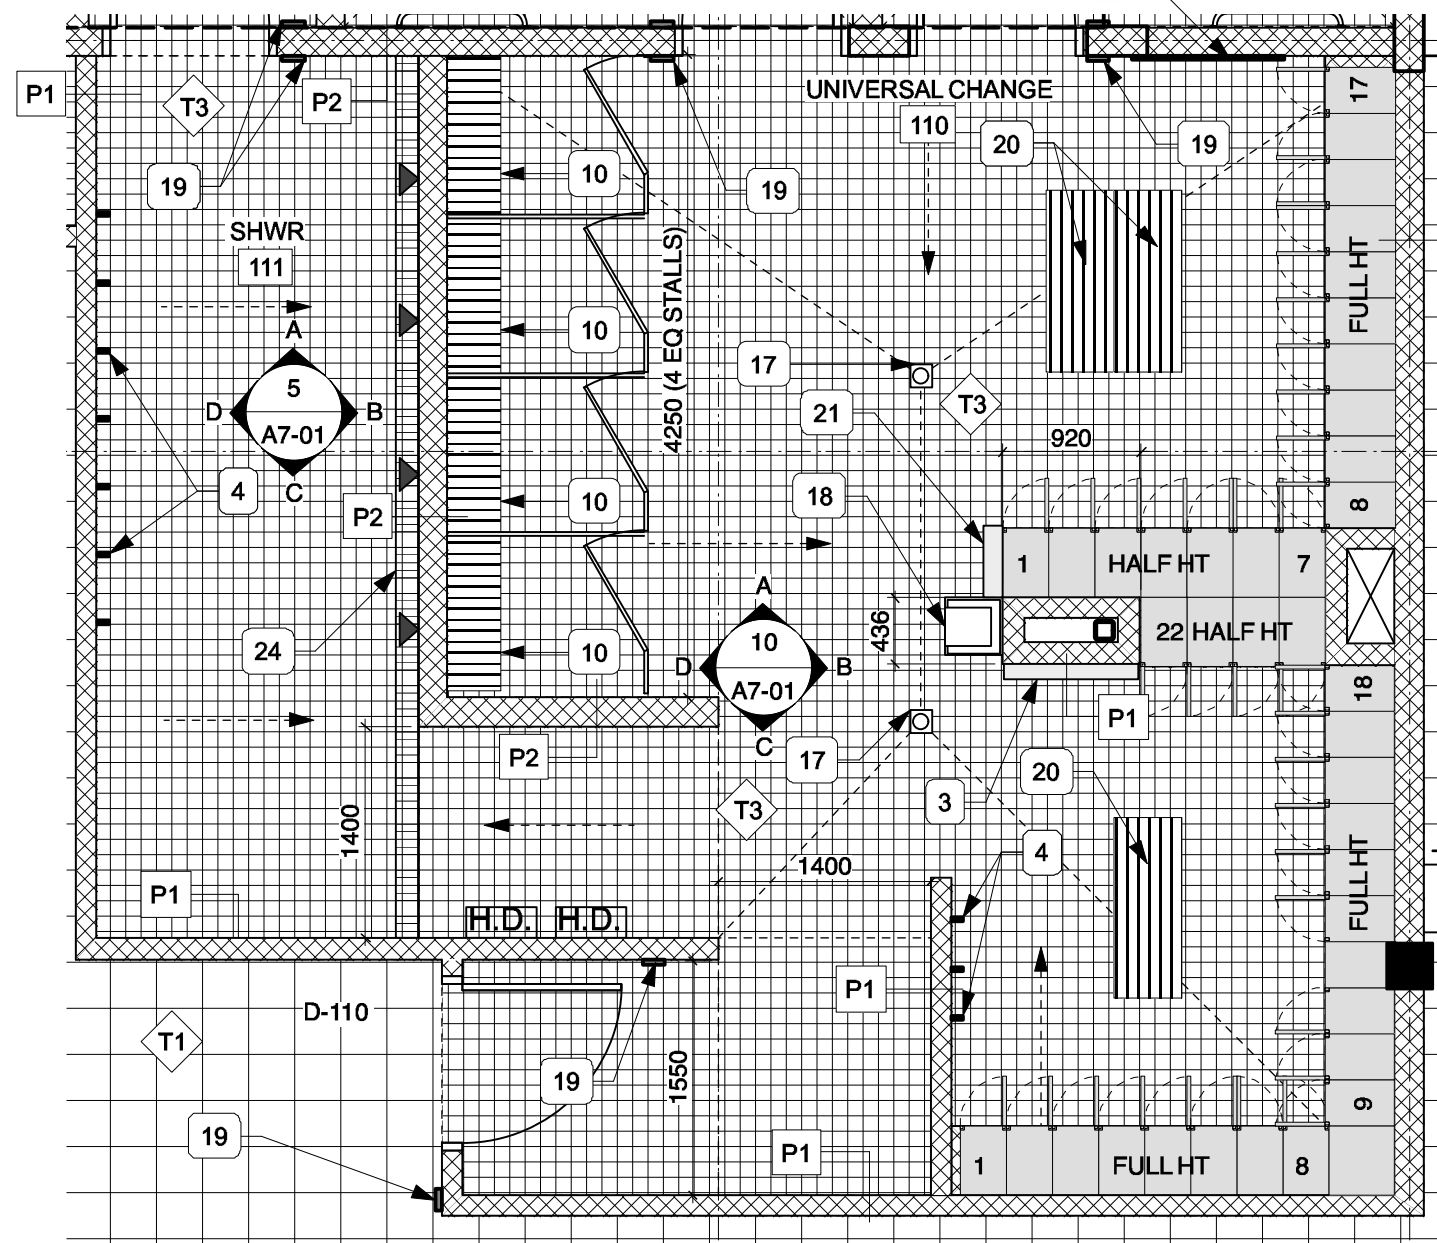

3 UNIVERSAL CHANGE 110, SHWR 111 ENLARGED PLAN
1:50

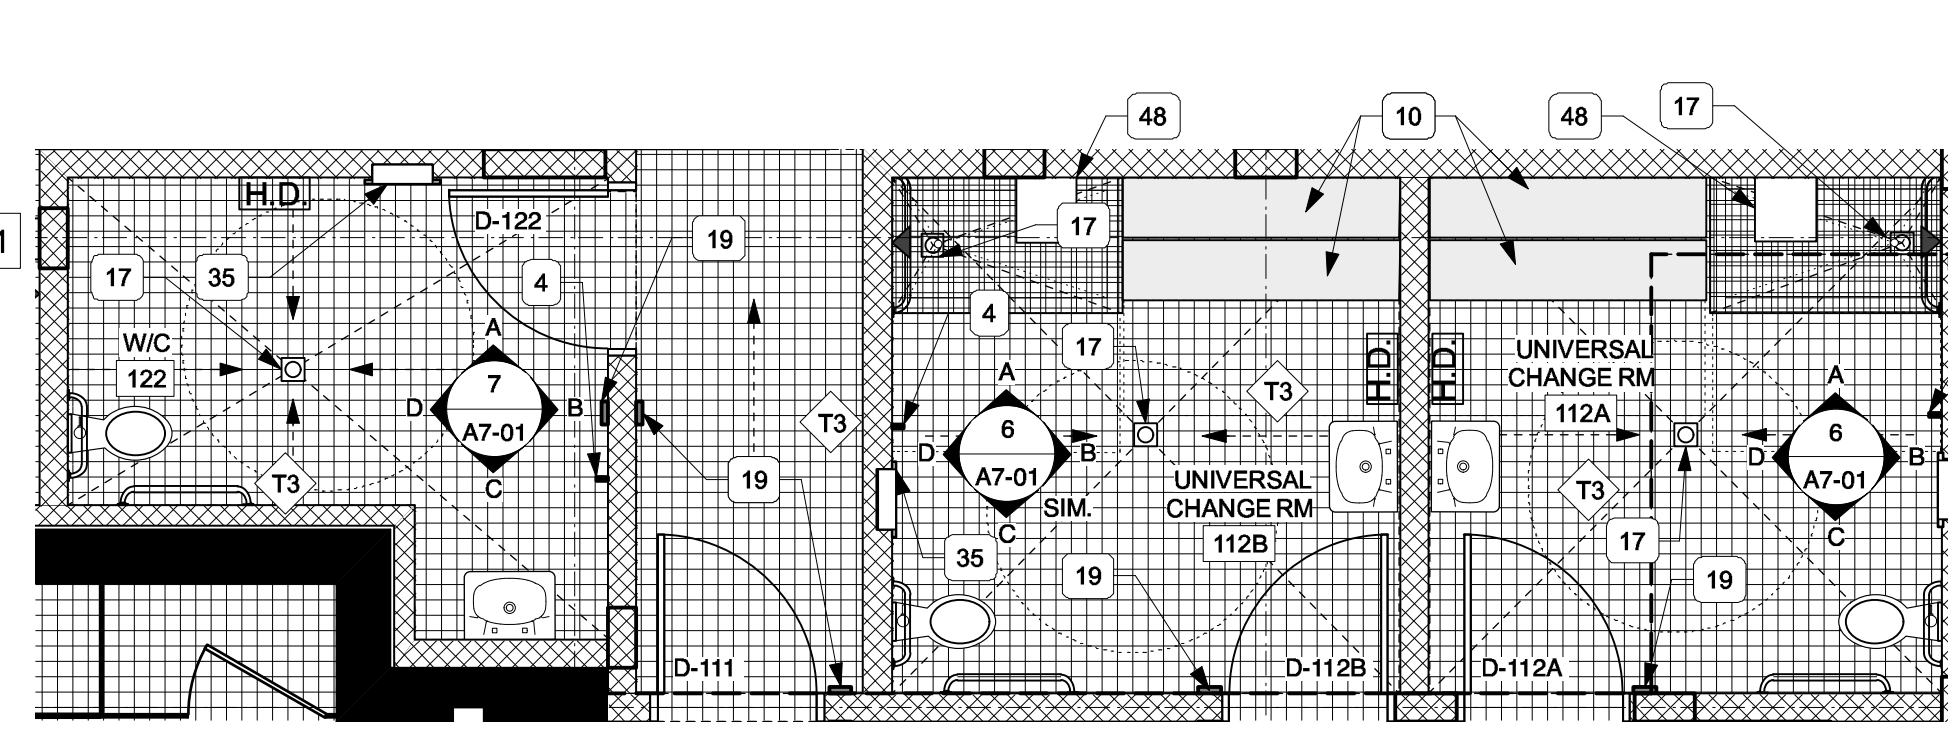


4 UNIVERSAL CHANGE RM 112A, 112B, W/C 122 ENLARGED PLAN
1:50

MAIN FLOOR GENERAL NOTES:

1. PROVIDE CONC CURB UP TO 100 000 LEVEL BELOW ALL CMU WALLS IN SPLASH PAD 123.
 2. PROVIDE MILKWORK OVER ALL HALF HEIGHT LOCKERS AS PER DETAILS ON A8-03.
- LEED PROJECT BOUNDARY
- - - - - 1 HR FIRE SEPARATION

MAIN FLOOR PLAN KEYNOTES:

1. EXISTING DOOR TO REMAIN.
2. MECHANICAL AREA FENCE. REFER TO DETAILS ON EXTERIOR ELEV.
3. BABY CHANGE STATION
4. HOOK
5. POOL ACCESS LADDER
6. EXIST DERESSED DRINKING FOUNTAIN TO REMAIN
7. WALL MOUNTED MIRROR
8. WALL MOUNTED WATER HYDRANT (SEE MECH) & OUTLET (SEE ELEC)
9. LOCATION OF TV MONITOR (NIC) ROUGH-IN ONLY
10. NEW CMU TO BE TOOTHED INTO EXISTING CMU WALL
11. DRINKING FOUNTAIN REFER TO MECH
12. CARD ACCESS (SEE ELEC)
13. COULINTER TOP W/ MIRROR ABOVE
14. CLERESTORY WINDOW ABOVE. REFER TO EXTERIOR ELEVATIONS
15. POOL GUTTER SYSTEM, SEE MECH
16. NEW FLOOR DRAIN, SLOPE FLOOR TO DRAIN AS INDICATED (SEE MECH)
17. SWIMSUIT DRYER (NIC) ROUGH-IN ONLY
18. AUTO-DOOR OPERATOR ACTUATOR BUTTON (COORDINATE W/ ELEC)
19. LOCKER ROOM BENCH
20. P LAM COUNTER ABOVE LOCKERS (REFER TO MILLWORK DETAILS)
21. POOL DEPTH MARKINGS (EVERY 8M)
22. EXIST FIRE EXTINGUISHER CABINET TO REMAIN
23. DECK DRAIN, REFER TO MECH
24. DUAL INTERCONNECT POOL DRAINS
25. PA SYSTEM RACK RE-LOCATED (SEE ELEC)
26. OWNER SUPPLIED SAFE
27. MEZZANINE ABOVE
28. RWL PIPE, REFER TO MECH
29. FIRE DEPARTMENT CONNECTION TO REMAIN (SEE MECH)
30. CCTV CAMERA LOCATION ROUGH-IN (SEE ELEC)
31. CANOPY ABOVE
32. CONCRETE SLOPED WALKWAY, REFER TO STRUCT & LANDSCAPE
33. ENTRY GATE SYSTEM, REFER TO DOOR HARDWARE
34. SEMI-RECESSED WASTE RECEPTACLE
35. SEMI-RECESSED FIRE EXTINGUISHER
36. RE-LOCATED EXIST LOCKER ROOM BENCH
37. INFILL W/ SALVAGED BRICK FROM EXTERIOR TO MATCH EXISTING
38. RE-LOCATE EXISTING WHITEBOARD
39. RE-LOCATE EXIST BENCH FROM VESTIBULE
40. REMOVEABLE SECTION OF ALUM RAILING FOR STRETCHER ACCESS, SECURE PIPE INTO CONCRETE FLOOR W/ MTL SLEEVE
41. FIXED SECTION OF ALUM RAILING
42. 1/2" DIA. ROUND HSS RWL FROM CANOPY. POWDER COAT FINISH TO MATCH CANOPY COLUMNS. TIE INTO IRRIGATION REFER TO DETAILS & LANDSCAPE
43. JANITOR SINK, REFER TO MECH
44. RELOCATE 1 COURSE OF SALVAGED GLAZED CONC. BLOCK UNDER NEW GLAZING B/W GL 11 & 12. REFER TO DETAIL 9 / A5-02. MATCH EXISTING.
45. ROOF HATCH ABOVE. REFER TO SECTION 5/A4-05.
46. REFER TO LANDSCAPE FOR HANDRAIL DETAILS.
47. FOLD-UP SHOWER SEAT
48. 600 X 800 CONC. PATIO RAVERS
49. LINE OF EXISTING CONC. SLAB REFER TO STRUCT
50. REMOVE SALVAGE EXIST. CHANGE PARTITIONS RE-INSTALL AFTER NEW TILE.

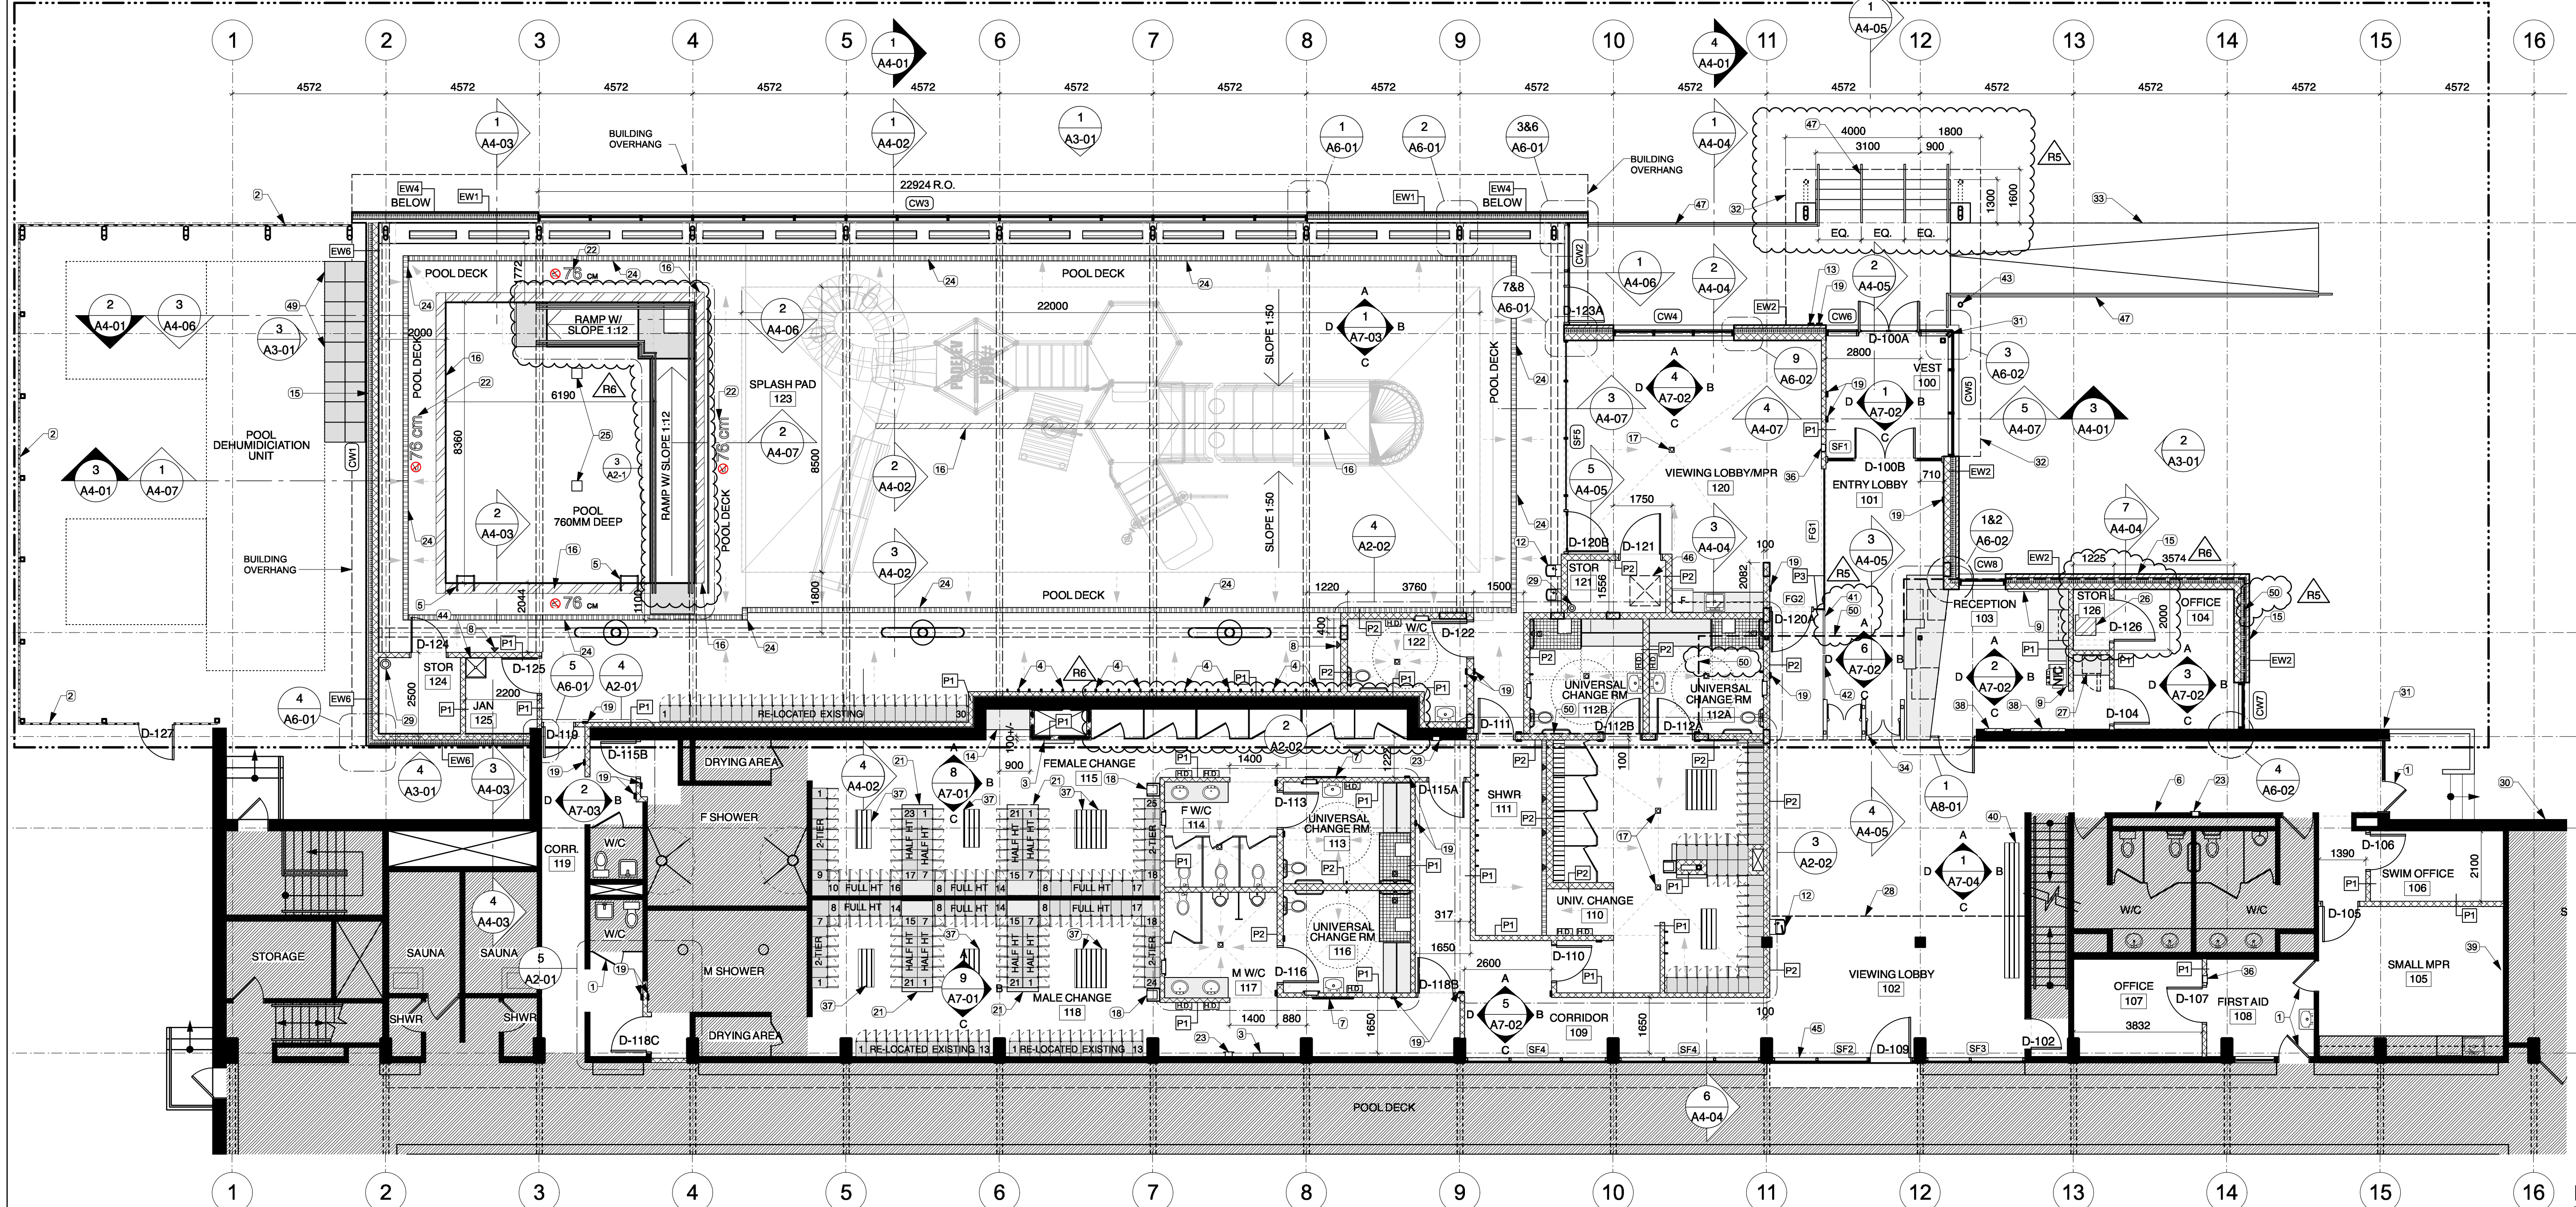

1 MAIN FLOOR PLAN
1:100

Issue / rev.	
6	2016.08.25 addendum 03
5	2016.08.16 addendum 01
4	2016.07.12 issued for construction
3	2016.06.13 issued for 99% review
2	2015.12.02 issued for class 1 pricing
1	2015.03.03 issued for class '1' pricing
#	date issue notes

professional seals

project information

SEVEN OAKS POOL RENOVATION & ADDITION

444 ADSUM DRIVE
WINNIPEG, MB
CANADA

client

CITY OF WINNIPEG
4TH FLOOR - 85 KING ST.
WINNIPEG, MB

drawing information

MAIN FLOOR PLAN & ENLARGED PLANS

drawn by: LW
approved by: DF

scale: 1:100
date issued: 2016.07.15
proj. #: 2014.66
rev. #: R-0

SEVEN OAKS POOL RENOVATION & ADDITION

BID OPPORTUNITY NO. 645-2016



Printed on post-consumer recycled content paper.