

**KEYNOTES:**

- 1 PROVIDE WIRE GUARDS ON SPRINKLERS IN THIS AREA.
- 2 PIPING TO BE RUN BENEATH BULKHEAD CEILING AND AGAINST WALL. USE SIDEWALL SPRINKLERS ALONG BALCONY. PROVIDE EXTENDED COVERAGE OF SIDEWALL HEADS IF REQUIRED. PROVIDE WIRE GUARDS ON SPRINKLERS. PAINT EXPOSED PIPING. CONFIRM COLOURS WITH ARCHITECT.
- 3 PAINT EXPOSED PIPING. CONFIRM COLOUR WITH ARCHITECT. PIPING TO SERVE SIDE WALL SPRINKLER HEADS FOR THE BALCONY.
- 4 PROVIDE SPRINKLER HEADS ABOVE AND BELOW WOOD CEILING IN THIS AREA.

**PRAIRIE ARCHITECTS INC.**  
Creating Sustainable Futures

300 - 141 Bannatyne Ave., Winnipeg, MB, R3B 0R3  
Telephone 204.956.0939 fax 204.943.5597  
web www.prairiearchitects.ca

**KGS GROUP**  
CONSULTING ENGINEERS

Issue / rev.		
1	2016/08/25	RE-ISSUED FOR CONSTRUCTION
0	2016/07/15	ISSUED FOR CONSTRUCTION
#	date	issue notes

**professional seals**

PROVINCE OF MANITOBA  
REGISTERED PROFESSIONAL ENGINEER  
S.H. CORDEN  
Member 30527  
Aug. 25/16

**project information**

**SEVEN OAKS POOL RENOVATION & ADDITION**  
444 Adsum Drive  
Winnipeg, MB  
Canada

**client**


City of Winnipeg  
4th Floor - 88 King Street  
Winnipeg, MB

**drawing information**

**MECHANICAL MEZZANINE FLOOR PLAN  
NEW FIRE PROTECTION**

drawn by: RLR  
approved by: *SK*

scale: AS NOTED  
date issued: 2016.08.25  
proj. #: 14-1736-008  
rev. #: R-1

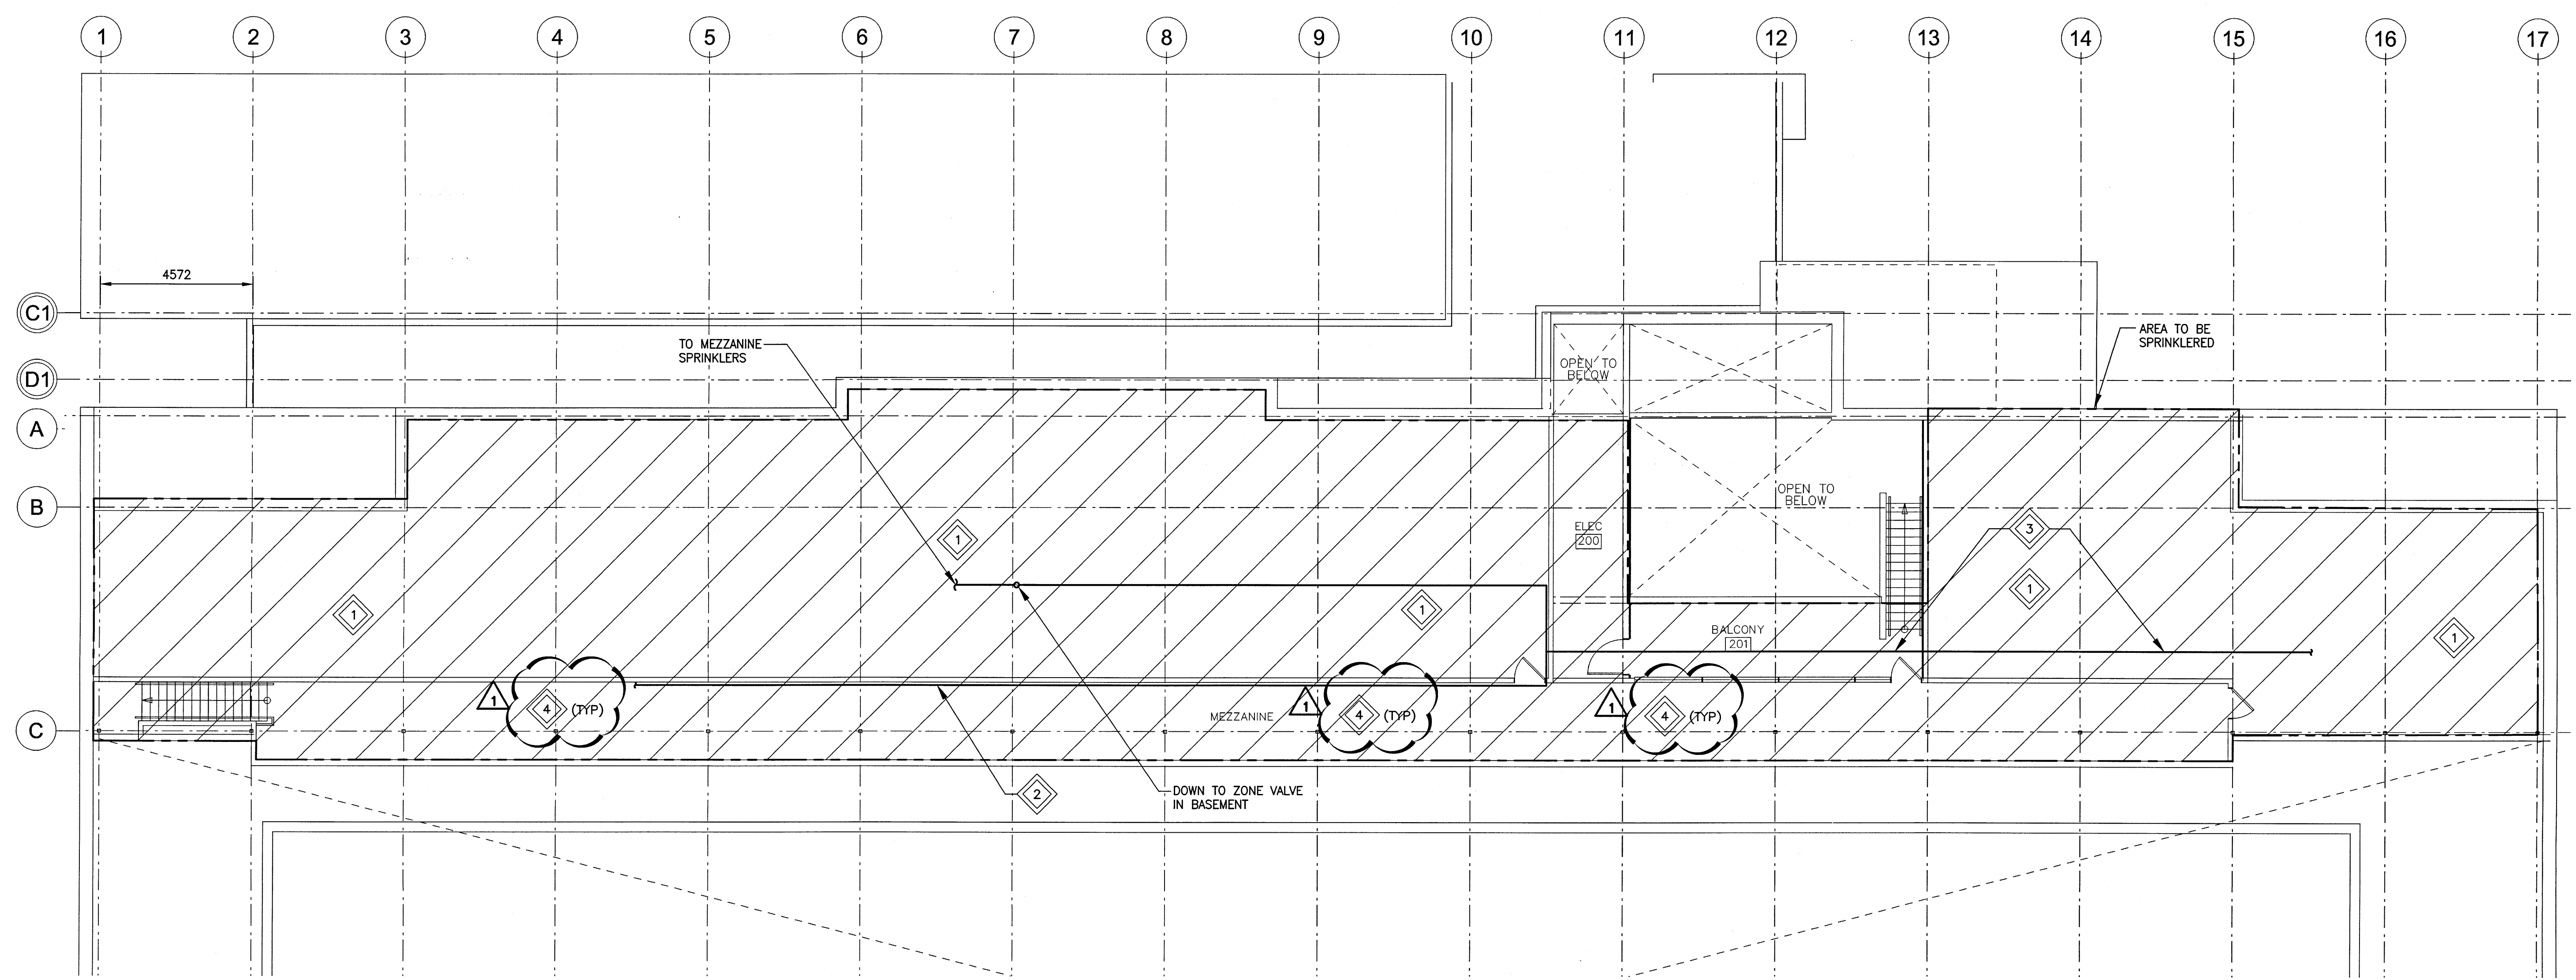

1 MEZZANINE PLAN - NEW FIRE PROTECTION  
SCALE: 1:100

SCALE VERIFIED BY: *SK*

**APEGM**  
Certificate of Authorization  
KGS Group  
No. 245

File Name: P:\Projects\2014\14-1736-008\Draw\Mech\14-1736-008\_M4-02.dwg - Tab: M4-02 Plotted By: dderochte 16/08/25 [Thu 1:30pm]

This drawing must not be scaled. The contractor shall verify all dimensions and other data on site prior to commencement of work. All discrepancies, errors, and omissions are to be reported to the architect. Drawing and specifications, as instruments of service, are the property of the architect, the copyright in the same being reserved to him. No reproduction may be made without the permission of the architect, and when made, must bear his name. All prints to be returned to the architect on request.

**SEVEN OAKS POOL RENOVATION & ADDITION**  
BID OPPORTUNITY NO. 645-2016