


**CONCRETE NOTES:**  
 - CONCRETE HAS A MINIMUM COMPRESSIVE STRENGTH OF  $f_c' = 30$  MPa AT 28 DAYS AND HAS SULPHATE RESISTANT TYPE 50 CEMENT INCLUDED.  
 - REINFORCING IS DEFORMED BARS WITH MINIMUM YIELD POINT  $f_y = 300$  MPa.  
 - CONCRETE PROTECTION FOR REINFORCING STEEL:  
 - FOR CONCRETE SLAB 20  
 - FOR GRADE BEAM 40  
 - EXTERIOR OF CONCRETE BLOCK NOT PAINTED

REVISED AS CONSTRUCTED  
 DATE MAR 15 - 84 BY P.L.  
 CHECKED BY *[Signature]*

NO.	REVISIONS	DATE	APP.
1.	REVISED TO AS BUILT	15 MAR 84	<i>[Signature]</i>

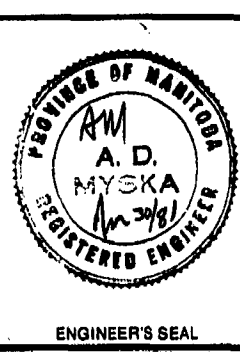

DESIGNED BY: D.S., A.M.	DRAWN BY: E.M.
CHECKED BY: A.M.	DATE: APRIL 30, 1981
APPROVED BY: A.M.	DATE: JUNE 25, 1981

**THE CITY OF WINNIPEG**  
 WORKS & OPERATIONS DIVISION  
 WATERWORKS, WASTE AND DISPOSAL DEPARTMENT

INSTALLATION OF STANDBY POWER UNITS  
 BURROWS AVE.  
 BUILDING PLAN & DETAILS  
 RELEASED FOR CONSTRUCTION: *[Signature]* DATE:  
 SCALE: AS NOTED DRAWING NO: 1063