


REV	DESCRIPTION	DATE	BY
1	ISSUED FOR ADDENDUM-01	08 SEP 2016	AL
0	ISSUED FOR BID OPPORTUNITY	30 AUG 2016	AL

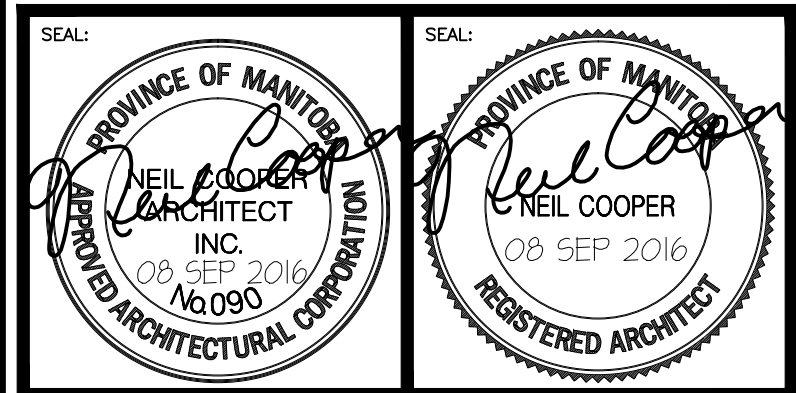

THIS DRAWING MUST NOT BE SCALED.  
 THE GENERAL CONTRACTOR SHALL VERIFY ALL DIMENSIONS, DATUMS AND LEVELS PRIOR TO COMMENCEMENT OF WORK AND IS HELD RESPONSIBLE FOR REPORTING ANY DISCREPANCY OR OMISSION TO NEIL COOPER ARCHITECT INC IMMEDIATELY.  
 THIS DRAWING IS THE EXCLUSIVE PROPERTY OF NEIL COOPER ARCHITECT INC AND CAN BE REPRODUCED ONLY WITH THE PERMISSION OF NEIL COOPER ARCHITECT INC. IN WHICH CASE THE REPRODUCTION MUST BEAR THEIR NAME AS THE ARCHITECTURAL FIRM.

**ENLARGED FLOOR PLANS**

PROJECT:  
**PAN AM INDOOR POOL UPGRADES TO STAIR & RAMP HANDRAILS**  
 25 POSEIDON BAY, WINNIPEG MB.

**Neil Cooper Architect Inc.**  
 10-395 Berry Street, Winnipeg, Manitoba R3J 1N6

BID OPPORTUNITY No. 741-2016

DRAWN BY: AL	CHECKED BY: NC	SHEET NO: A2.2R1	REV NO:
DATE: 28 APR 2016	SCALE: AS SHOWN		
FILE: 16065/Cont Doc/Cont Dwgs/Arch/A2.1 R0.dwg			