

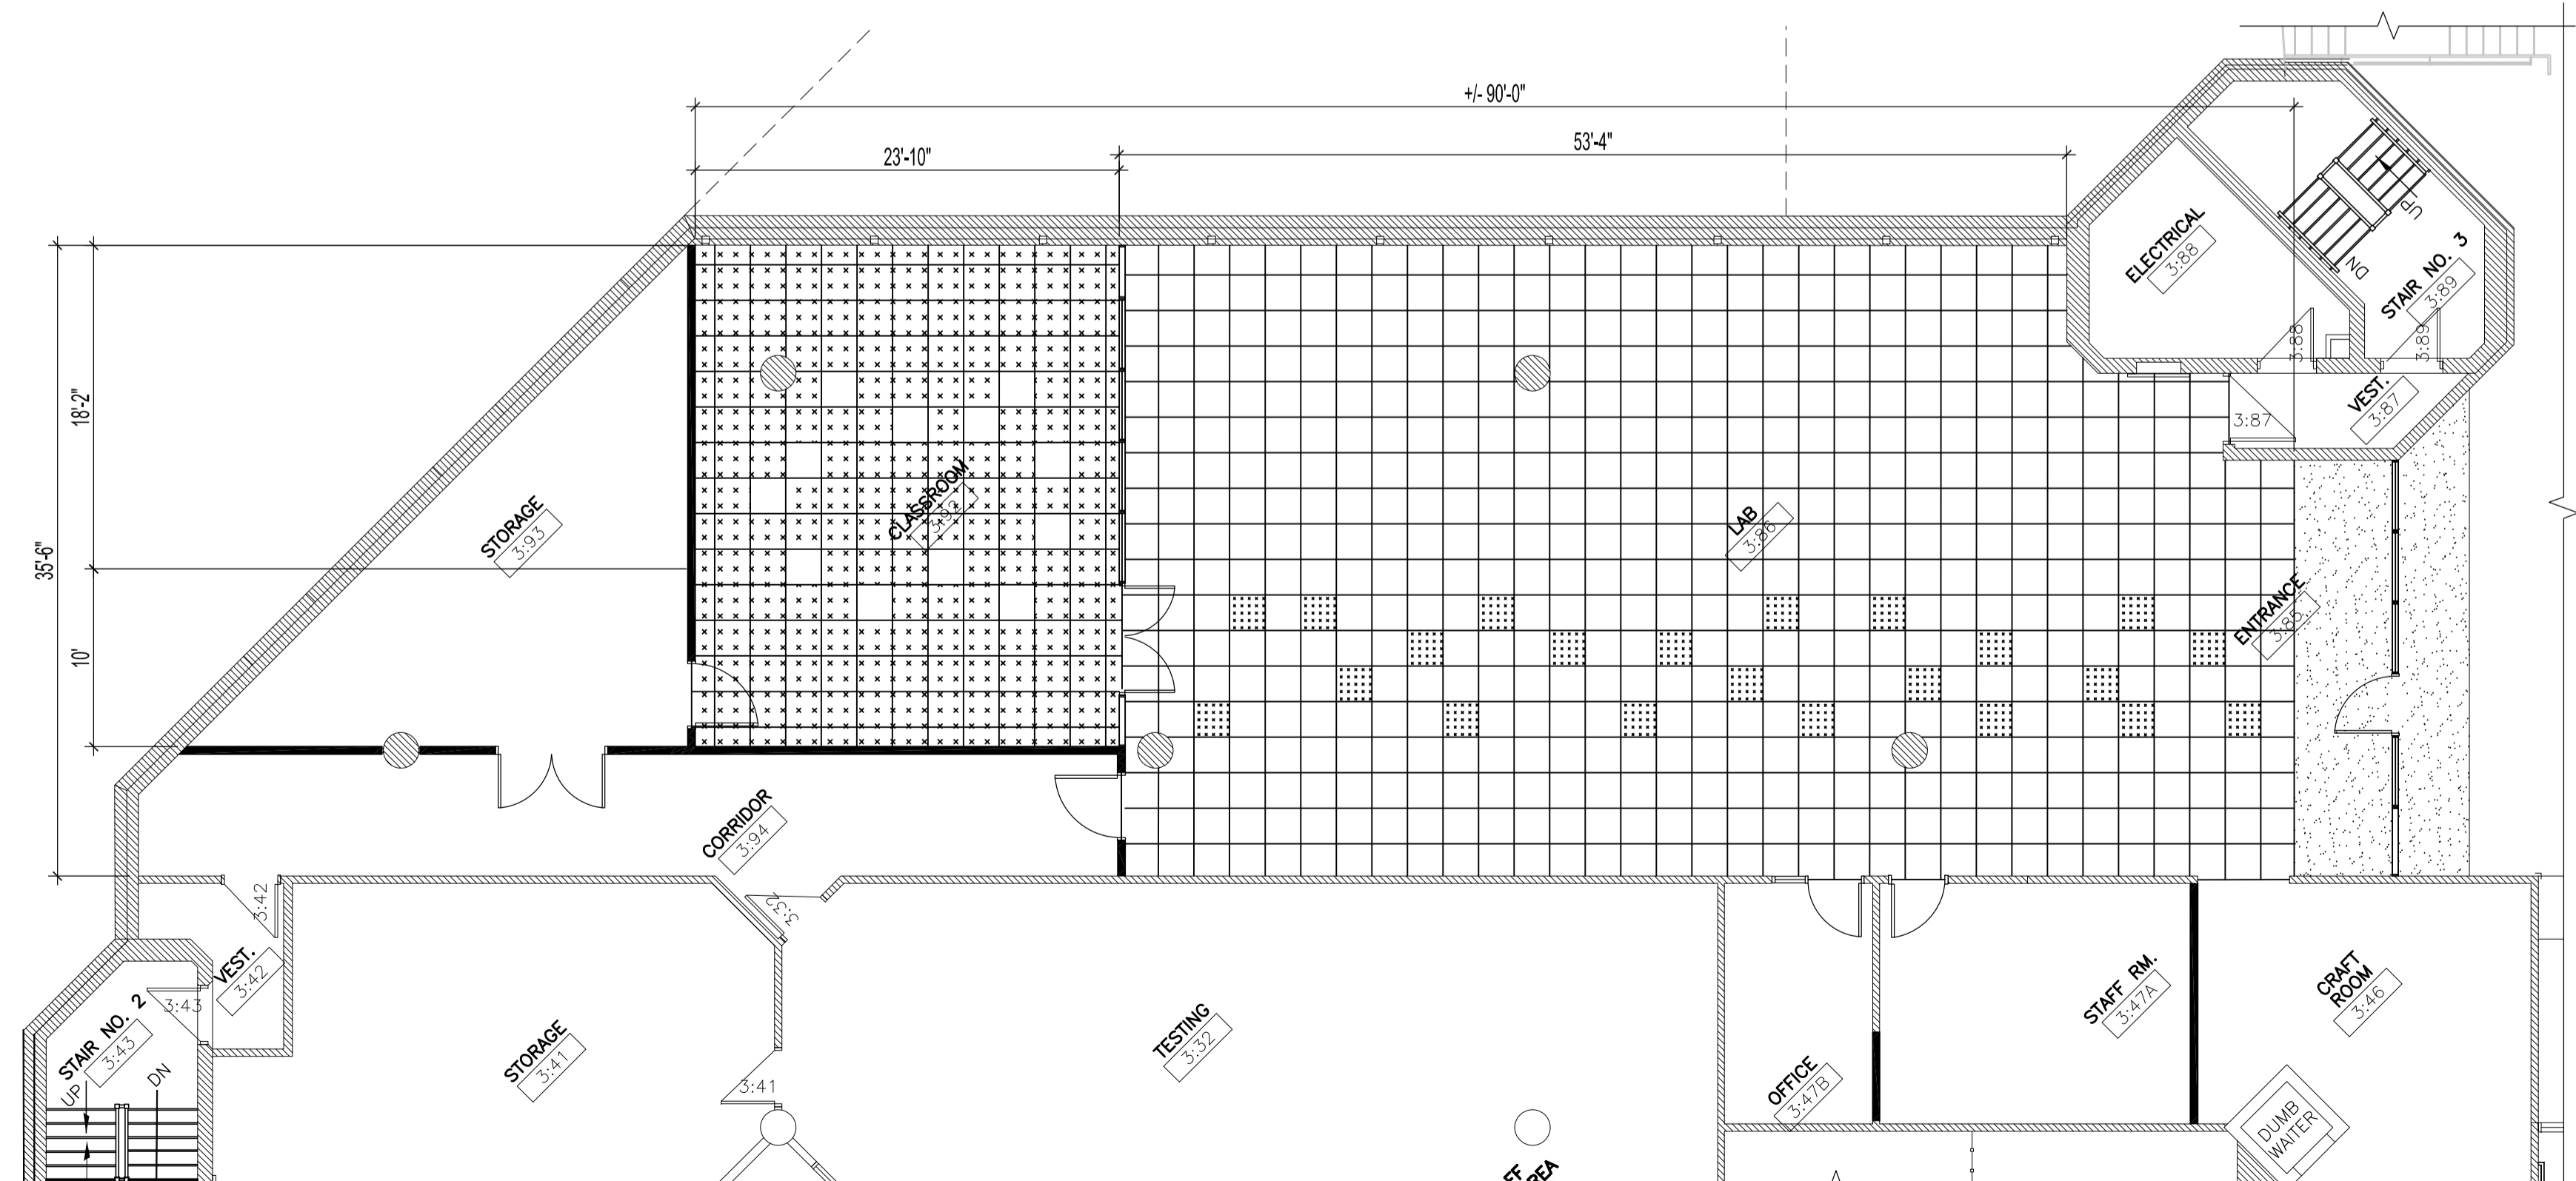


PARTIAL THIRD FLOOR PLAN - FLOOR DEMOLITION & LEVELING RENOVATION
SCALE: 1/8"=1'-0"

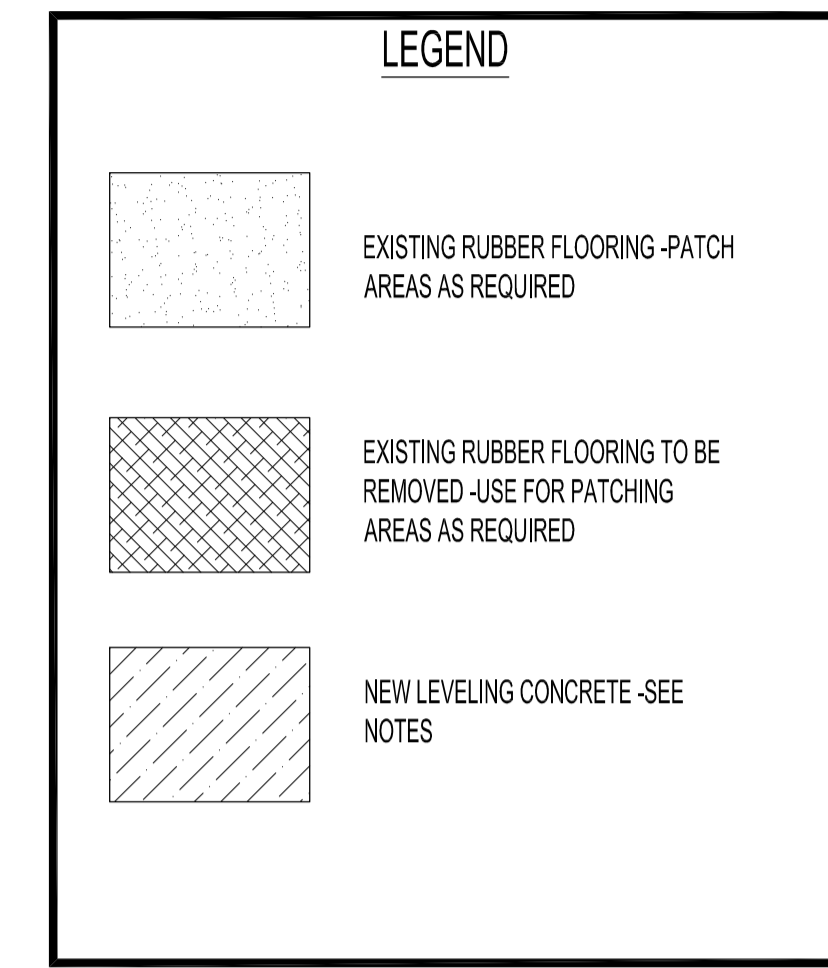

PARTIAL THIRD FLOOR PLAN - FLOOR FINISH PLAN
SCALE: 1/8"=1'-0"

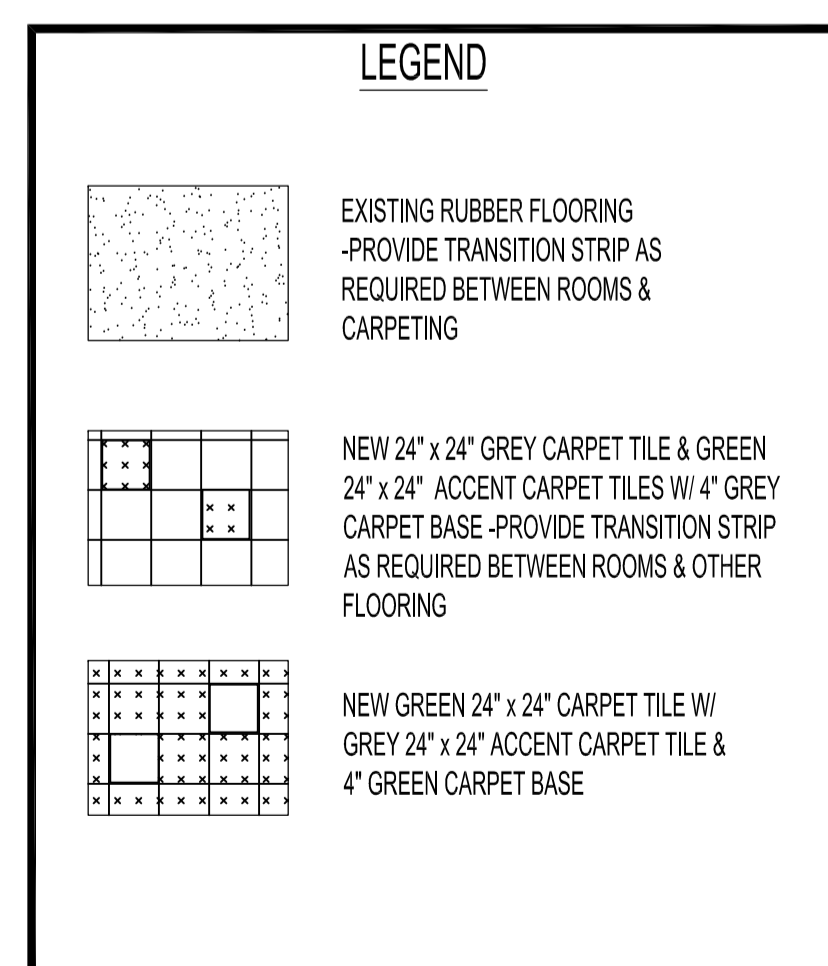

NEW 24" x 24" GREY CARPET TILE TO BE BY MOHAWK GROUP DENIM COLLECTION -HEM 966 LOW RISE -QUARTER TURN

NEW 24" x 24" GREEN CARPET TILE TO BE BY MOHAWK GROUP DENIM COLLECTION -COLOUR BEAT 646 PARAKEET

No.	REVISION/DESCRIPTION	BY	DATE
R1	REVISION 1 ADD GREY MAIN & ACCENT GREEN CARPET TYPES	MMK	OCT 21, 2016
1	ISSUED FOR CONSTRUCTION	MMK	AUG 26 2016



DRAWN	CHECKED	DESIGNED	APPROVED
MMK	MMK		

THE CITY OF WINNIPEG
PLANNING, PROPERTY AND
DEVELOPMENT DEPARTMENT
MUNICIPAL ACCOMMODATIONS DIVISION
3-65 GARRY STREET, R3C 4K4

PROJECT
**MILLENNIUM LIBRARY
DEVELOPEMENT & CONSTRUCTION
OF IDEA MILL**
251 DONALD STREET

SHEET TITLE
**PARTIAL THIRD FLOOR PLAN
FLOOR DEMOLITION & LEVELING
FLOOR FINISH PLAN**

SCALE	PROJECT No:	SHEET No:
AS SHOWN	2015-123	A4R1