



1 AQUATIC HALL OF FAME- WEST ELEVATION  
 A2.0 SCALE: 3/16"=1'-0"

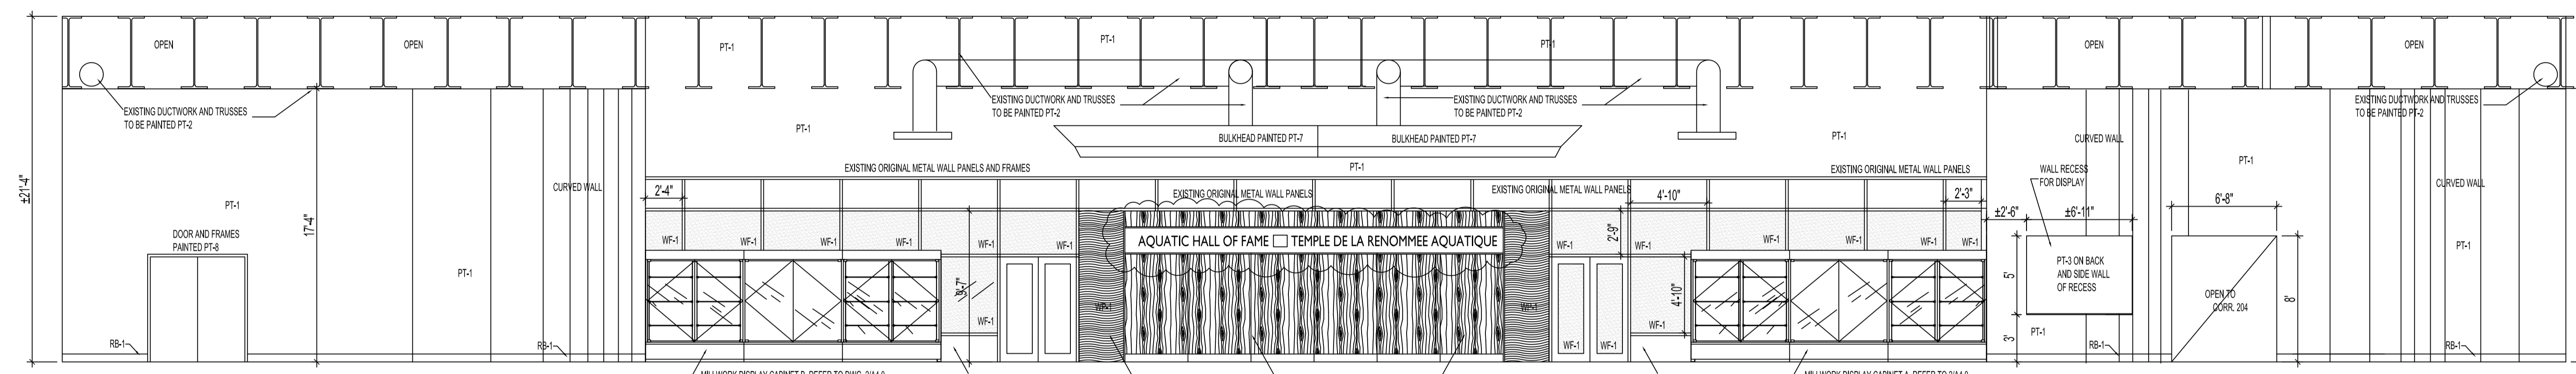

2 AQUATIC HALL OF FAME- EAST ELEVATION  
 A2.0 SCALE: 3/16"=1'-0"

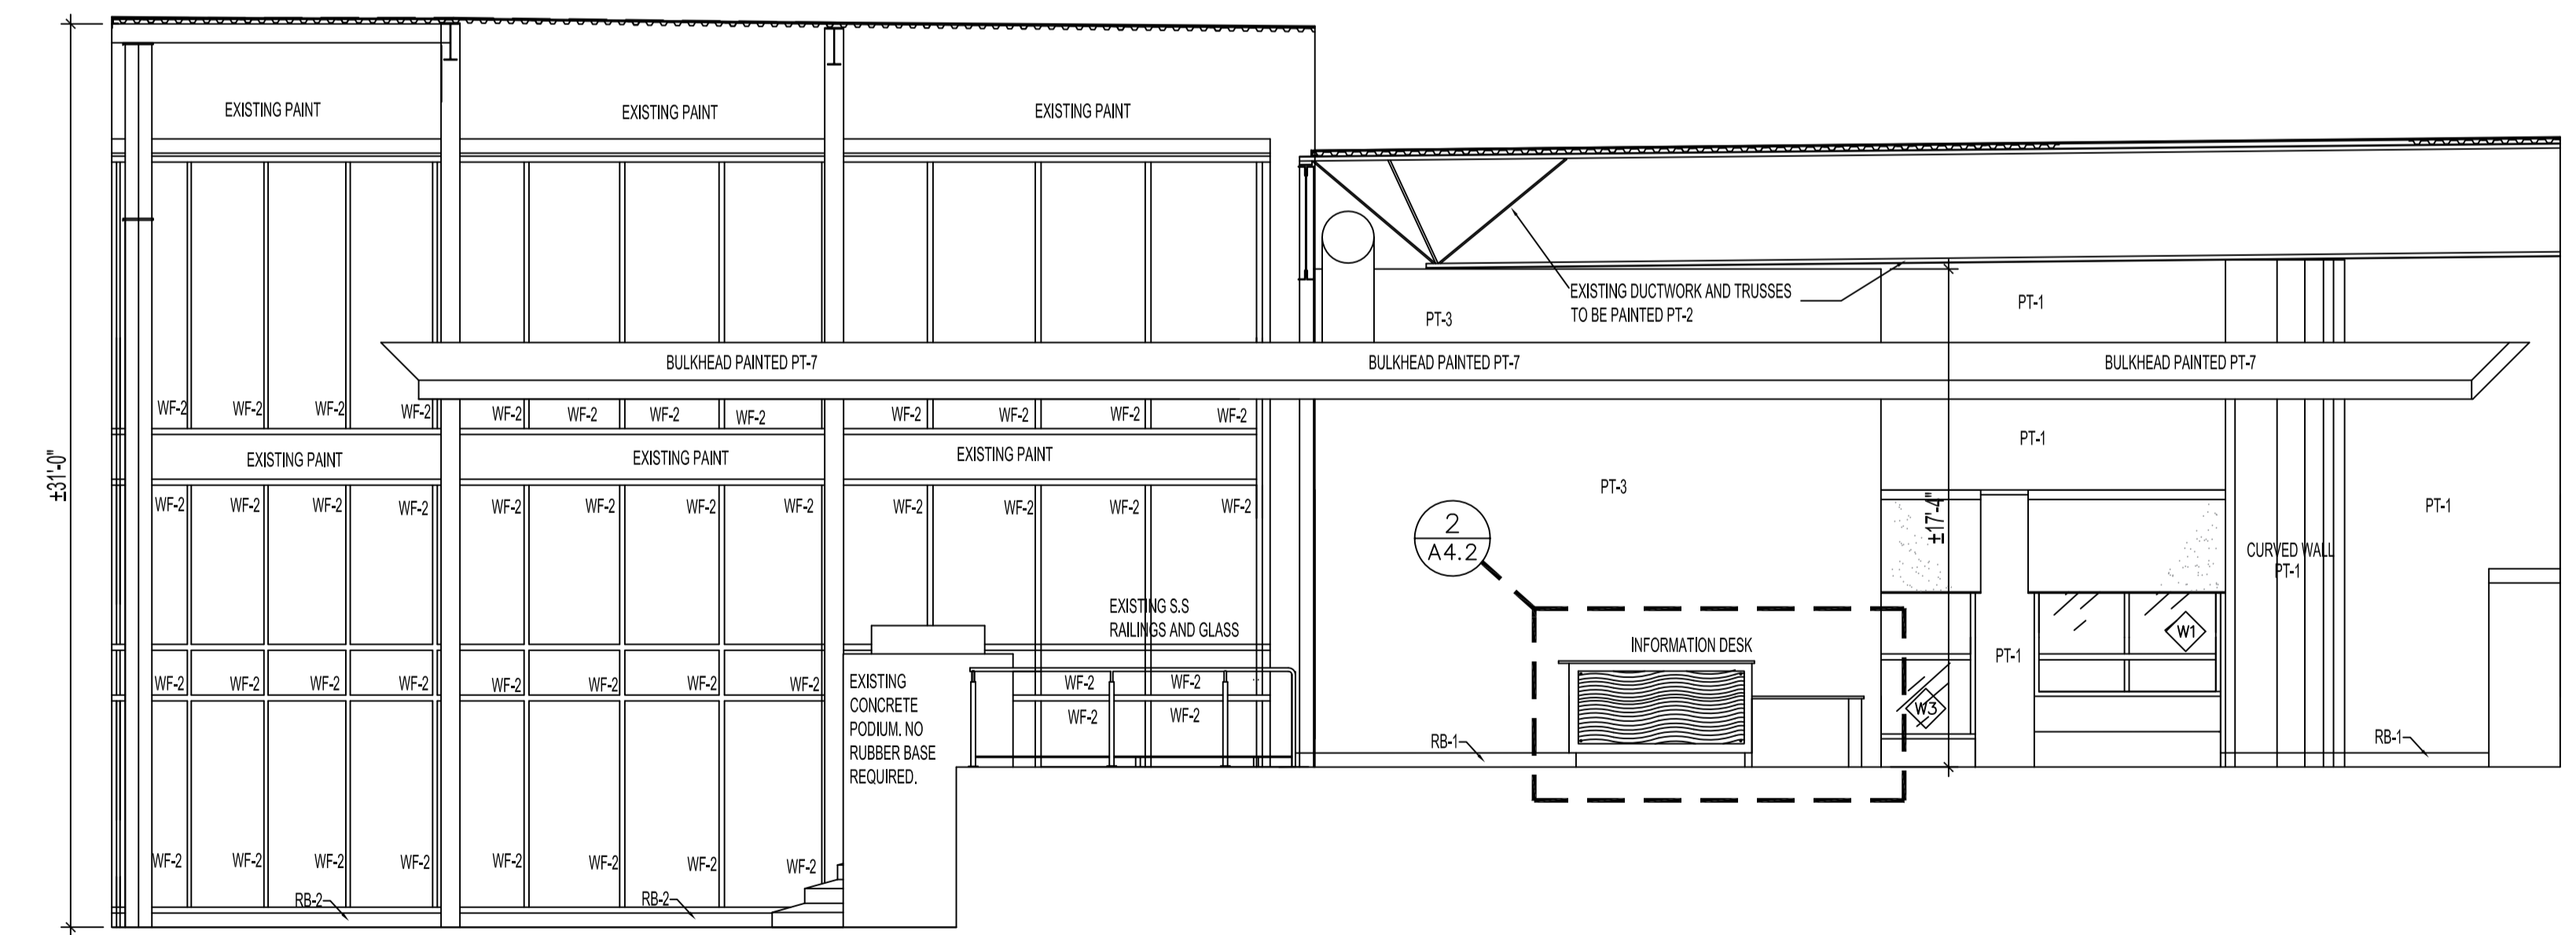

3 AQUATIC HALL OF FAME LOBBY- NORTH ELEVATION  
 A2.0 SCALE: 3/16"=1'-0"

**DRAWING NOTES**

- 1 REFER TO DRAWING A/ 5.0 FOR FINISH SCHEDULE FOR SPECIFICATIONS.

**PATTERN LEGEND**

- AREA N.I.C
- QUARRY TILE FLOOR
- ACOUSTIC TILE CEILING
- VINYL FILM

1	ISSUED FOR ADDENDUM	DEC 6/16
0	ISSUED FOR CONSTRUCTION	NOV/28/16
No.	REVISION/DESCRIPTION	BY DATE



DRAWN	KJN	CHECKED	KJN	DESIGNED	KJN	APPROVED
DATE	2016.11.30	USER	APPROVAL			

THE CITY OF WINNIPEG  
 PLANNING, PROPERTY AND  
 DEVELOPMENT DEPARTMENT  
 MUNICIPAL ACCOMMODATIONS DIVISION  
 3-65 GARRY STREET, R3C 4K4

PROJECT  
 AQUATIC HALL OF FAME MUSEUM  
 ROYAL GALLERY SPACE RESTORATION

25 POSEIDON BAY  
 SHEET TITLE

INTERIOR ELEVATIONS

SCALE	PROJECT No:	SHEET No:
AS SHOWN	2014-148	A2.0