A1 SIZE – 594mm x 841mm

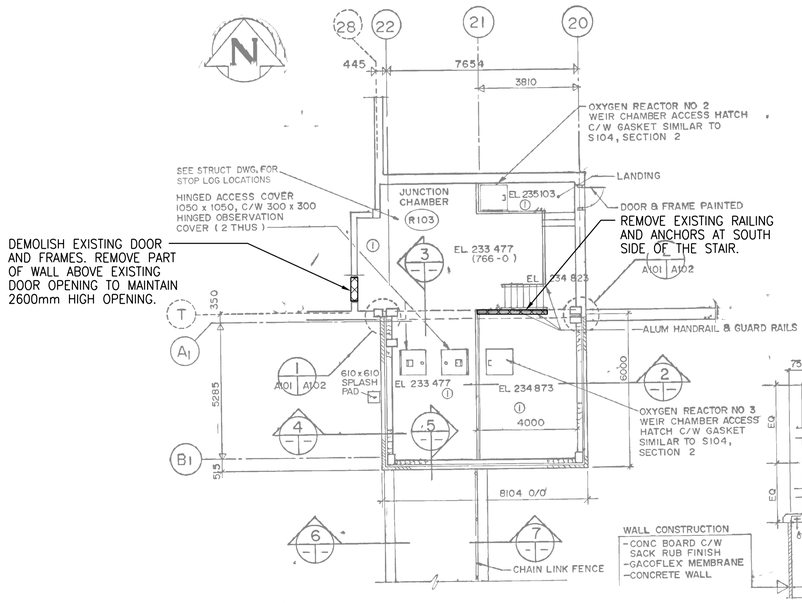

NOTE
SEE DWGS S101-S108
FOR OXYGEN REACTORS

1 FLOOR PLAN

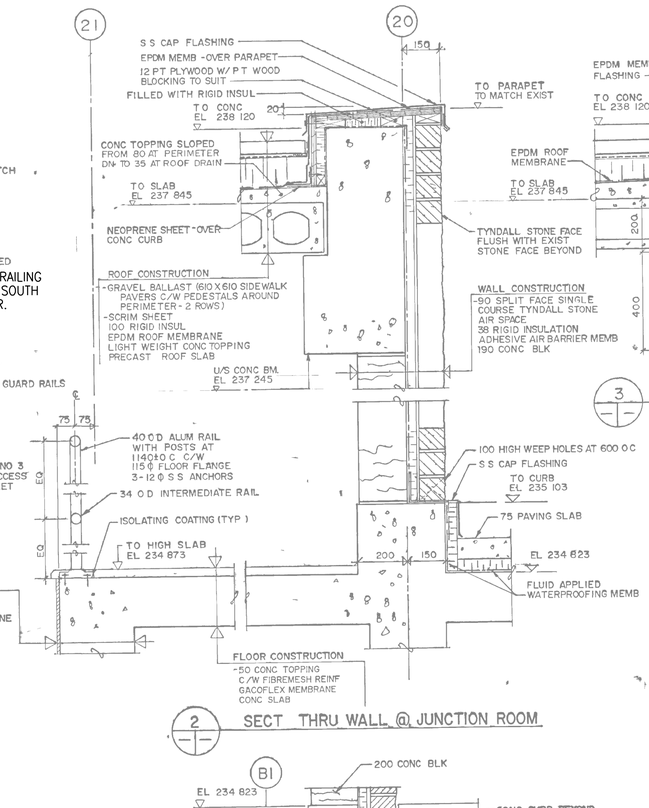

2 SECT THRU WALL @ JUNCTION ROOM

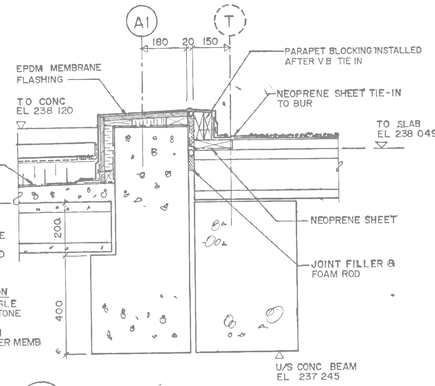

3 EXPANSION JOINT DETAIL

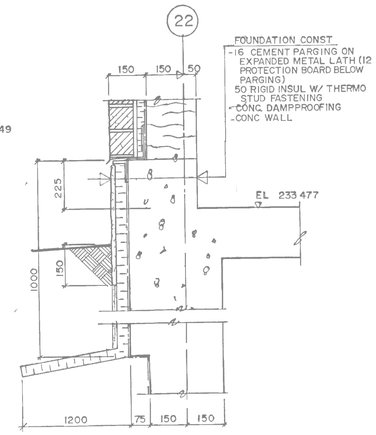

4 SECTION
1 10

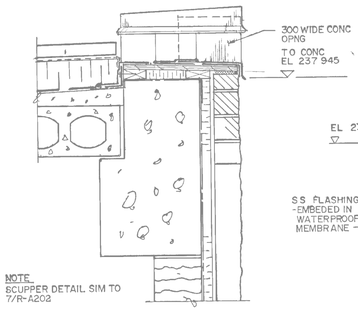

NOTE
SCUPPER DETAIL SIM TO
7/R-A202

3 SCUPPER DETAIL

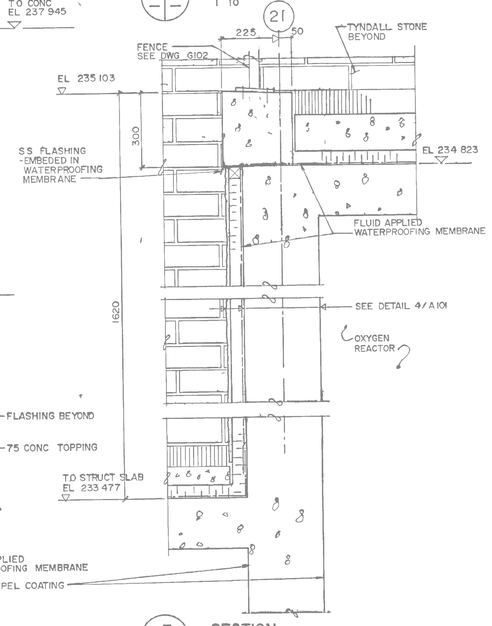

7 SECTION

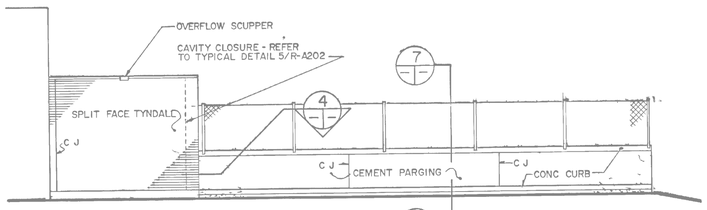

8 WEST ELEVATION

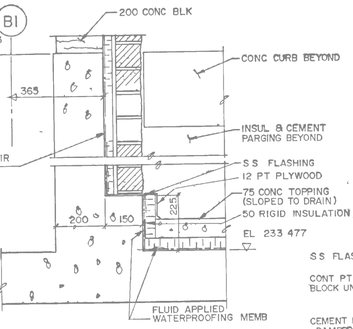

5 SECTION

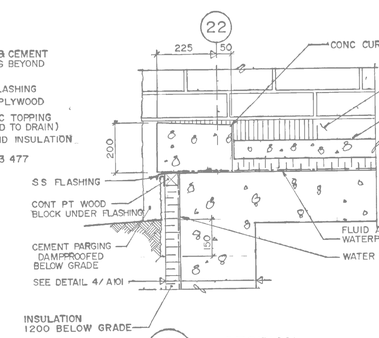

6 SECTION

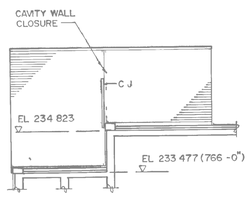

9 SOUTH ELEVATION

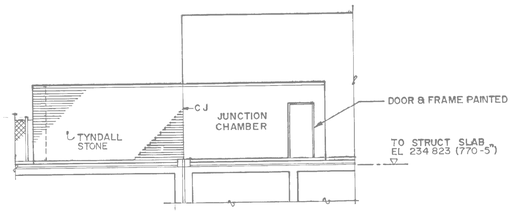

10 EAST ELEVATION

NOTES:

1. FOR NEW CONSTRUCTION SEE STRUCTURAL PRIMARY SLUDGE FERMENTERS/THICKENERS DRAWINGS.
2. REFER TO GENERAL DEMOLITION NOTES DRAWING 1-0102-DAAA-AD01.

SEALING ARCHITECT OR ENGINEER ACCEPTS RESPONSIBILITY ONLY FOR AREAS IDENTIFIED BY CLOUDING ON THIS DRAWING.

NOTE: THIS DRAWING SUPERSEDES DRAWING SEP-335

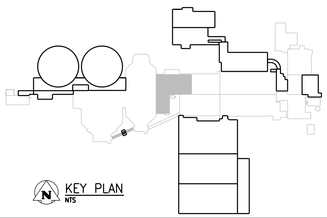

KEY PLAN
NTS

APEGM
Certificate of Authorization
CH2M HILL Canada Ltd.
No. 1441

NO.	REVISIONS	DATE	DESIGN	CHECK
00	ISSUED FOR CONSTRUCTION – 976-2016	2017/04/05	R.B.	J.C.

CH2MHILL CANADA
Architects Inc.
SNC·LAVALIN
KGS GROUP CONSULTING ENGINEERS

DESIGNED BY: R. ZAKKO	CHECKED BY: W. YU
DRAWN BY: R. BATHAN	APPROVED BY: H.T. FRIEHAMMER
SCALE: NTS	ISSUED FOR CONSTRUCTION BY: J. SHUMKA
DATE: 2017/04/05	DATE: 2017/04/05
CONSULTANT NO.: 474248	

ENGINEER'S SEAL
PROVINCE OF MANITOBA
REID ZAKKO
24-05-2017
REGISTERED ARCHITECT

Winnipeg
THE CITY OF WINNIPEG
WATER AND WASTE DEPARTMENT

SOUTH END WATER POLLUTION CONTROL CENTRE
SEWPCC UPGRADING/EXPANSION PROJECT
BUILDING
OXYGEN REACTOR EXPANSION
FLOOR PLAN, SECTIONS & ELEVATIONS (DEMOLITION)

CITY DRAWING NUMBER	SHEET	REV.	SIZE
1-0102-BGAD-DD52	001	00	A1

PLOT DATE: 2017\04\02
FILE NAME:

©CH2M HILL 2017. ALL RIGHTS RESERVED.