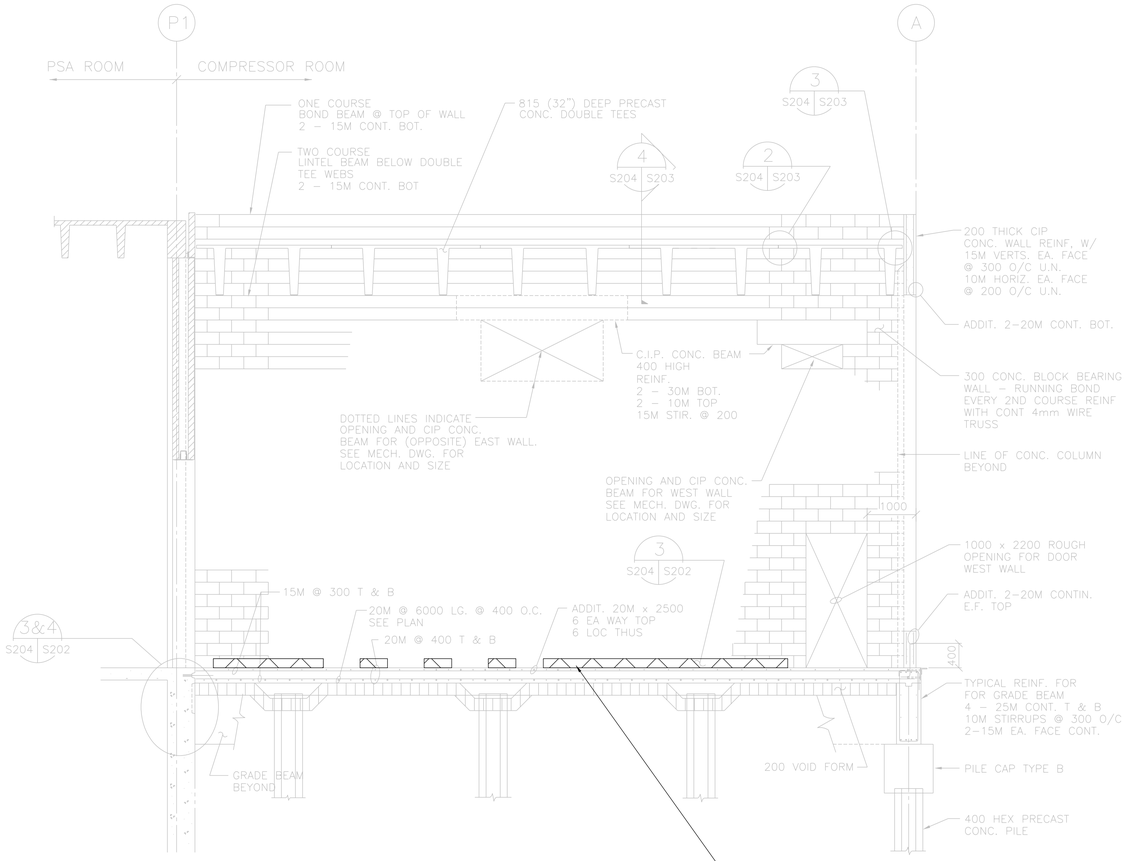

1 SECTION
S202 S204 1:50

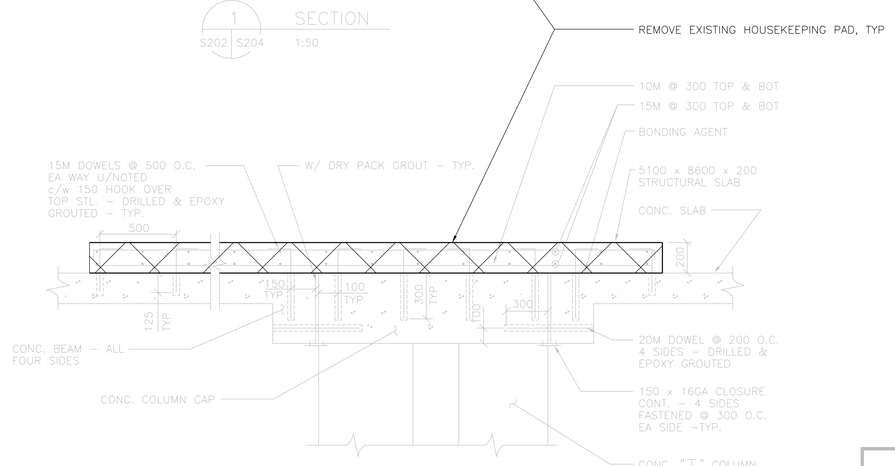

2 SECTION
S202 S204 1:20

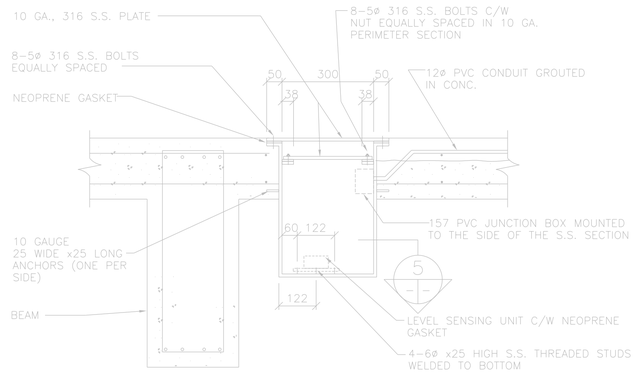

3 SECTION (3 THUS)
S202 S204 1:10

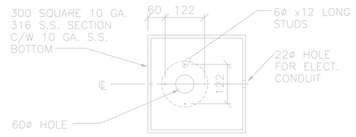

5 SECTION
– – 1 : 10

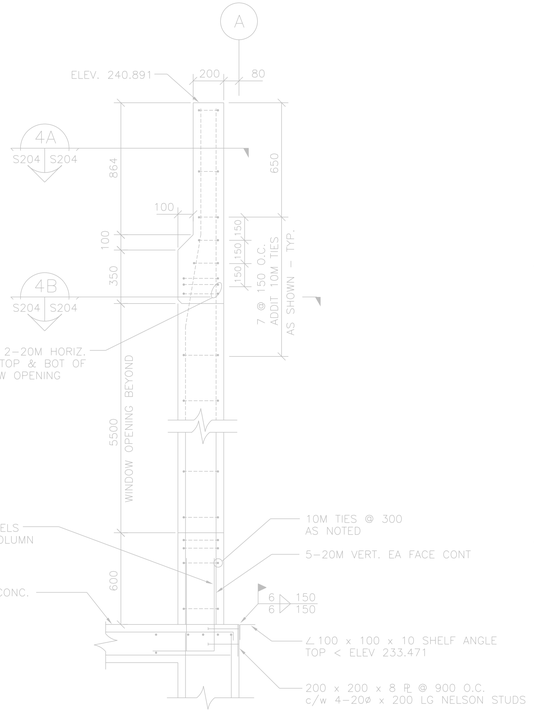

4 SECTION
S202 S204 1:20

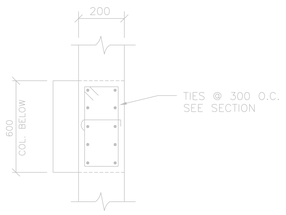

4A S204 S204 SECTION @ COL.
WALL REINF. NOT SHOWN FOR CLARITY
N.T.S.

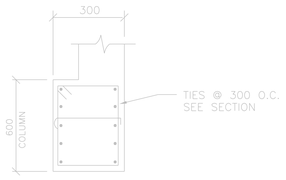

4B S204 S204 SECTION @ COL.
WALL REINF. NOT SHOWN FOR CLARITY
N.T.S.

KEY PLAN
N.T.S.

AS CONSTRUCTED
DATE SEPTEMBER 1993 BY C.J.A.
APPROVED BY

ORIGINALLY DESIGNED BY

NO.	REVISIONS	DATE	BY
00	ISSUED FOR CONSTRUCTION – 976–2016	04/05/2017	B.C.

B.M.
ELEV.

MacLAREN ENGINEERS INC.
WARDROP ENGINEERING INC.
ENGINEERING CONSULTANTS

DESIGNED BY	J.F.	CHECKED BY	
DRAWN BY	S.B. /CAD	APPROVED BY	
HOR. SCALE: VERTICAL:	1:50	RELEASED FOR CONSTRUCTION:	
DATE	90–03–29	DATE	

ENGINEER APR 5, 2017
PROVINCE OF MANITOBA
LUI
Member
37003
REGISTERED PROFESSIONAL ENGINEER

CONSULTANT DRAWING NO.
870012–01–22–R–S204

THE CITY OF WINNIPEG
WORKS AND OPERATIONS DIVISION
WATERWORKS, WASTE & DISPOSAL DEPARTMENT

SOUTH END WATER POLLUTION CONTROL CENTRE
PSA EXPANSION – STRUCTURAL
SECTIONS AND DETAILS

CITY DRAWING NUMBER
SHEET OF
SEP – 370