


LOWER LEVEL PLAN
1:100

NOTE


1. CONNECTION TO EXISTING 150-PS-CS01 (CL EL 227.150±) TO BE MADE FROM BELOW. CUT INTO EXISTING PIPE AND PROVIDE
2. CARBON STEEL FLANGES ONE EACH END, ISOTEK ISOLATION GASKET FLANGE KIT AND REMOVAL COUPLING. (EXISTING 150-STM AND 38-COND TO BE REMOVED TO ALLOW FOR 150-PS-SS01 CONNECTION)

NOTE THAT PIPING RUNNING ACROSS EXISTING GALLERY NO. 3 MAY REQUIRE A ROUTING THAT IS NOT AS SHOWN HERE. REVIEW ON SITE AND ROUTE AS NEEDED.

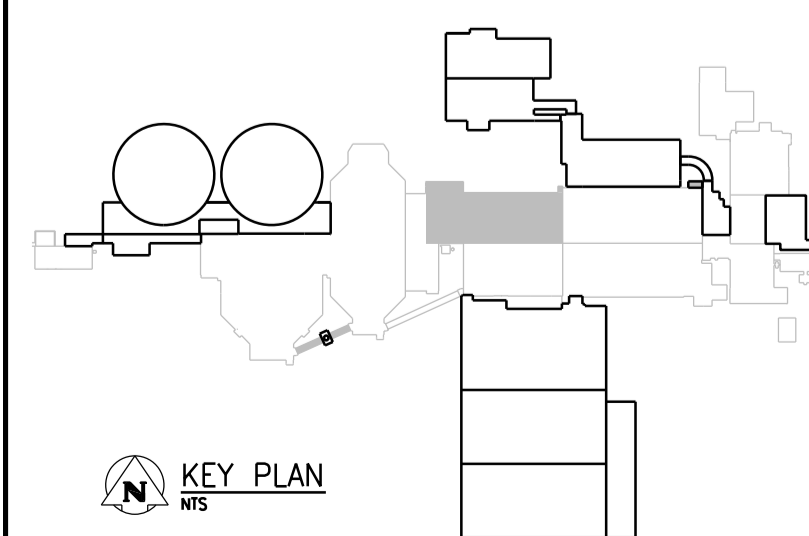

NO.	REVISIONS	DATE	DESIGN	CHECK
01	ISSUED FOR ADDENDUM 4 - 976-2016	2017/06/30	B.C.	J.C.
00	ISSUED FOR CONSTRUCTION - 976-2016	2017/04/05	B.C.	J.C.

CH2MHILL	
DESIGNED BY: F. ABSI	CHECKED BY: B. EDGAR
DRAWN BY: P. KWONG	APPROVED BY: H.T. FRIEHAMMER
SCALE: 1:100	ISSUED FOR CONSTRUCTION BY: J. SHUMKA
DATE: 2017/04/05	DATE: 2017/04/05
CONSULTANT NO.: 474248	

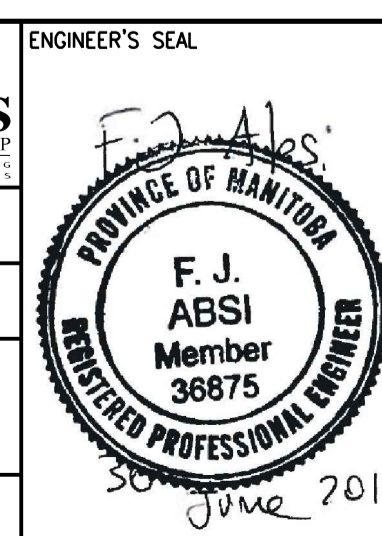

THE CITY OF WINNIPEG
WATER AND WASTE DEPARTMENT

SOUTH END WATER POLLUTION CONTROL CENTRE
SEWPC UPGRADING/EXPANSION PROJECT
PROCESS
FERMENTERS/THICKENERS
LOWER LEVEL PLAN

CITY DRAWING NUMBER: 1-0102-PGAD-D001
SHEET: 001
REV: 01
SIZE: A1