A1 SIZE – 594mm x 841mm

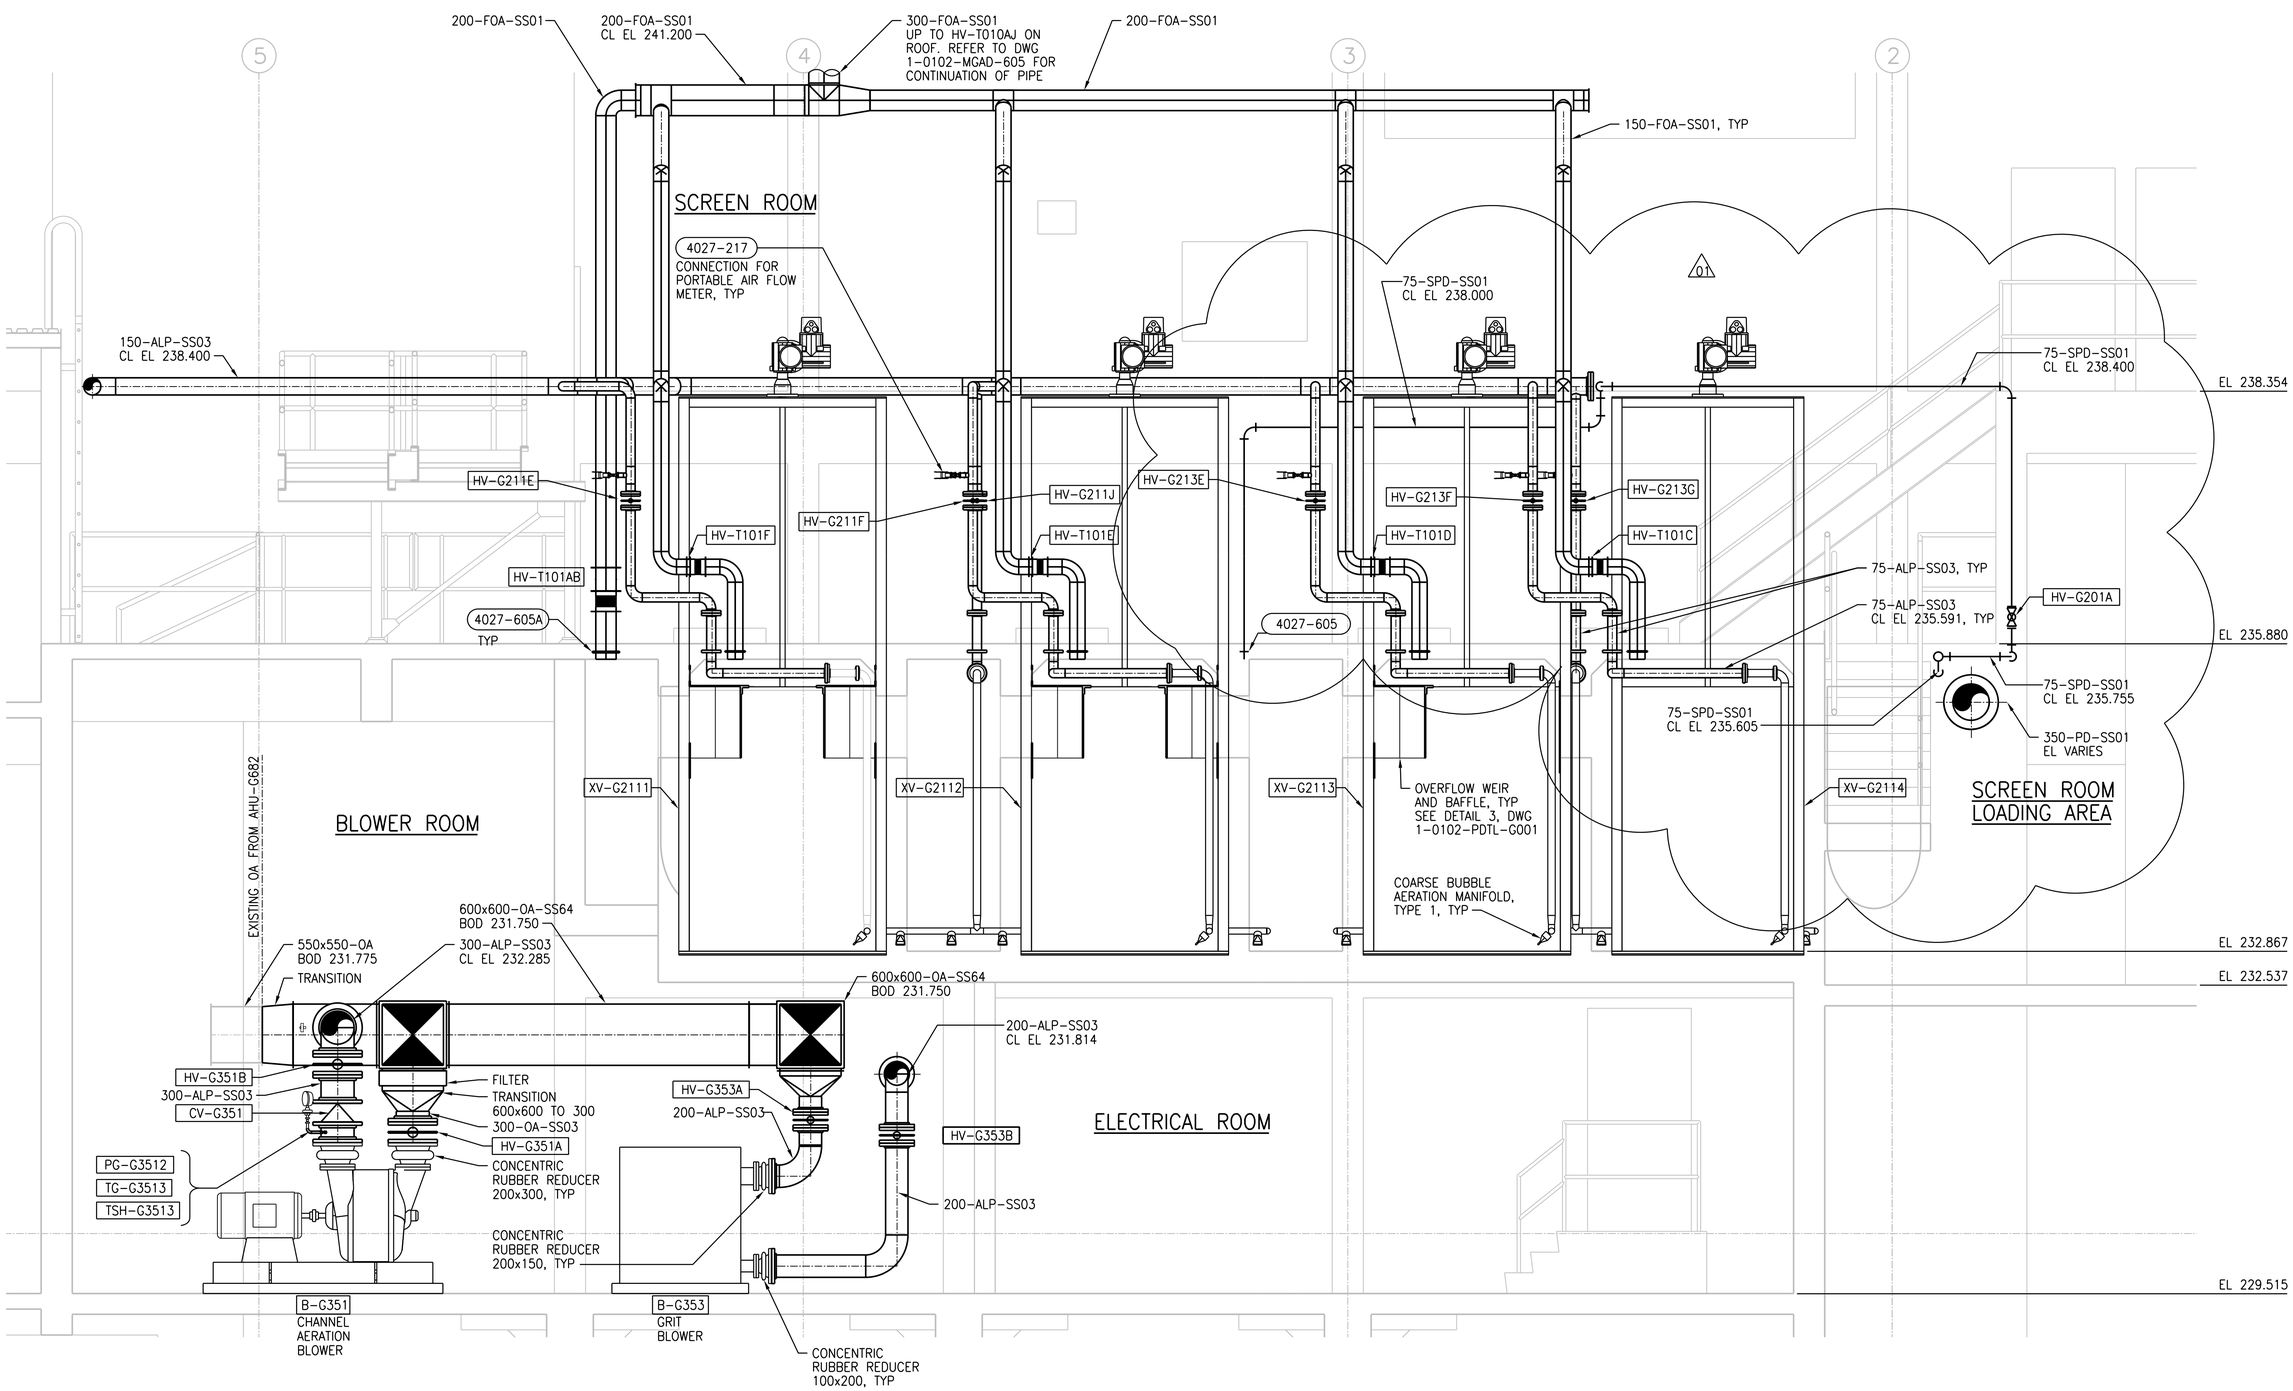

A SECTION
1:30

PGAD-G005
PGAD-G006

©CH2M HILL 2017. ALL RIGHTS RESERVED.

APEGM
Certificate of Authorization
CH2M HILL Canada Ltd.
No. 1441

NO.	REVISIONS	DATE	DESIGN	CHECK
01	ISSUED FOR ADDENDUM 4 – 976-2016	2017/06/30	B.C.	J.C.
00	ISSUED FOR CONSTRUCTION – 976-2016	2017/04/05	B.C.	J.C.

CH2MHILL
SNC·LAVALIN
KGS GROUP

DESIGNED BY: B. EDGAR	CHECKED BY: F. ABSI
DRAWN BY: P. KULICZKOWSKI	APPROVED BY: H.T. FREIHAMMER
SCALE: 1:30	ISSUED FOR CONSTRUCTION BY: J. SHUMKA
DATE: 2017/04/05	DATE: 2017/04/05
CONSULTANT NO.: 474248	

ENGINEER'S SEAL
PROVINCE OF MANITOBA
F. J. ABSI
Member
36875
REGISTERED PROFESSIONAL ENGINEER
30 June 2017

Winnipeg
THE CITY OF WINNIPEG
WATER AND WASTE DEPARTMENT

SOUTH END WATER POLLUTION CONTROL CENTRE
SEWPCC UPGRADING/EXPANSION PROJECT
PROCESS
SCREEN BUILDING
SECTION A

CITY DRAWING NUMBER	SHEET	REV.	SIZE
1-0102-PGAD-G007	001	01	A1

PLOT DATE: 2017\07\03
FILE NAME: 1-0102-PGAD-G007.dgn