


NO.	REVISIONS	DATE	DESIGN	CHECK
01	ISSUED FOR ADDENDUM 4 - 976-2016	2017/06/30	J.C.	J.C.
00	ISSUED FOR CONSTRUCTION - 976-2016	2017/04/05	J.C.	J.C.

CH2MHILL		KGS	
SNC-LAVALIN		CONSULTING ENGINEERS	
DESIGNED BY: T. TRAN	CHECKED BY: R. NATARAJAN	DATE: 2017/04/05	ISSUED FOR CONSTRUCTION DATE: 2017/04/05
DRAWN BY: J. CORTEZ	APPROVED BY: H.T. FREIHAMMER	CONSULTANT NO.: 474248	
SCALE: NTS	BY: J. SHUMKA		

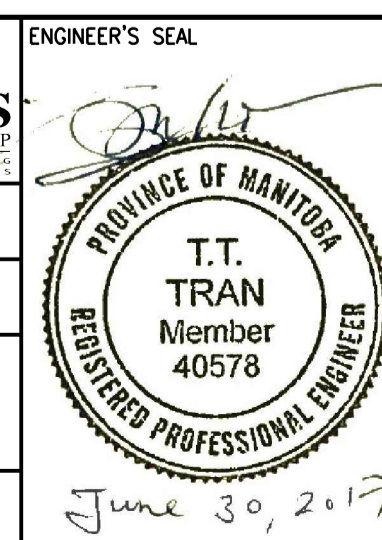

THE CITY OF WINNIPEG
Winnipeg WATER AND WASTE DEPARTMENT

SOUTH END WATER POLLUTION CONTROL CENTRE
SEWPCC UPGRADING/EXPANSION PROJECT
PROCESS AND INSTRUMENTATION DIAGRAM
GRIT AND SCREENING BUILDING
SUMP PUMPS P-G531 AND P-G532

CITY DRAWING NUMBER: 1-0102-PPID-G506 | SHEET: 001 | REV: 01 | SIZE: A1