SECTION 09 67 23 RESINOUS FLOORING PART 1 - GENERAL

1.0 SUMMARY

.1 FLOOR TO HAVE A TWO-COMPONENT GENERAL SERVICE 100% SOLIDS EPOXY COATING WITH DECORATIVE BROADCAST MULTI-COLOUR FLAKES (NO TRACTION ADDITIVE), A TWO-COMPONENT 100% SOLIDS CLEAR SEALER TO BE APPLIED AFTERWARDS, DECORATIVE MULTI-COLOUR FLAKES (NO TRACTION ADDITIVE) BROADCAST WITHIN THE EPOXY COATING. STAIRS TO ALSO HAVE MINIMUM 2" WIDE VISUAL CONTRAST ON TOP

1.1 SUBMITTALS

- .1 PRODUCT DATA: SUBMIT MANUFACTURER'S TECHNICAL DATA, INSTALLATION INSTRUCTIONS, AND GENERAL RECOMMENDATIONS FOR EACH RESINOUS FLOORING MATERIAL REQUIRED. INCLUDE CERTIFICATION INDICATING COMPLIANCE OF MATERIALS WITH REQUIREMENTS.
 - SAMPLES: SUBMIT 4-INCH SQUARE SAMPLES OF EACH TIME OF RESINOUS FLOORING REQUIRED, APPLIED TO A RIGID BACKING, IN COLOUR AND FINISH INDICATED. .1 FOR INITIAL SELECTION OF COLOURS AND FINISHES, SUBMIT MANUFACTURER'S COLOUR CHARTS
 - SHOWING FULL RANGE OF COLOURS AND FINISHES AVAILABLE.

1.2 QUALITY ASSURANCE

ECOPOXY OR APPROVED EQUAL IN ACCORDANCE WITH B7.

AND FRONT FACE OF NOSING WITH TEXTURE (TRACTION ADDITIVE).

ISO 9002: ALL MATERIALS, INCLUDING PRIMERS, RESINS, CURING AGENTS, FINISH COATS, AGGREGATES AND SEALANT ARE MANUFACTURED AND TESTED UNDER AND ISO 9002 REGISTERED QUALITY SYSTEM.

1.3 DELIVERY, STORAGE, AND HANDLING

- MATERIAL SHALL BE DELIVERED TO JOB SITE AND CHECKED BY FLOORING CONTRACTOR FOR COMPLETENESS AND SHIPPING DAMAGE PRIOR TO JOB START.
- ALL MATERIALS USED SHALL BE FACTORY PRE-WEIGHED AND PRE-PACKAGED IN SINGLE, EASY TO MANAGE BATCHES TO ELIMINATE SITE MIXING ERRORS, NO ON SITE WEIGHING OR VOLUMETRIC MEASUREMENTS ALLOWED.
- MATERIAL SHALL BE STORED IN A DRY. ENCLOSED AREA PROTECTED FROM EXPOSURE TO MOISTURE. TEMPERATURE OF STORAGE AREA SHALL BE MAINTAINED BETWEEN 16 AND 30 DEGREES CELSIUS (60-85F).

1.4 PROJECT CONDITIONS

- JOB AREA TO BE FREE OF OTHER TRADES AND FOOT TRAFFIC DURING, AND FOR A PERIOD OF 24 HOURS AFTER, FLOOR INSTALLATION.
- PROTECTION OF FINISHED FLOOR FROM DAMAGE BY SUBSEQUENT TRADES SHALL BE THE RESPONSIBILITY OF THE CONTRACTOR.

1.5 WARRANTY

.1 MANUFACTURER SHALL FURNISH A SINGLE, WRITTEN WARRANTY COVERING BOTH MATERIAL AND WORKMANSHIP FOR A PERIOD OF ONE (1) YEAR FROM DATE OF INSTALLATION.

PART 2 - PRODUCTS

2.0 COLOURS

.1 COLOURS AS SELECTED BY CONTRACT ADMINISTRATOR FROM MANUFACTURER'S STANDARD COLOURS.

2.1 JOINT SEALANT MATERIALS $1 \setminus 1$.1 TYPE PRODUCED BY MANUFACTURER OF RESINOUS FLOORING SYSTEM FOR TYPE OF SERVICE AND JOINT CONDITION INDICATED.

PART 3 - EXECUTION

3.0 PREPARATION

REPAIR SURFACE GRIME, CRACKS AND SURFACE DEFECTS PRIOR TO INSTALLATION. CONCRETE PREPARATION SHALL BE BY MECHANICAL MEANS AND INCLUDE USE OF A SCABBLER, SCARIFIER OR SHOT BLAST MACHINE FOR REMOVAL OF BOND INHIBITING MATERIALS SUCH AS CURING COMPOUNDS OR LAITANCE.

3.1 APPLICATION

GENERAL: APPLY EACH COMPONENT OF RESINOUS FLOORING SYSTEM IN COMPLIANCE WITH MANUFACTURER'S DIRECTIONS TO PRODUCE A UNIFORM MONOLITHIC WEARING SURFACE OF THICKNESS INDICATED (1/8" MINIMUM), UNINTERRUPTED EXCEPT AT DIVIDER STRIPS, SAWN JOINTS OR OTHER TYPES OF

- JOINTS (IF ANY), INDICATED OR REQUIRED. PRIMER: MIX AND APPLY PRIMER OVER PROPERLY PREPARED SUBSTRATE WITH STRICT ADHERENCE TO MANUFACTURER'S INSTALLATION PROCEDURES AND COVERAGE RATES. COORDINATE TIMING OF PRIMER APPLICATION WITH APPLICATION OF SELF-LEVELING TROWEL OR ROLL-ON SYSTEM TO ENSURE OPTIMUM
- ADHESION BETWEEN RESINOUS FLOORING MATERIALS AND SUBSTRATE. COATING: REMOVE ALL SURFACE GRIME AND IMPERFECTIONS BY LIGHTLY ABRADING AND VACUUMING THE FLOOR SURFACE. MIX, SQUEEGEE APPLY AND BACK ROLL COATING WITH STRICT ADHERENCE TO MANUFACTURER'S INSTALLATION PROCEDURES AND COVERAGE RATES.

3.2 FIELD QUALITY CONTROL

- THE RIGHT IS RESERVED TO INVOKE THE FOLLOWING MATERIAL TESTING PROCEDURE AT ANY TIME. AND ANY NUMBER OF TIMES DURING THE PERIOD OF FLOORING APPLICATION.
- THE CITY MAY ENGAGE THE SERVICE OF AN INDEPENDENT TESTING LABORATORY TO SAMPLE MATERIALS BEING USED ON THE JOB SITE. SAMPLES OF MATERIAL WILL BE TAKEN, IDENTIFIED AND SEALED, AND CERTIFIED IN PRESENCE OF CONTRACTOR.
- TESTING LABORATORY WILL PERFORM TESTS FOR ANY OF CHARACTERISTICS SPECIFIED. USING APPLICABLE TESTING PROCEDURES REFERENCED HEREIN, OR IF NONE REFERENCED, IN MANUFACTURER'S PRODUCT
- IF TEST RESULTS SHOW MATERIALS BEING USED DO NOT COMPLY WITH SPECIFIED REQUIREMENTS, CONTRACTOR MAY BE DIRECTED BY CONTRACT ADMINISTRATOR TO STOP WORK; REMOVE NON-COMPLYING MATERIALS. PAY FOR TESTING. REAPPLY FLOORING MATERIALS TO PROPERLY PREPARED SURFACES WHICH HAD PREVIOUSLY BEEN COATED WITH UNACCEPTABLE MATERIALS.

3.3 CURING, PROTECTION, AND CLEANING

- CURE RESINOUS FLOORING MATERIALS IN COMPLIANCE WITH MANUFACTURER'S DIRECTIONS, TAKING CARE TO PREVENT CONTAMINATION DURING STAGES OF APPLICATION AND PRIOR TO COMPLETION OF CURING
- PROCESS. CLOSE AREA OF APPLICATION FOR A MINIMUM OF 24 HOURS. PROTECT RESINOUS FLOORING MATERIALS FROM DAMAGE AND WEAR DURING CONSTRUCTION OPERATION. WHERE TEMPORARY COVERING IS REQUIRED FOR THIS PURPOSE, COMPLY WITH MANUFACTURER'S RECOMMENDATIONS FOR PROTECTIVE MATERIALS AND METHOD OF APPLICATION. CONTRACTOR IS
- RESPONSIBLE FOR PROTECTION AND CLEANING OF SURFACES AFTER FINAL COATS. CLEANING: REMOVE TEMPORARY COVERING AND CLEAN RESINOUS FLOORING JUST PRIOR TO FINAL INSPECTION. USE CLEANING MATERIALS AND PROCEDURES RECOMMENDED BY RESINOUS FLOORING MANUFACTURER.

SPECIFICATIONS:

S.S. - STAINLESS STEEL

SUBMIT SHOP DRAWINGS FOR APPROVAL

PLUMBING: STAINLESS SINKS

- 16GA S.S. T304#4 MINIMUM ALL COVED WELDED INTEGRAL INTO COUNTERTOP WELDS CLEANED AND
- POLISHEDTO BLEND WITH S.S. TOP. SEE SIZES ON DRAWING
- 3 1/2" S.S. STRAINER ASSEMBLIES C/W 1 1/2" DRAIN

STRAIGHT ARM SPOUT WITH PULL-DOWN SPRAY SPOUT FAUCET: ANCONA LE DUO KITCHEN FAUCET MODEL

STAINLESS COUNTERTOPS C/W BASE CABINET

- 16GA S.S. T304#4 TOP 4" BOXED BACK RISER
- COUNTERTOP TO HAVE MARINE EDGE FRONT & ENDS
- 18GA S.S. BASE AND INTERMEDIATE SHELVES
- INTERMEDIATE SHELVES TO BE ADJUSTABLE WITH STAINLESS PILASTER STRIPS AND CLIPS
- CABINET ENDS AND DIVIDERS TO BE 20GA S.S. T304#4 FINISH
- BACK PANEL 20GA S.S. T304#4
- REINFORCING 16GA SATINCOAT C SECTION, DOUBLE FACE TAPE TO TOP (3 REQ'D)
- 16GA SATINCOAT OR GALVANIZED SUPPORT CHANNELS FOR BASE SHELF 1 5/8" OD - 16GA S.S. ORNAMENTAL TUBULAR LEGS
- S.S. ADJ. BULLET FEET
- 16GA S.S. T304#4 REMOVABLE S.S. KICK PLATE FRONT & ENDS
- 16GA S.S. SKIRTING TO COVER FRONTS OF SINKS

STAINLESS DRAWERS

- DOUBLE PAN CONSTRUCTION FRONT 18GA S.S. T304#4
- 1" INSULATION BETWEEN PANS
- 16GA S.S. T304#4 DRAWER PAN x 8" DEEP FASTENED TO THE BACK PAN OF THE DRAWER FRONT
- STAINLESS DRAWER SLIDES x 20" LONG FULL EXTENSION WEIGHT CAPACITY 80-100 lbs
- DRAWER HOUSING 16GA S.S. T304#4
- FASTEN DRAWERS TO UNDERSIDE OF STAINLESS TOP

WALL MOUNTED SHELVES - CABINET STYLE

18GA S.S. T304#4 BODY, TOP AND SHELVES

SHELVES TO BE ADJUSTABLE C/W S.S. PILASTER STRIP AND CLIPS

ISLAND S.S. TABLE

- 14GA S.S. T304#4 TOP
- REINFORCING 16GA SATINCOAT C SECTION, DOUBLE FACE TAPE TO TOP (3 REQ'D)
- 3"x3" SQUARE S.S. T304#4 TUBULAR LEGS x 16GA WALL ORNAMENTAL FINISH
- S.S. ADJ. LEVELLERS
- 1" DIA S.S. T304#4 16GA WALL ORNAMENTAL CROSS BRACES FRONT, BACK, AND SIDES 15" DOWN

APPLIANCES **GAS RANGE**

CAPITAL 36" WIDE, 4 OPEN BURNERS WITH CENTRE 12" GRILL/ GRIDDLE BURNER MODEL: MCR364B

VENTILATION CANOPY

VENTAHOOD 48" WIDE (900 CFM)


MODEL: PRXH18-348

DISHWASHER

MODEL: D5436XLS

ASKO DISHWASHERS INC. 24" BUILT-IN - INTEGRATED HANDLE

- 1. APPROVED SUGGESTED SUPPLIER STAINLESS STEEL FABRICATOR CONTRACTOR "STAINLESS CONCEPTS INC."
- 2. APPROVED SUGGESTED SUPPLIER EPOXY FLOOR CONTRACTOR "BURR BUILDING".

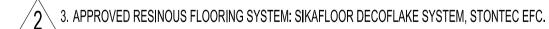

R	OOM NO.	ROOM NAME	FLOOR	BASEBOARD	NORTH WALL	SOUTH WALL	EAST WALL	WEST WALL	CEILING	DOOR	DOOR TRIM	NOTES
	102	HOSE DRYING TOWER	TYPE 1	R.BB. 1								
Ī	103	WATCH OFFICER	TYPE 2	R.BB. 2								
t	104	PLATOON COMMANDER	TYPE 2	R.BB. 2						PT-1		
	105	CORRIDOR	TYPE 2	R.BB. 2								
┕	106	DRYING ROOM	TYPE 2	R.BB. 2								
	107	REPAIRS	TYPE 1	R.BB. 1								
-	108	STORAGE	TYPE 1	R.BB. 1								
109	109	MECHANICAL ROOM	TYPE 1	R.BB. 1								
	110	CORRIDOR	TYPE 2	R.BB. 2		PT-1						PATCH & PAINT WALL BEHIND REMOVED DRINKING FOUNTA
	112	LOCKER ROOM	TYPE 2	R.BB. 2					ACT			
7	113	WASHROOM	TYPE 2	R.BB. 2						PT-1		
\parallel	114	DORMITORY	TYPE 2	R.BB. 2	PT-1	PT-1	PT-1	PT-1	ACT	PT-1	TBD	
	115	PANTRY	TYPE 2	R.BB. 2					ACT			
	117	KITCHEN	TYPE 2	R.BB. 2	PT-1	PT-1	PT-1	PT-1	ACT			
118 120 121	118	ELECTRICAL ROOM	TYPE 1	R.BB. 1								
		OFFICER'S	TYPE 2	R.BB. 2								
		WASHROOM LOBBY	TYPE 2	R.BB. 2								
			TYPE 1	R.BB. 1						PT-1		
	123	DEPUTY CHIEF								P1-1		
	124	FIRE CHIEF	TYPE 2	R.BB. 2								
	125	CORRIDOR	TYPE 2	R.BB. 2								
	126	FIRE PREVENTION OFFICER	TYPE 2	R.BB. 2								
	127	OFFICE	TYPE 2	R.BB. 2								

ROOM AND DOOR FINISH SCHEDULE

ABBREVIATIONS

TBD (TO BE DETERMINED)


TYPE 1: EXISTING FLOORING TYPE 2: NEW RESINOUS FLOORING, SEE SPECIFICATION




ACT: ACOUSTIC CEILING TILE CEILING TILE & T-BAR SYSTEM TO BE CGC RADAR ILLUSION CLIMAPLUS PERFORMANCE #2842 C/W GRID PROFILE DX. APPROVED EQUAL: CERTAINTEED SUSPENSION SYSTEM 15/16" CLASSIC STAB SYSTEM,

CERTAINTEED PERFORMA, FINE

FISSURED CUSTOMLINE FFCL-224

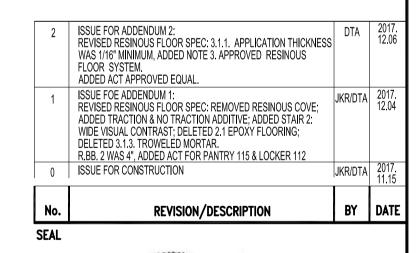

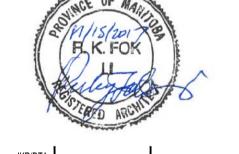

DESIGNED APPROVED CHECKED USER APPROVAL



NOTES:

PLANNING, PROPERTY AND DEVELOPMENT DEPARTMENT MUNICIPAL ACCOMMODATIONS DIVISION 3-65 GARRY STREET, R3C 4K4 PROJECT

THE CITY OF WINNIPEG

WINNIPEG FIRE PARAMEDIC SERVICES STATION No.8

SHEET TITLE

INTERIOR RENOVATIONS 640 KIMBERLY AVENUE BID OPP: 1013-2017

SPECIFICATIONS AND SCHEDULES

PROJECT No: AS SHOWN

DRAWING SHEET SIZE: A1 (841mm x 594mm) PLOT 1:1