


CONTRACTOR ACCESS

THOMAS AVENUE

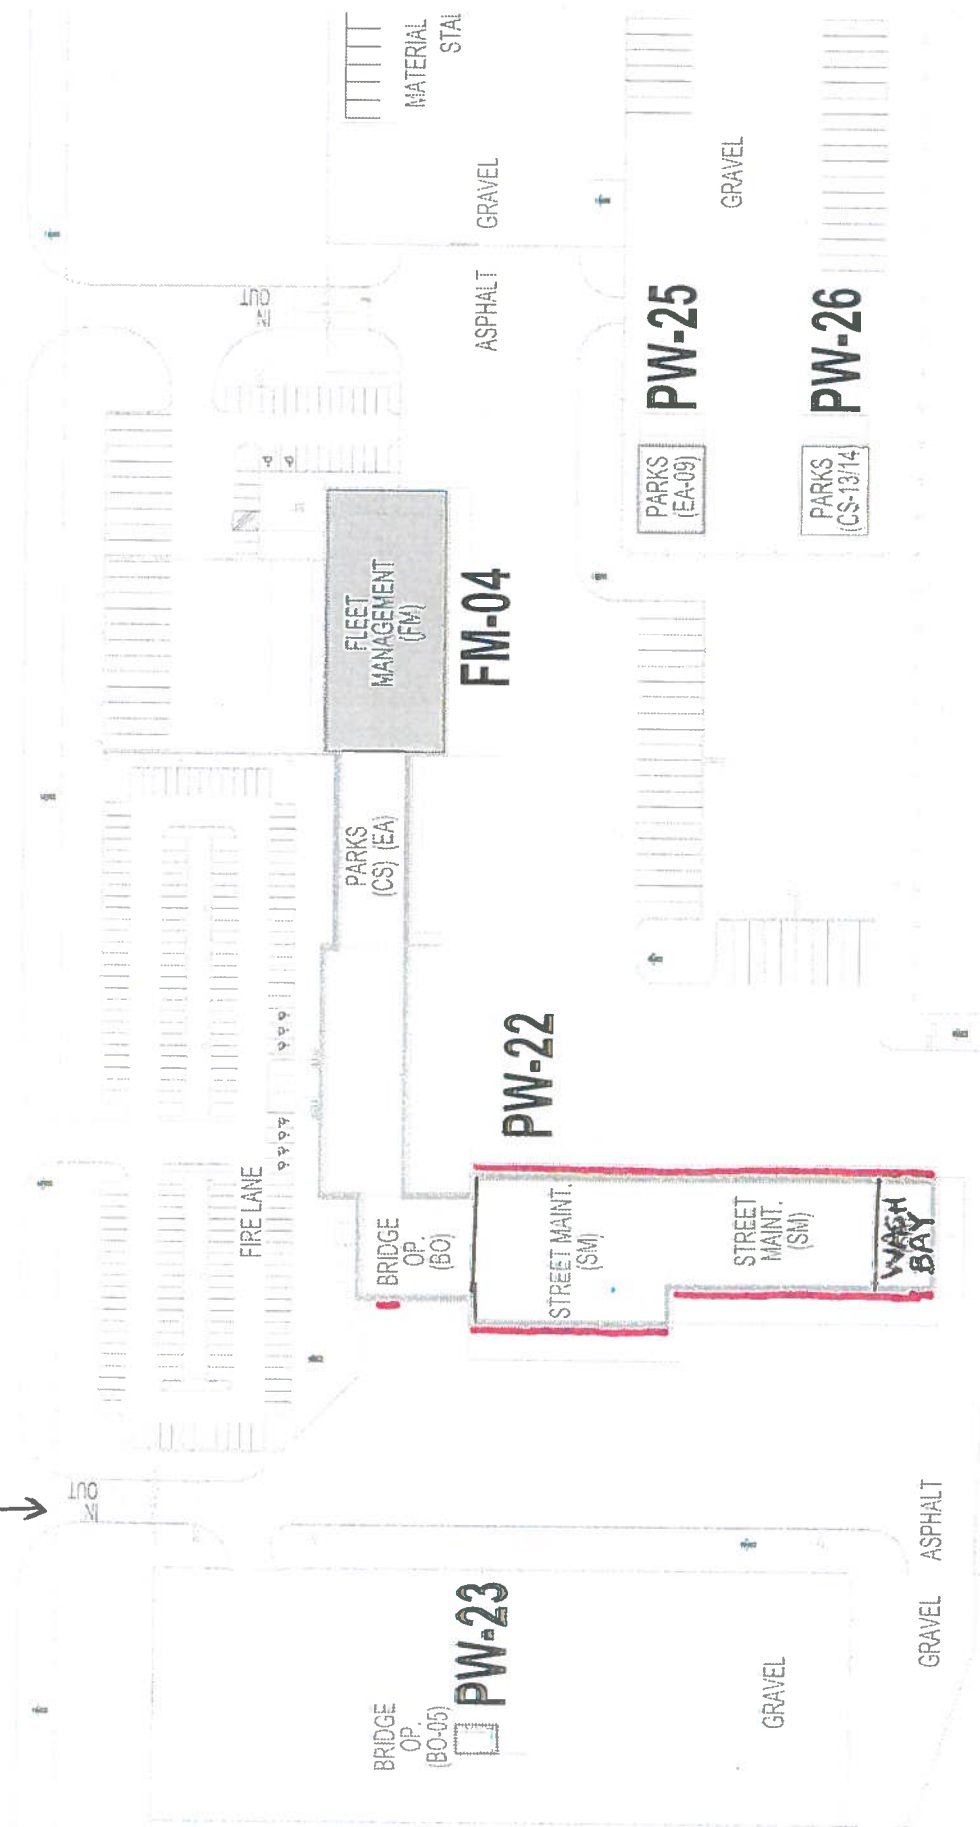

* DOORS TO BE REPLACED ARE LOCATED IN THE AREAS SHOWN IN RED

BID OPPORTUNITY # 1021-2017
EAST YARDS COMPLEX - 960 THOMAS AVENUE
DWG C1 SITE PLAN