C:\CITY OF WINNIPEG - PUBLIC WORKS - 000\010007\09.01 - PROVENCHER PEDESTRIAN BRIDGE - POST CONSTRUCTION SERVICES\CAD\STRUCT\RECORD DRAWINGS\PRO-S204.DWG 05.01.19 08:09

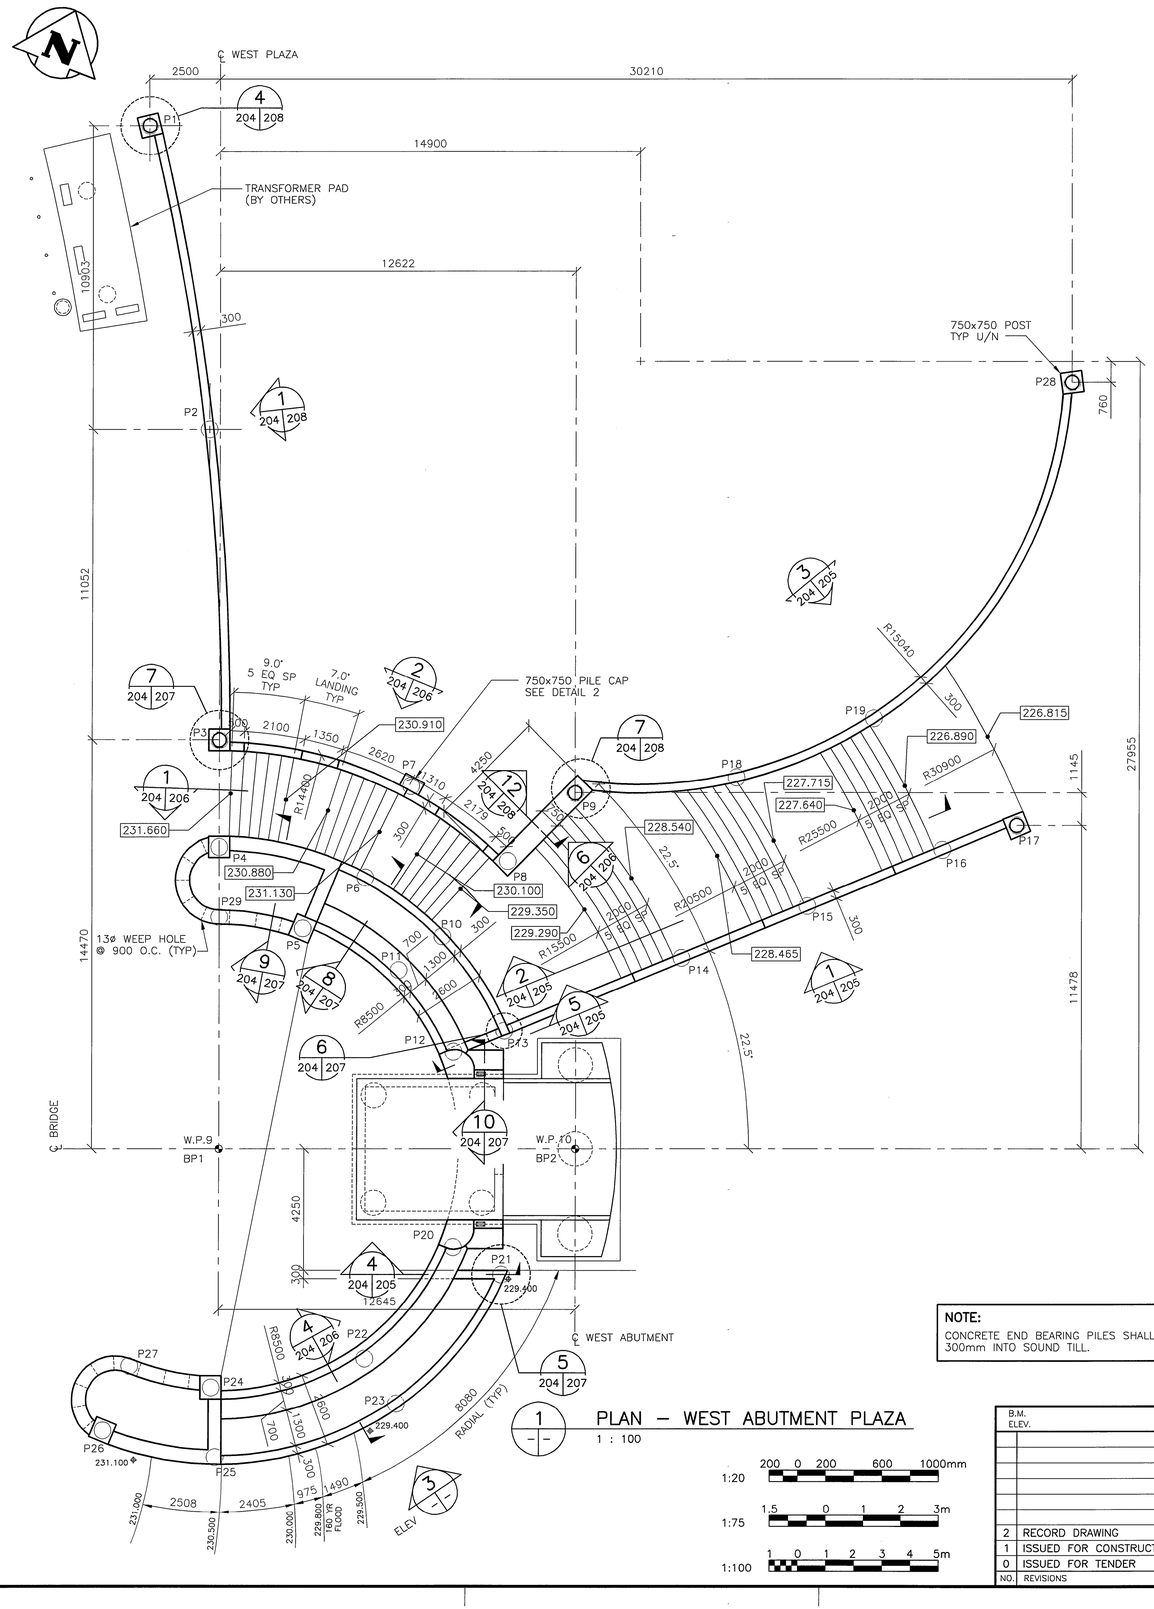

1 / – / – PLAN – WEST ABUTMENT PLAZA
1 : 100

1:20 200 0 200 600 1000mm
1:75 1.5 0 1 2 3m
1:100 1 0 1 2 3 4 5m

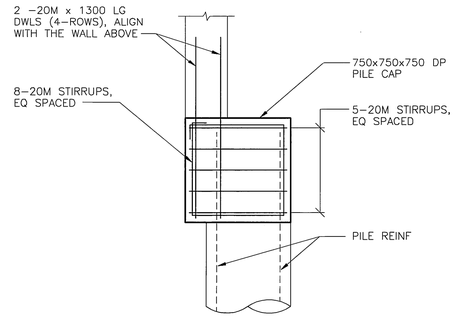

2 / – / – PILE CAP DETAIL
1 : 20

PILE LOCATIONS			
LOCATION	NORTHING	EASTING	T.O. PILE
BP1	10309.992	9652.888	–
BP2	10314.728	9664.613	–
P1	10342.837	9636.938	230.853
P2	10333.521	9642.987	230.853
P3	10323.413	9647.474	230.853
P4	10319.935	9648.878	229.100
P5	10318.383	9652.700	229.100
P6	10320.880	9654.077	229.100
P7	10324.169	9654.354	230.005
P8	10323.312	9658.548	229.100
P9	10326.424	9659.870	228.290
P10	10319.973	9657.399	229.100
P11	10318.278	9656.409	230.425
P12	10316.303	9659.308	229.100
P13	10317.669	9660.699	229.100
P14	10322.434	9665.551	228.290
P15	10325.815	9668.994	227.515
P16	10329.448	9672.694	226.690
P17	10331.224	9674.821	226.622
P18	10329.064	9664.973	227.515
P19	10332.809	9668.706	226.690
P20	10309.909	9661.888	229.100
P21	10309.667	9663.834	229.100
P22	10305.109	9660.448	230.425
P23	10304.051	9662.086	229.100
P24	10302.117	9655.782	229.100
P25	10299.891	9656.838	229.100
P26	10299.277	9652.792	229.100
P27	10301.746	9652.814	229.100
P28	10346.520	9670.726	226.510
P29	10317.645	9649.802	229.100

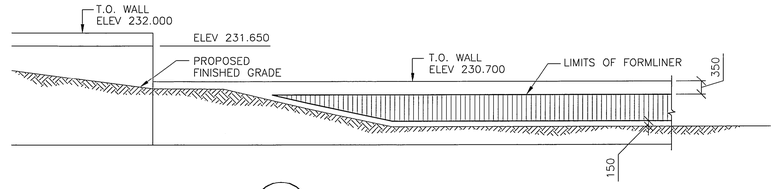

3 / – / – ELEVATION
1 : 75

NOTE:
CONCRETE END BEARING PILES SHALL TERMINATE 300mm INTO SOUND TILL.

RECORD DRAWING
DATE 05.01.20 BY G.I.
REVIEWED BY BF

APEGM
Certificate of Authorization
No. 195
Expires APRIL 30, 2003
W.R. HALDANE-WILSONE
signature
02.05.06
date

B.M. ELEV. F.B.

NO.	REVISIONS	DATE	BY
2	RECORD DRAWING	05.01.20	BF
1	ISSUED FOR CONSTRUCTION	02.07.29	R.H.W.
0	ISSUED FOR TENDER	02.05.06	R.H.W.

WARDROP | Engineering Inc.

DESIGNED BY B.F./R.H.W. | CHECKED BY R.H.W.
DRAWN BY H.P.C.C. | APPROVED BY R.vG.
HOR. SCALE: AS NOTED
VERTICAL:
DATE 02.05.06
ACCEPTED BY DATE
ORIGINAL DRAWING SIGNED BY B. EBENSPANGER (02.05.06)
B. EBENSPANGER, P.ENG.
BRIDGE DESIGN AND PROJECTS ENGINEER

ORIGINAL DRAWING REVISION "0" SEALED BY W.R. HALDANE-WILSONE 02.05.06

CONSULTANT DRAWING NO. 010007-13-01

Winnipeg
THE CITY OF WINNIPEG
PUBLIC WORKS DEPARTMENT
ENGINEERING DIVISION

PROVENCHER PAIRED BRIDGES PROJECT
PEDESTRIAN BRIDGE

CITY DRAWING NUMBER B231-02-017
SHEET OF

WEST ABUTMENT PLAZA
PLAN, PILE LAYOUT AND SCHEDULE

204