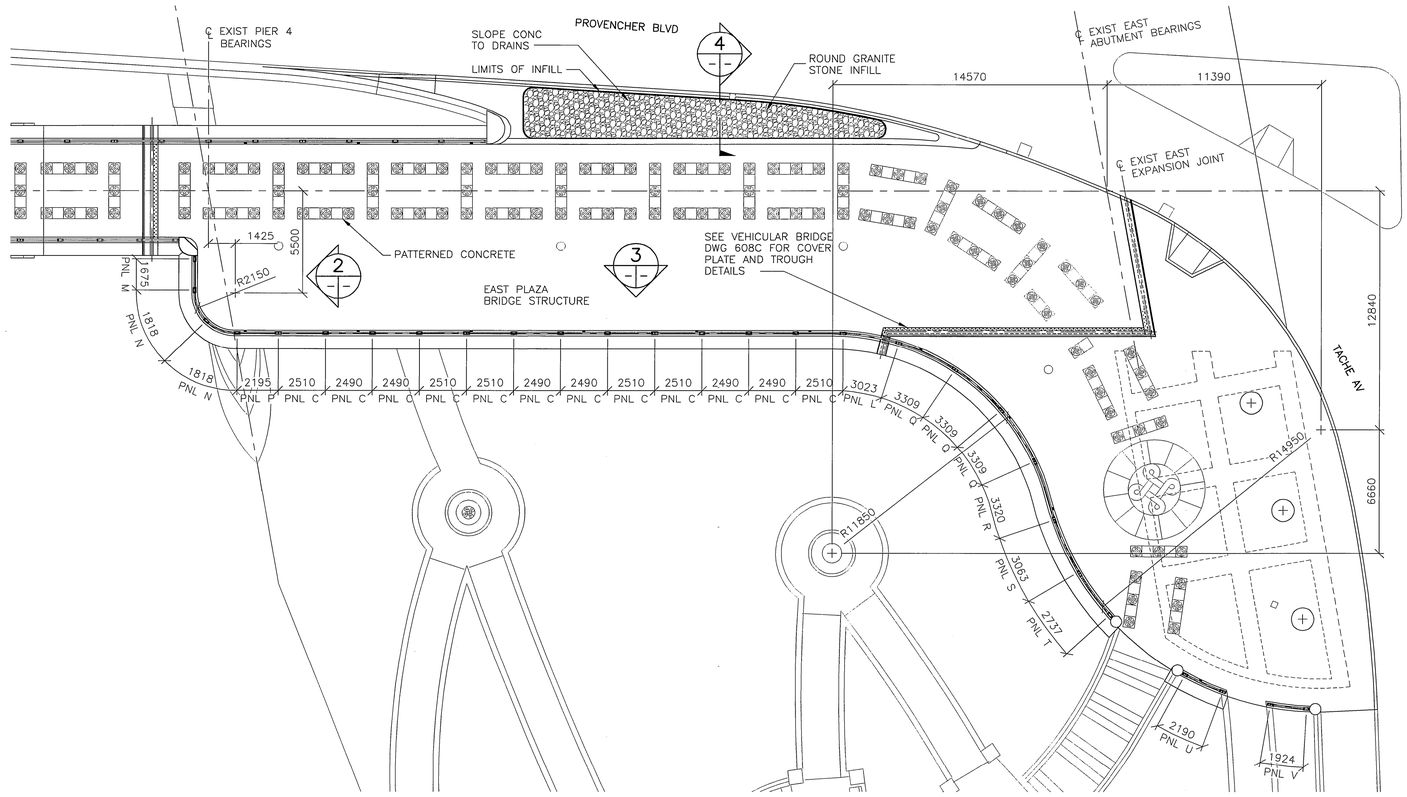

1 EAST PLAZA HANDRAIL PANEL LAYOUT
1 : 150

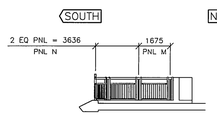

2 EAST PLAZA HANDRAIL – EAST ELEVATION
1 : 150

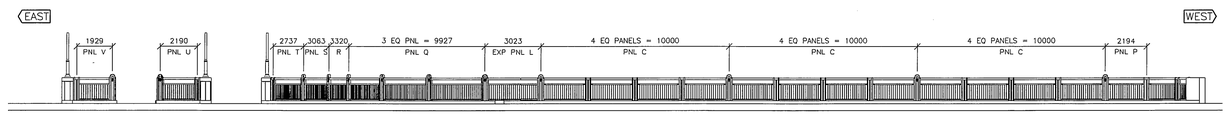

3 EAST PLAZA HANDRAIL – NORTH ELEVATION
1 : 150

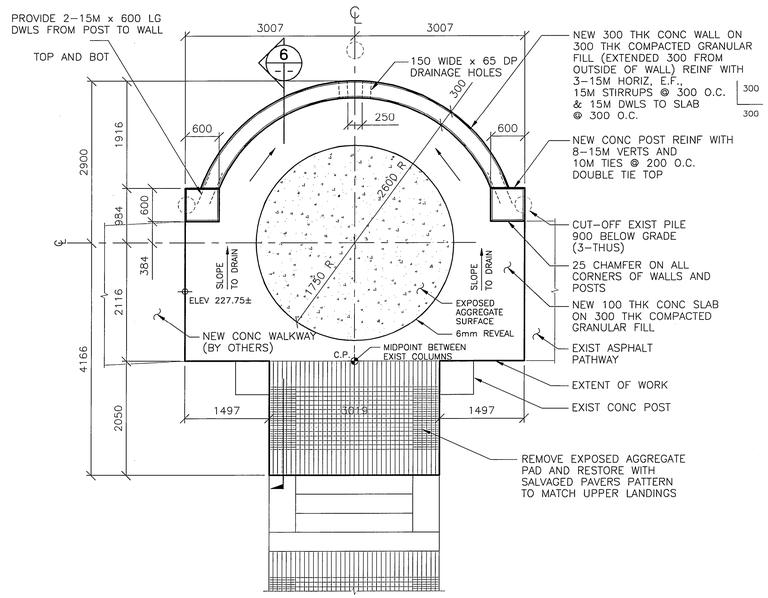

5 PARTIAL PLAN – JOSEPH ROYAL NODE RECONSTRUCTION
1 : 50

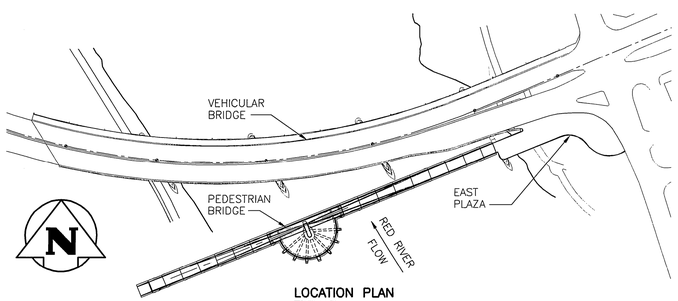

LOCATION PLAN

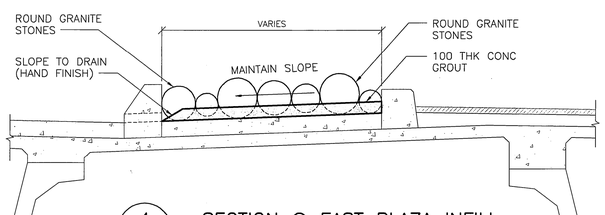

4 SECTION @ EAST PLAZA INFILL
1 : 25

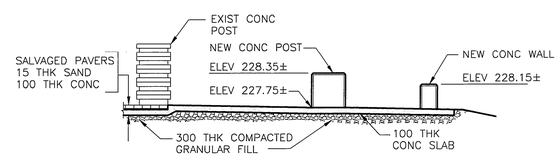

6 SECTION
1 : 50

APEGM
Certificate of Authorization
No. 195
Expires APRIL 30, 2003
W.R. HALDANE-WILSONE
signature
02.05.06
date

RECORD DRAWING
DATE 05.01.20 BY G.I.
REVIEWED BY BF

1:150 3 2 1 0 2 4 6m

NO.	REVISIONS	DATE	BY
2	RECORD DRAWING	05.01.20	BF
1	ISSUED FOR CONSTRUCTION	02.07.29	R.H.W.
0	ISSUED FOR TENDER	02.05.06	R.H.W.

B.M. ELEV. F.B.

WARDROP | Engineering Inc.

DESIGNED BY R.H.W. | CHECKED BY R.H.W.
DRAWN BY C.M.R. | APPROVED BY R.vG.
HOR. SCALE: AS NOTED
VERTICAL:
DATE 02.05.06
ACCEPTED BY DATE
ORIGINAL DRAWING SIGNED BY B. EBENSPANGER (02.05.06)
B. EBENSPANGER, P.ENG. BRIDGE DESIGN AND PROJECTS ENGINEER

ORIGINAL DRAWING REVISION "0" SEALED BY W.R. HALDANE–WILSONE 02.05.06

CONSULTANT DRAWING NO. 010007–13–01

Winnipeg

THE CITY OF WINNIPEG
PUBLIC WORKS DEPARTMENT
ENGINEERING DIVISION

PROVENCHER PAIRED BRIDGES PROJECT
PEDESTRIAN BRIDGE

CITY DRAWING NUMBER B231–02–075
SHEET OF

EAST PLAZA
ALUMINUM PEDESTRIAN HANDRAIL
PANEL LAYOUT AND ELEVATIONS

703