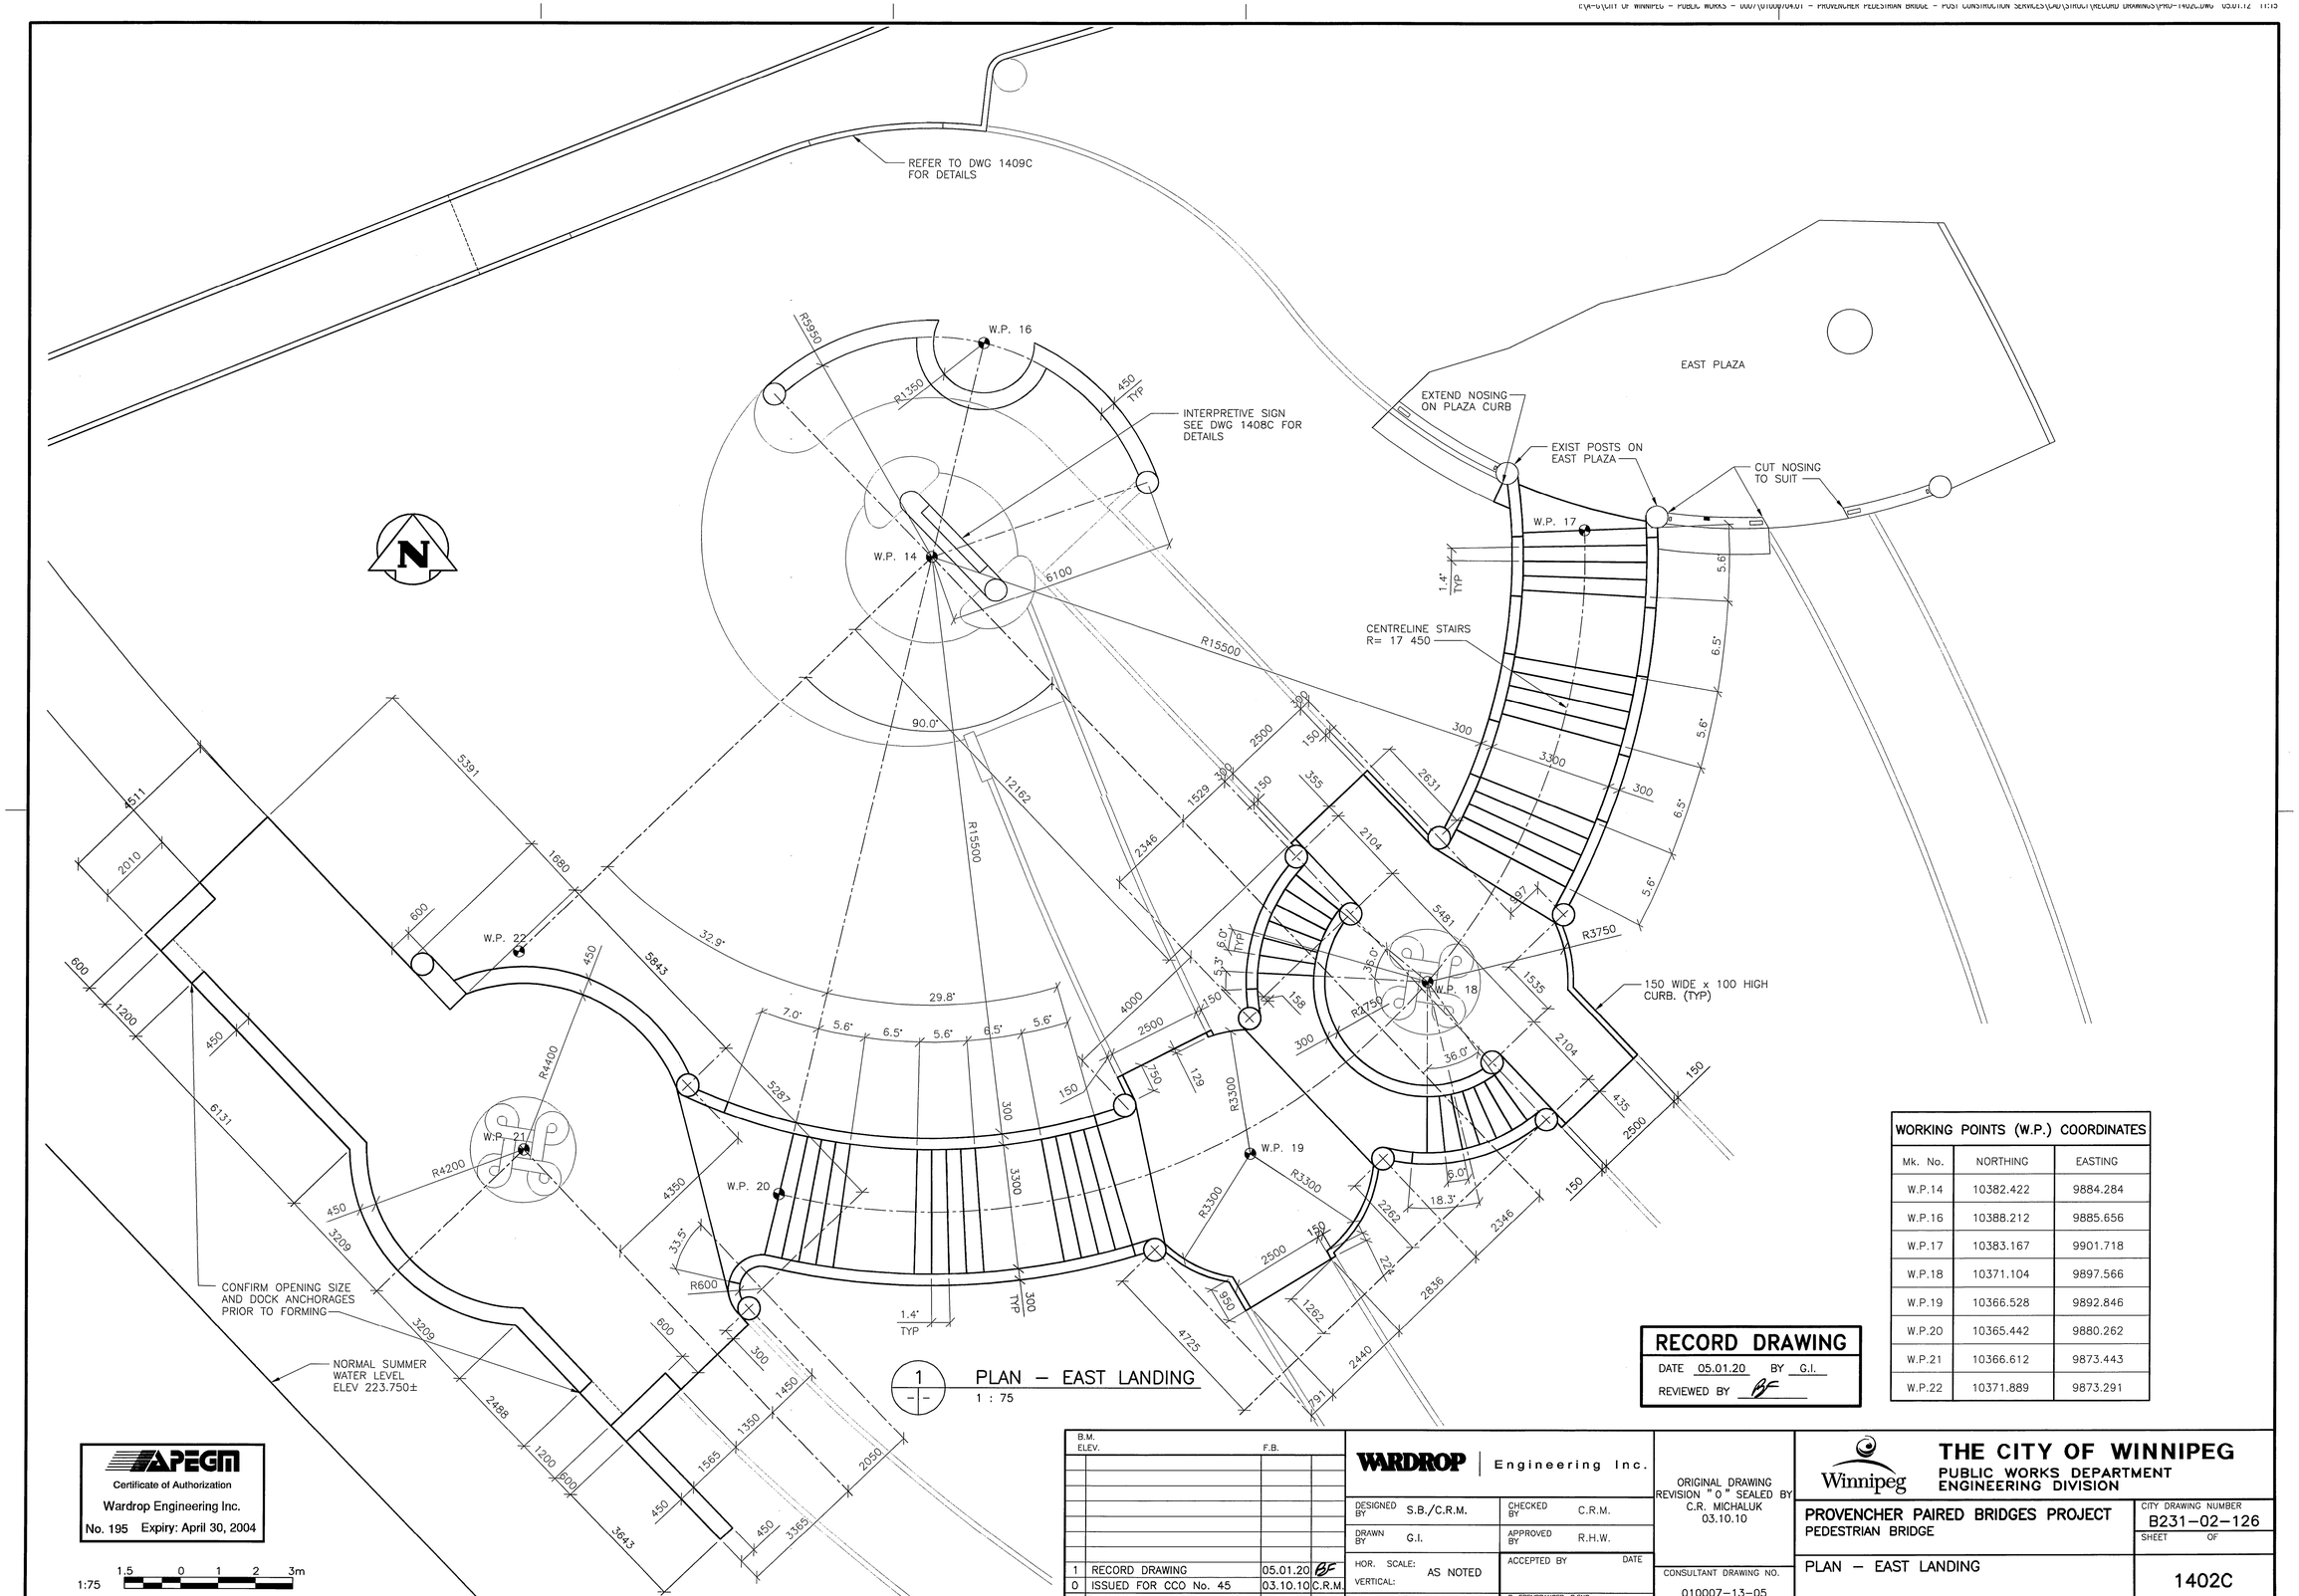

1 PLAN – EAST LANDING
1 : 75

WORKING POINTS (W.P.) COORDINATES		
Mk. No.	NORTHING	EASTING
W.P.14	10382.422	9884.284
W.P.16	10388.212	9885.656
W.P.17	10383.167	9901.718
W.P.18	10371.104	9897.566
W.P.19	10366.528	9892.846
W.P.20	10365.442	9880.262
W.P.21	10366.612	9873.443
W.P.22	10371.889	9873.291

RECORD DRAWING
DATE 05.01.20 BY G.I.
REVIEWED BY BF

APEGM
Certificate of Authorization
Wardrop Engineering Inc.
No. 195 Expiry: April 30, 2004

1:75 1.5 0 1 2 3m

NO.	REVISIONS	DATE	BY
1	RECORD DRAWING	05.01.20	BF
0	ISSUED FOR CCO No. 45	03.10.10	C.R.M.

B.M. ELEV. F.B.

WARDROP Engineering Inc.

DESIGNED BY S.B./C.R.M. CHECKED BY C.R.M.
DRAWN BY G.I. APPROVED BY R.H.W.
HOR. SCALE: AS NOTED VERTICAL:
DATE 03.10.10 ACCEPTED BY DATE
B. EBENSPANGER, P.ENG. BRIDGE DESIGN AND PROJECTS ENGINEER

ORIGINAL DRAWING REVISION "0" SEALED BY C.R. MICHALUK 03.10.10

CONSULTANT DRAWING NO. 010007-13-05

Winnipeg
THE CITY OF WINNIPEG
PUBLIC WORKS DEPARTMENT
ENGINEERING DIVISION

PROVENCHER PAIRED BRIDGES PROJECT
PEDESTRIAN BRIDGE

CITY DRAWING NUMBER B231-02-126
SHEET OF

PLAN – EAST LANDING

1402C