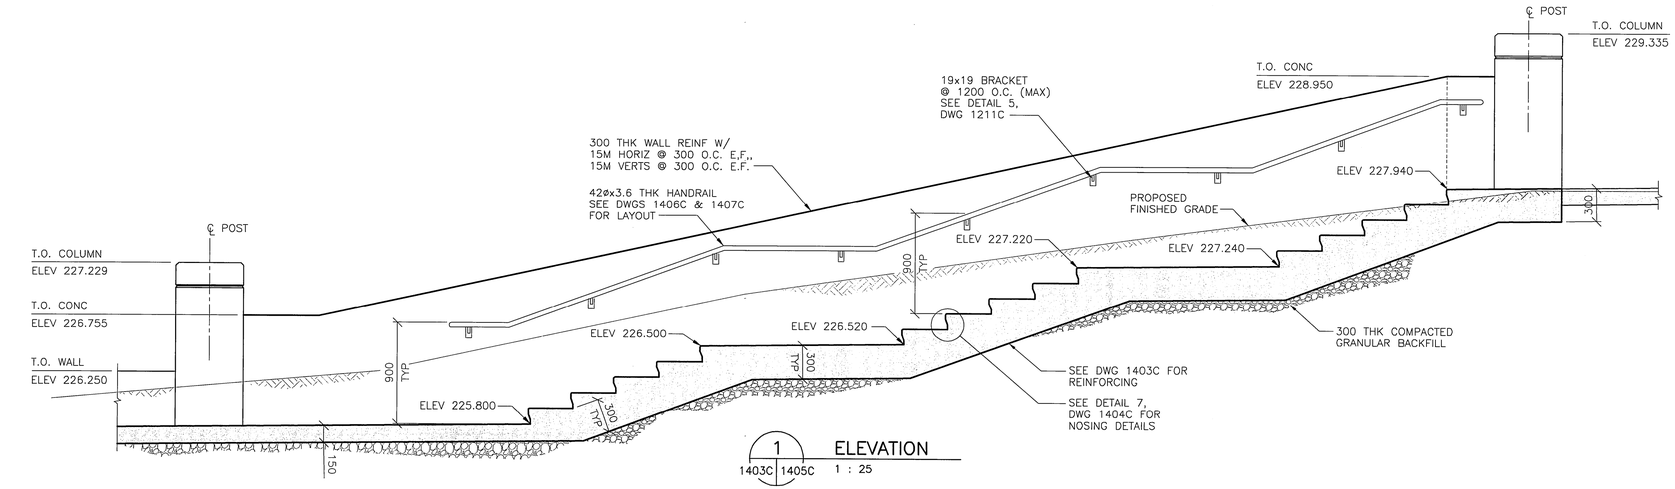

1 ELEVATION
1403C | 1405C 1 : 25

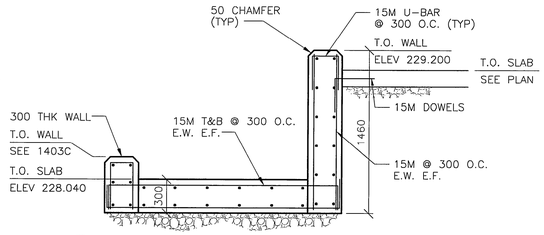

4 SECTION – BALCONY STAIRS
1403C | 1405C 1 : 25
– SEE DWG 1411 FOR FORMLINER DETAILS

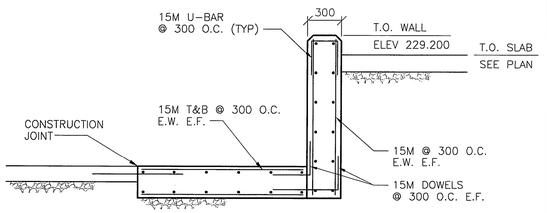

5 SECTION
1403C | 1405C 1 : 25
– SEE DWG 1411 FOR FORMLINER DETAILS

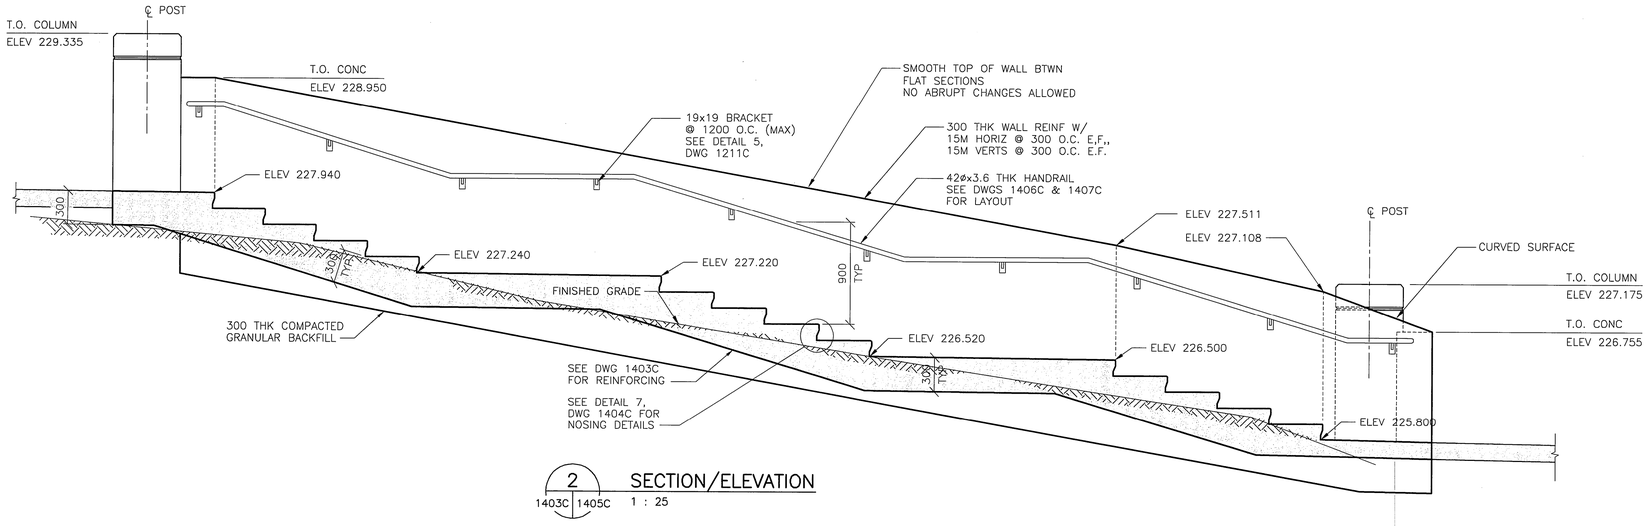

2 SECTION/ELEVATION
1403C | 1405C 1 : 25

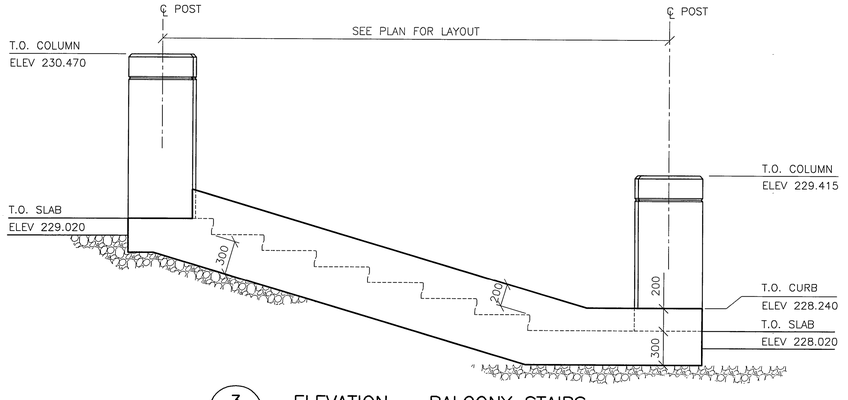

3 ELEVATION – BALCONY STAIRS
1403C | 1405C 1 : 25
– SEE DWG 1411 FOR FORMLINER DETAILS

1:25 500 0 500 1000mm

APEGM
Certificate of Authorization
Wardrop Engineering Inc.
No. 195 Expiry: April 30, 2004

RECORD DRAWING
DATE 05.01.20 BY G.I.
REVIEWED BY BE

NO.	REVISIONS	DATE	BY
1	RECORD DRAWING	05.01.20	BE
0	ISSUED FOR CCO No. 45	03.10.10	C.R.M.

B.M. ELEV. F.B.

WARDROP | Engineering Inc.

DESIGNED BY S.B./C.R.M. | CHECKED BY C.R.M.
DRAWN BY G.I. | APPROVED BY R.H.W.
HOR. SCALE: AS NOTED | ACCEPTED BY DATE
VERTICAL:
DATE 03.10.10
B. EBENSPANGER, P.ENG.
BRIDGE DESIGN AND PROJECTS ENGINEER

ORIGINAL DRAWING
REVISION "0" SEALED BY
C.R. MICHALUK
03.10.10

CONSULTANT DRAWING NO.
010007-13-05

THE CITY OF WINNIPEG
PUBLIC WORKS DEPARTMENT
ENGINEERING DIVISION

PROVENCHER PAIRED BRIDGES PROJECT
PEDESTRIAN BRIDGE

CITY DRAWING NUMBER
B231-02-129
SHEET OF

EAST LANDING
ELEVATIONS, SECTIONS AND DETAILS

1405C