

KEY PLAN
NTS

The General Contractor shall check & verify all dimensions and report any errors or omissions to the designers.

No.	Date	Issue/Revision	By
1	2017-04-04	ADDENDUM #4	CMR
0	2017-03-03	ISSUED FOR CONSTRUCTION	CMR



Consultant

300-275 Carlton Street
Winnipeg, Manitoba R3C 5R6
T 204-943-7501
F 204-943-7507




Crosier Kilgour & Partners Ltd.
CONSULTING STRUCTURAL ENGINEERS

Project
DAKOTA COMMUNITY CENTRE
BUILDING ENVELOPE UPGRADES
1188 DAKOTA STREET
WINNIPEG, MB

Sheet Title
SECOND FLOOR PLAN

File	2016-0794	Date	2017-01-26
Design	CMR	Drawn	RJM

Revision	Sheet No.
1	S2.1

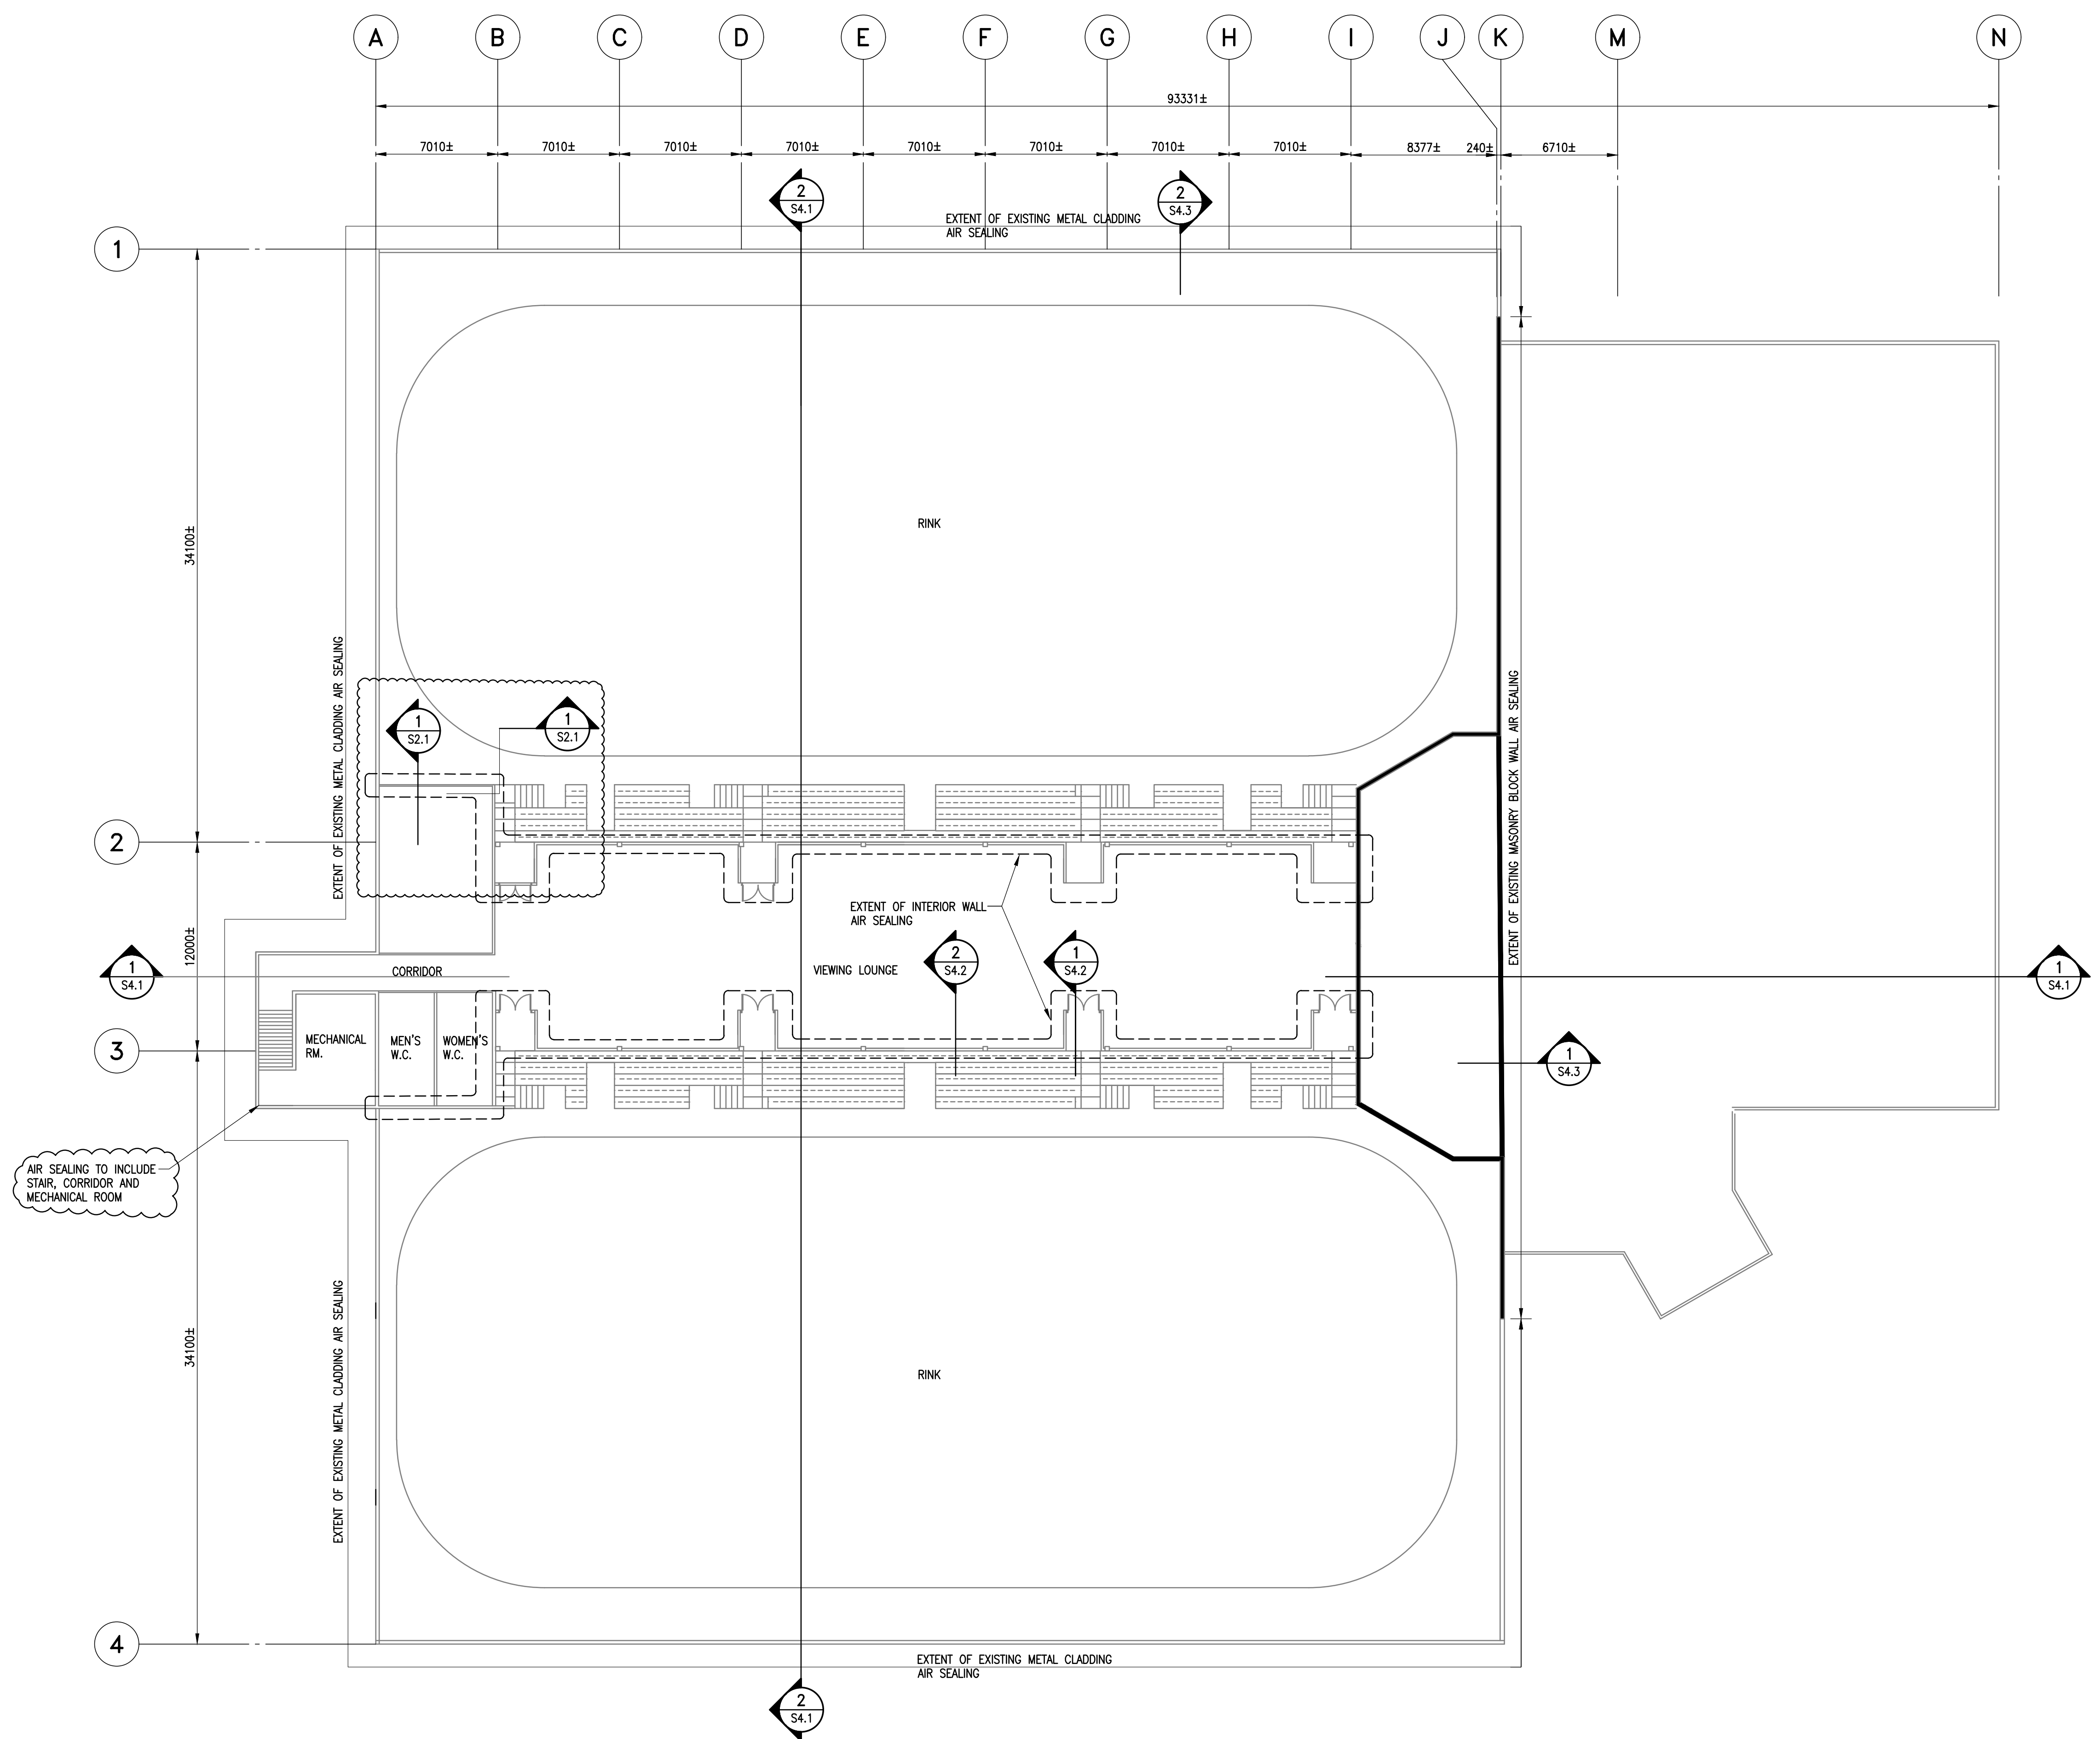

UPPER FLOOR PLAN
1 : 200

- NOTE:
- MAXIMUM FLOOR LIVE LOAD = 4.8 kN/m² (100 psf)
 - EXISTING ELEVATOR MAXIMUM CAPACITY = 2,500 #/s.

